



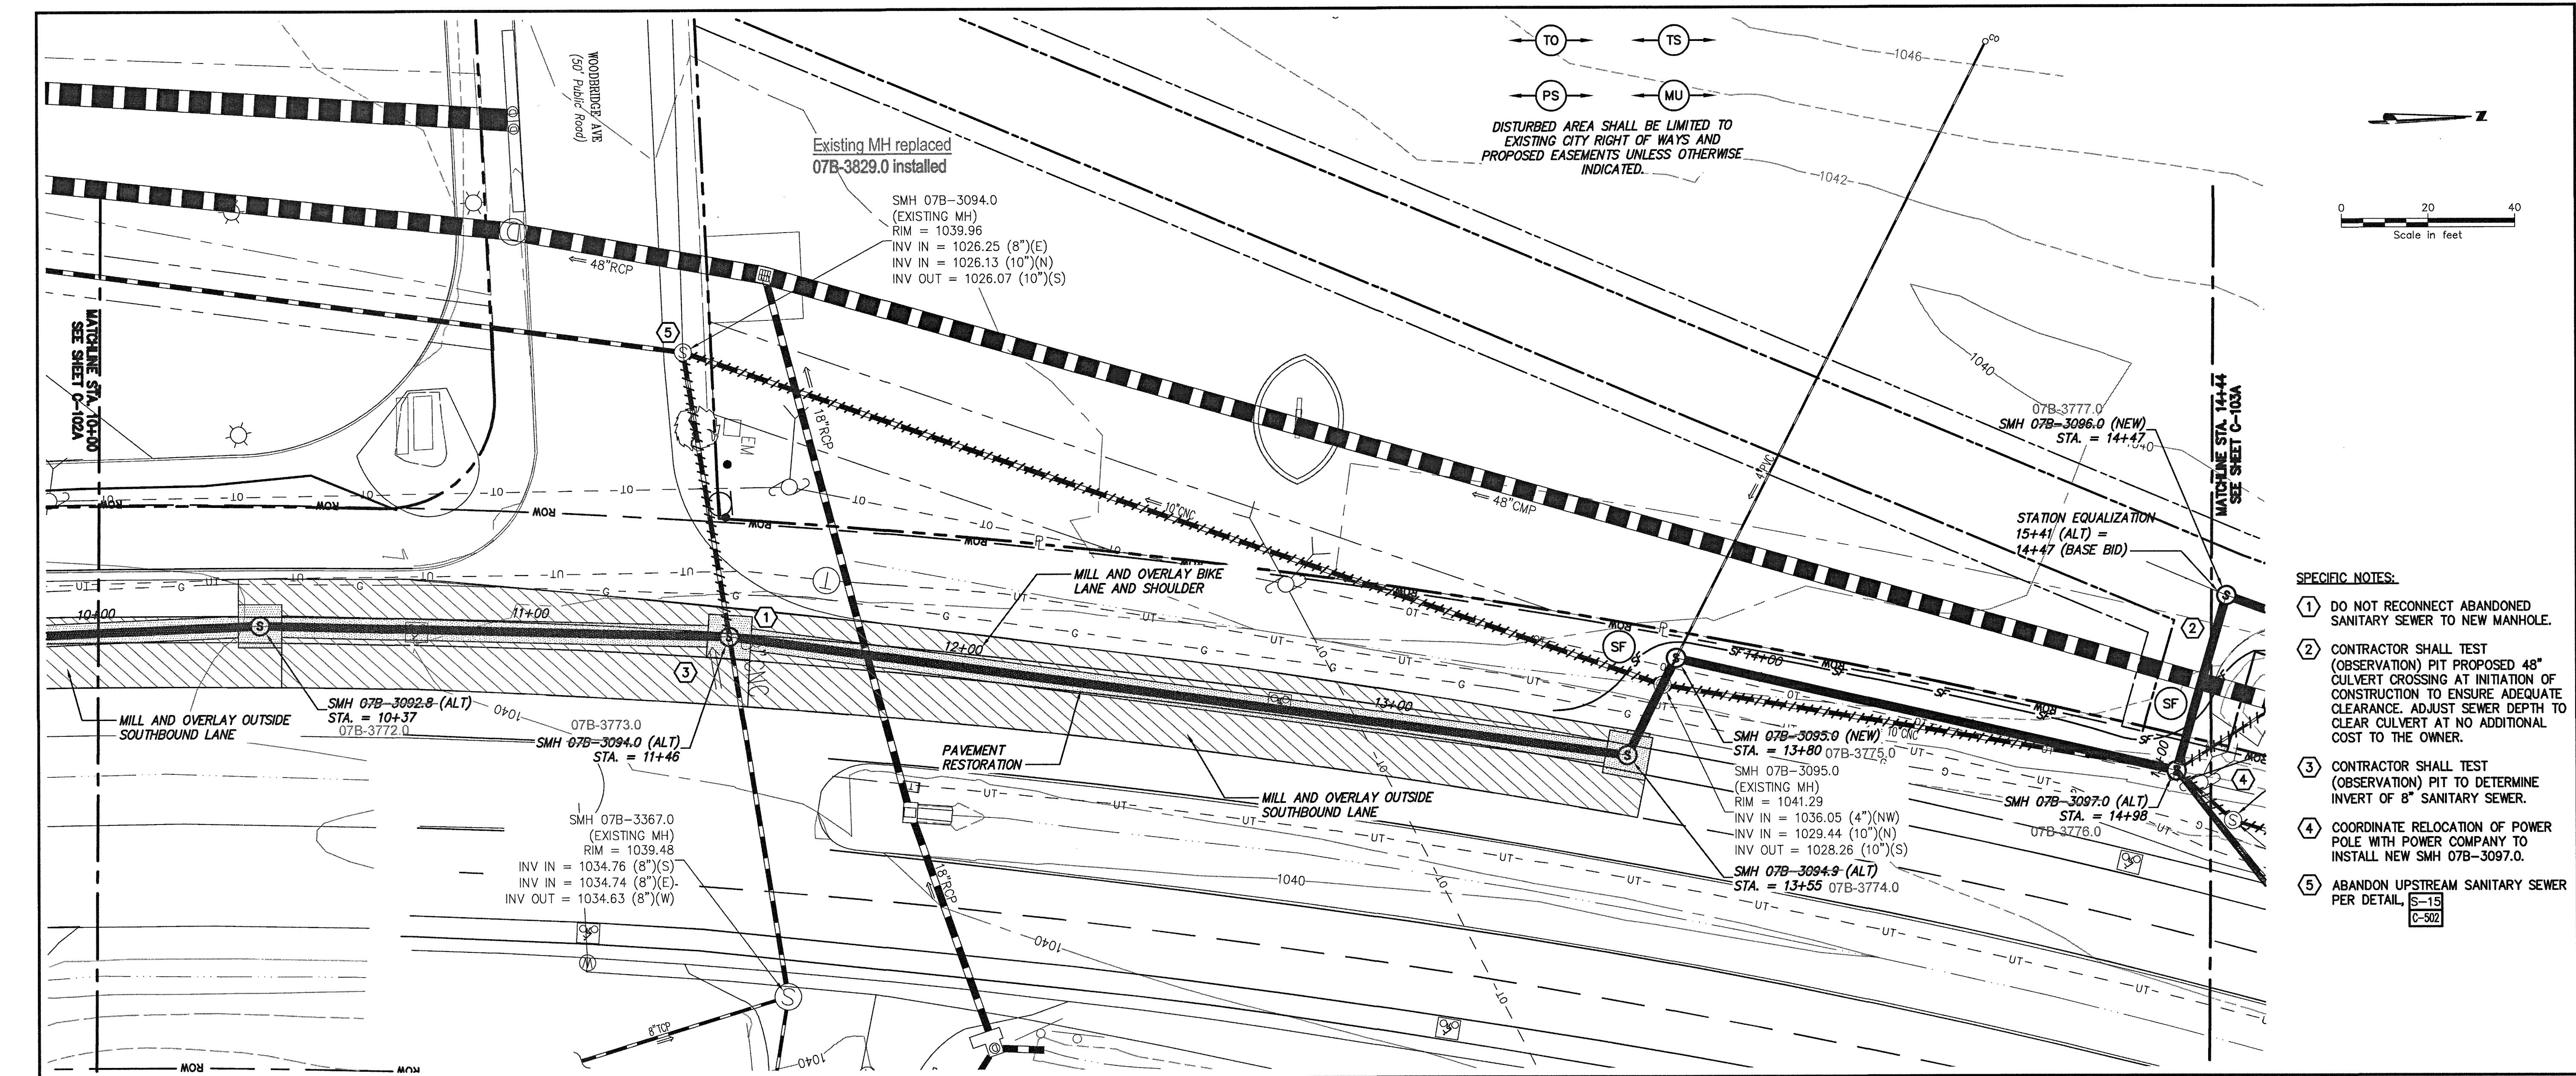

SPECIFIC NOTES:

- DO NOT RECONNECT ABANDONED SANITARY SEWER TO NEW MANHOLE.
- CONTRACTOR SHALL TEST (OBSERVATION) PIT PROPOSED 48\"/>

File: V:\PROJECTS\BVA\31237\CADD\ACAD\C4-C102-C103_31237_AL1.DWG
 Saved: 11/14/2018 3:29:00 PM Plotted: 11/14/2018 3:32:08 PM Current User: Squires, Alan LastSavedBy: 5548

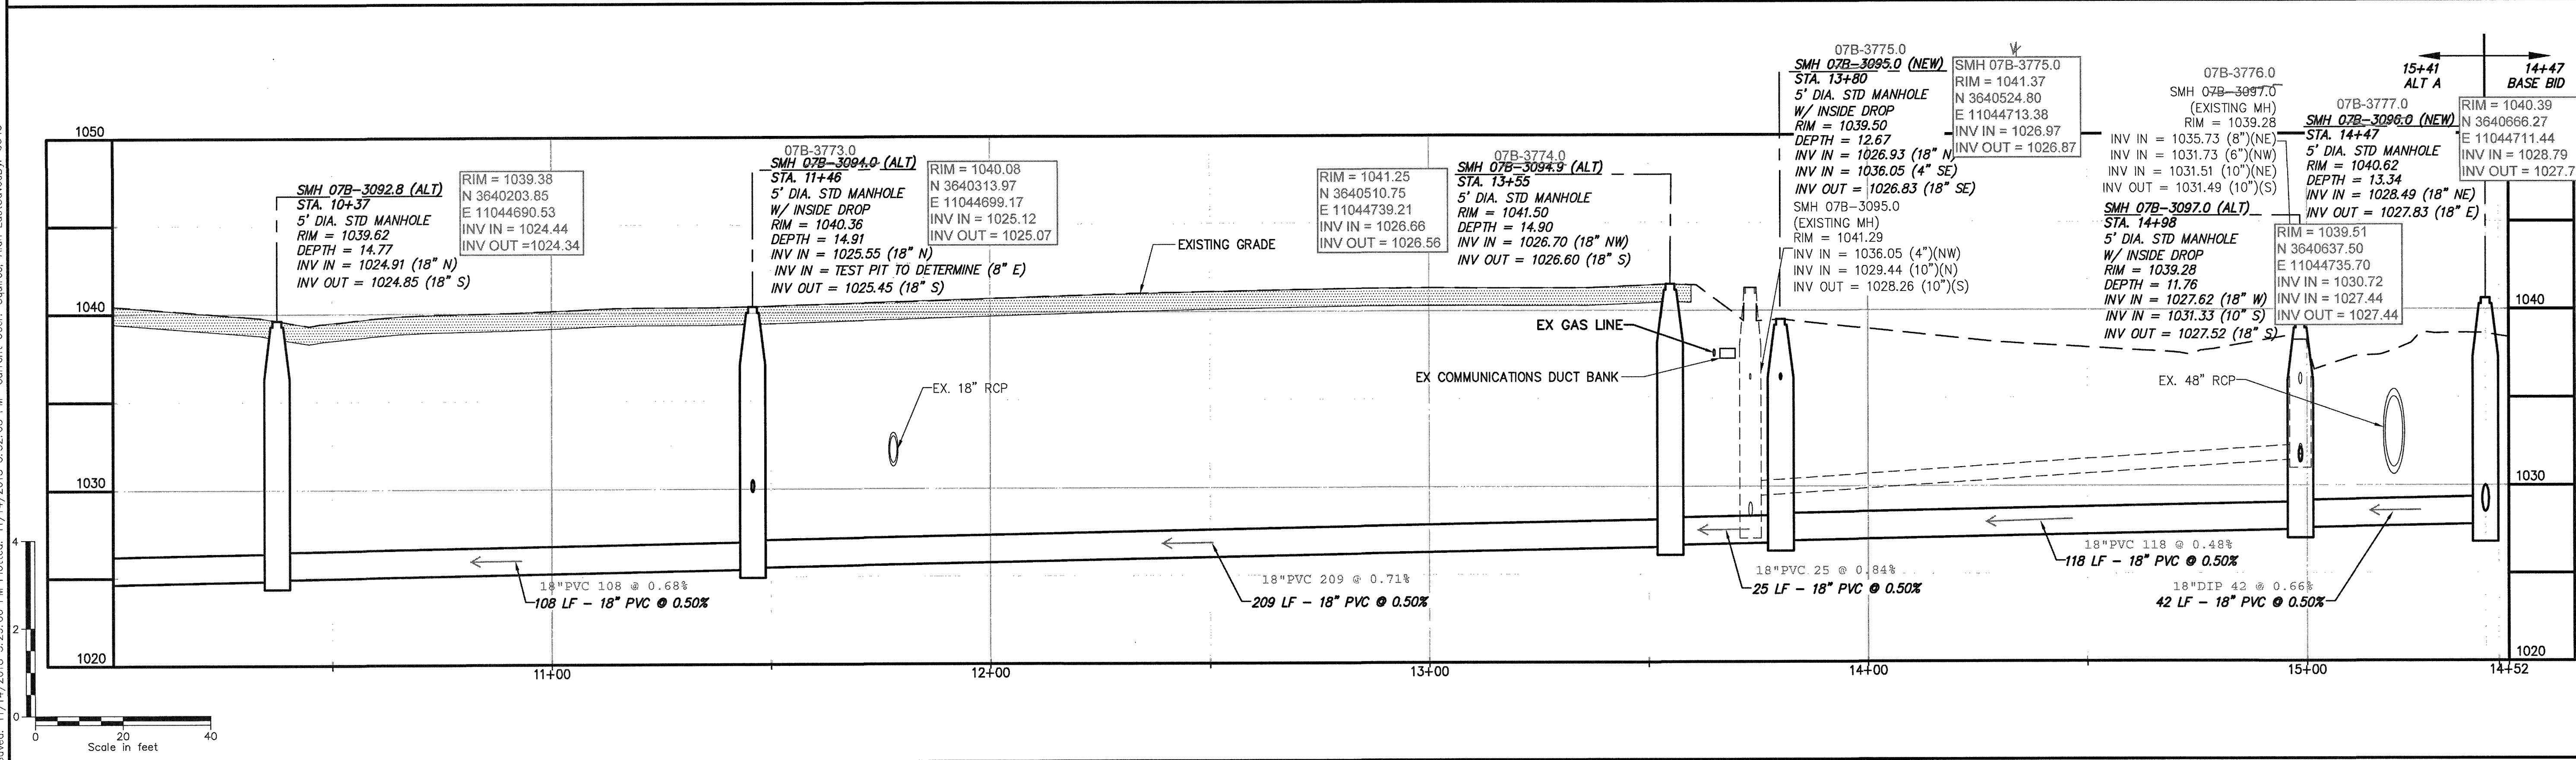

No.	Submittal / Revision	App'd. By	Date
1	ADDENDUM 2	DBH	06/27/18
2	CONSTRUCTION ISSUE	DBH	10/30/18

PETERS CREEK ROAD - PLAN & PROFILE ALTERNATE A ALIGNMENT

Designed By:	Drawn By:	Checked By:
SCF	RAS	DBH
Issue Date:	Project No:	Scale:
03-01-18	31237	AS SHOWN