

ROANOKE COUNTY
SANITATION AUTHORITY
ROANOKE COUNTY, VIRGINIA


AUTHORITY	MEMBERS
M.C. TOWNSEND	CHAIRMAN
G.D. WHITLOW	VICE-CHAIRMAN
J.B. SEIBEL	
J.C. THOMAS	
P.R. THOMSON	
J.A. BEAVERS	EXECUTIVE DIRECTOR

ROANOKE COUNTY SANITATION AUTHORITY	ROANOKE COUNTY BOARD OF SUPERVISORS
APPROVED: <i>James A. Beavers</i> JAMES A. BEAVERS, EXECUTIVE DIRECTOR	APPROVED: <i>Paul B. Matthews</i> PAUL B. MATTHEWS, EXECUTIVE OFFICER

SANITARY SEWERAGE SYSTEM

PROJECT NO.64-6 - AS-BUILT
SERVICE AREA NO. 6

SHEET	TITLE	SHEET	TITLE
1	INDEX SHEET AND NOTES	21	PECK STREET, ST. CLAIR STREET, STA. 0+00 TO 9+22.30
2	EASEMENT TO PETERS CREEK INTERCEPTOR, STA. 0+00 TO 15+00	22	MELROSE AVENUE, NORTH SIDE, STA. 0+00 TO 15+00
3	EASEMENT TO PETERS CREEK INTERCEPTOR, STA. 15+00 TO 30+00	23	MELROSE AVENUE, EASEMENT BETWEEN GRACE STREET AND GULIFORD STREET, STA. 15+00 TO 20+33.20, STA. 0+00 TO 5+79.24
4	EASEMENT TO PETERS CREEK INTERCEPTOR, STA. 30+00 TO 45+00	24	OAK GROVE STREET, GRACE STREET, STA. 0+00 TO 3+65.19, STA. 0+00 TO 2+11.13
5	EASEMENT FROM PECK STREET TO WARD STREET, STA. 45+00 TO 48+81.40	25	BARNETT STREET, STA. 2+07.71 TO 4+25
6	WARD STREET, STA. 0+14.89 TO 4+05, STA. 5+30 TO 11+70	26	GULIFORD STREET, STA. 0+00 TO 8+00, STA. 9+50 TO 12+25
7	EASEMENTS NORTH AND SOUTH OF MORWANDA STREET, STA. 0+00 TO 6+18.71, STA. 0+00 TO 4+65	27	SURREY AVENUE, PILOT STREET, EDGLAWN STREET, STA. 0+00 TO 1+60, STA. 0+00 TO 3+00, STA. 0+00 TO 8+21.24
8	MORWANDA STREET, STA. 0+00 TO 8+31.70	28	EASEMENT FROM EDGLAWN STREET TO WOODLAWN AVENUE, STA. 0+00 TO 15+00
9	EASEMENT FROM CALDWELL STREET TO LYNCHBURG TURNPIKE, EASEMENT NORTH OF VICTORIA STREET STA. 0+00 TO 15+00	29	EASEMENT FROM EDGLAWN STREET TO WOODLAWN AVENUE, STA. 15+00 TO 24+31
10	EASEMENT NORTH OF VICTORIA STREET, STA. 15+00 TO 18+10	30	NORTH STREET, GRACE STREET, WOODLAWN AVENUE, STA. 2+25 TO 3+87.25, STA. 0+00 TO STA. 3+05.14, STA. 0+00 TO 1+70.50, EASEMENT NORTH OF WOODLAWN AVENUE, STA. 0+00 TO 1+75
11	CALDWELL STREET, STA. 0+00 TO 15+00	31	SURREY AVENUE, STA. 0+00 TO 7+47.20
12	VICTORIA STREET, STA. 0+00 TO 9+00	32	EASEMENT NORTH OF SURREY AVENUE, STA. 0+00 TO 9+38.78
13	INTERCEPTOR FROM CALDWELL STREET TO SUMMIT LANE, STA. 0+00 TO 15+85.40	33	GUN CLUB ROAD, RENFRO BOULEVARD, STA. 0+00 TO 3+97.33, STA. 0+00 TO 6+50
14	SPRINGFIELD STREET, STA. 0+00 TO 9+87.10	34	DETAIL SHEET
15	CALDWELL STREET, STA. 15+00 TO 27+30.17		
16	LOGAN STREET, WILLIS STREET, STA. 0+00 TO 2+50, STA. 0+00 TO 2+50		
17	PECK STREET, STA. 2+70 TO 8+60, STA. 10+94 TO 15+00		
18	WARD STREET SOUTH OF MELROSE AVENUE, ST. CLAIR STREET, STA. 0+00 TO 4+11.37, STA. 0+00 TO 8+64.48		
19	MELROSE AVENUE SOUTH SIDE, STA. 0+00 TO 15+00		
20	MELROSE AVENUE SOUTH SIDE, STA. 15+00 TO 23+14.93		

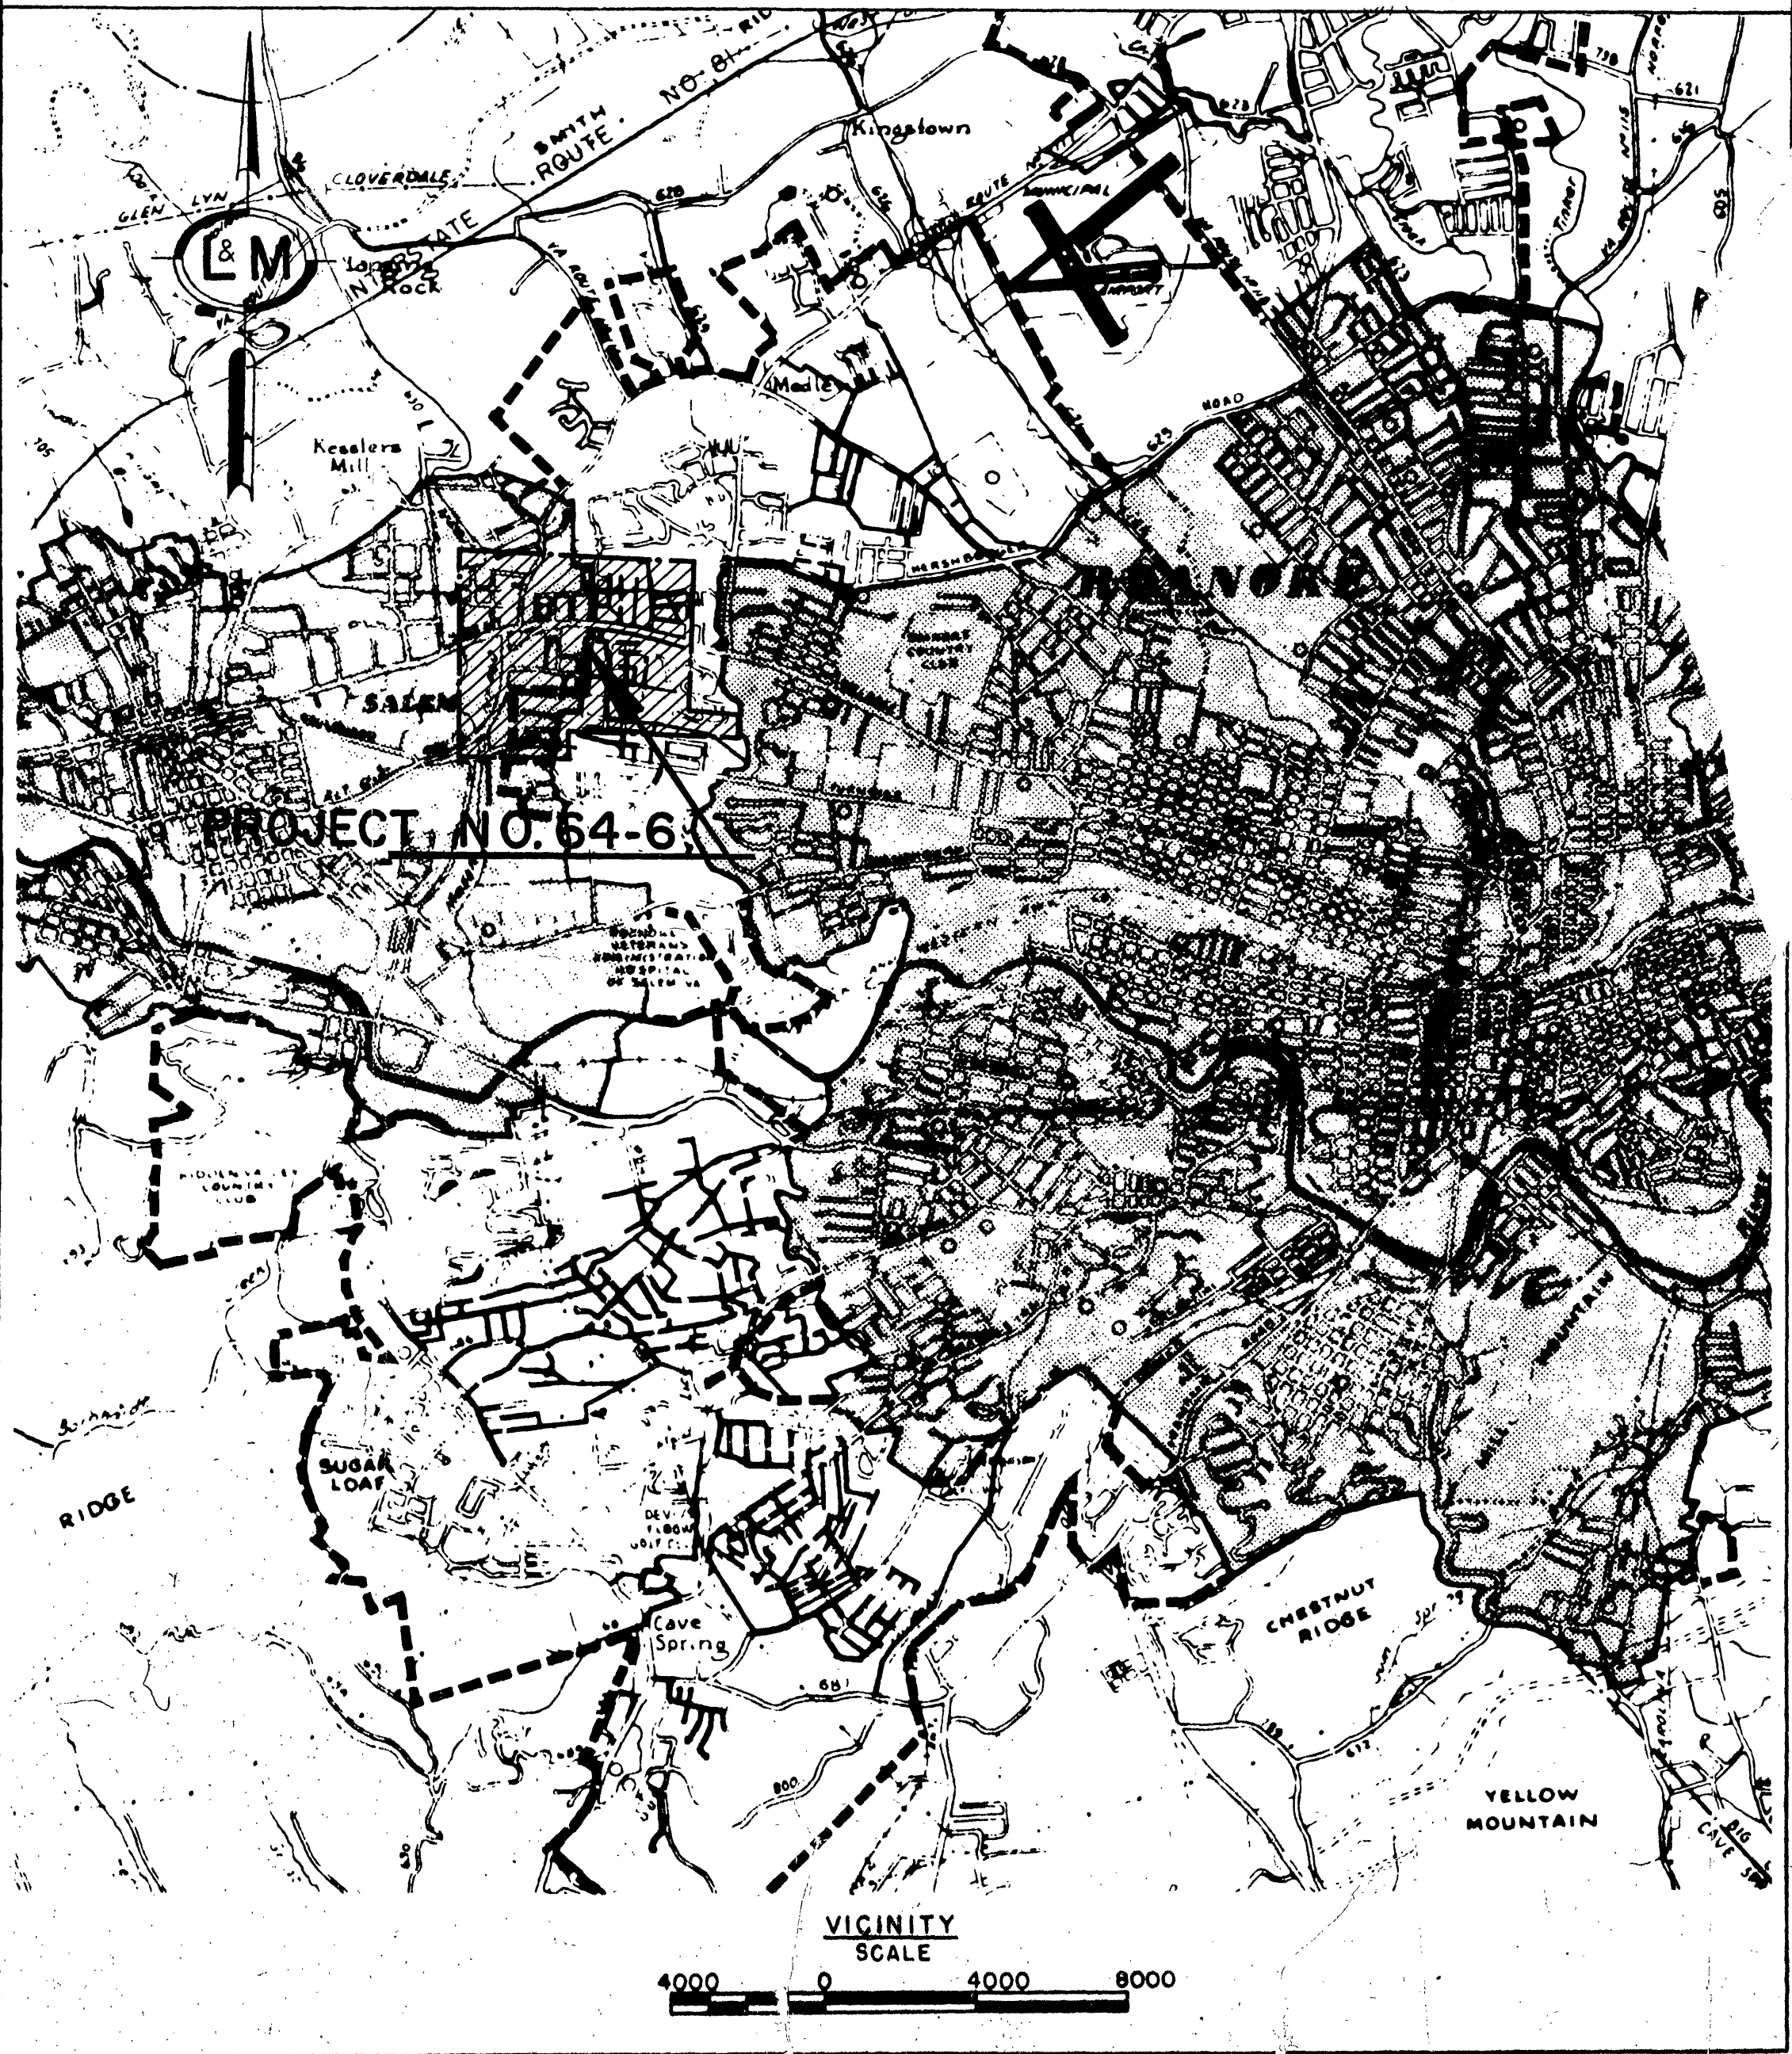

SUMMARY OF QU	
ITEM	DESCRIPTION
1 THRU 4	10" SANITARY SEWER, IN PLACE
5 THRU 11	8" SANITARY SEWER, IN PLACE
12	8"C.I.SANITARY SEWER, IN PL
13	4" SANITARY SEWER, IN P
14	STANDARD WYE BRAI FOR 8" SEWER, IN
15 THRU 20	STANDARD MANHO IN PLACE
21 THRU 25	DROP MANHO IN PLACE
26	STAN PL

- VINTON NDARIES
- R RIGHT OF WAY LINE
- MENT
- NITARY SEWER
- SANITARY SEWER
- MANHOLE
- PROPOSED MANHOLE
- PROPOSED CLEANOUT
- PROPOSED METERING STATION
- WATER MAIN
- GAS LINE
- ELECTRIC CABLE OR CONDUIT
- TELEPHONE CABLE OR CONDUIT
- RAILROAD TRACKS
- DITCH
- STREAM
- FENCE
- FIRE HYDRANT
- POWER POLE
- TELEPHONE POLE AND GUY WIRE
- VALVE VAULT
- WATER METER
- TREE
- SHRUB
- HEDGE
- ROCK OR STONE WALL
- EXISTING GROUND

LANGLEY AND McDONALD
CONSULTING ENGINEERS
NORFOLK, VIRGINIA
APPROVED: *William C. Overton*