

ROANOKE COUNTY PUBLIC SERVICE AUTHORITY

ROANOKE COUNTY,VIRGINIA

SANITARY SEWERAGE SYSTEM
PROJECT NO.68-1 -AS BUILT
DECEMBER 15,1967

AUTHORITY MEMBERS

M.C.TOWNSEND CHAIRMAN
G.D.WHITLOW VICE CHAIRMAN
J.G.SEIBEL
J.C.THOMAS
P.R.THOMSON


J.A.BEAVERS EXECUTIVE DIRECTOR

SCHEDULE OF DRAWINGS

SHEET	TITLE		STATION	
1.	PETERS CREEK	INTERCEPTOR	105+05.00	TO 115+00
2.	PETERS CREEK	INTERCEPTOR	115+00	TO 130+00
3.	PETERS CREEK	INTERCEPTOR	130+00	TO 145+00
4.	PETERS CREEK	INTERCEPTOR	145+00	TO 160+00
5.	PETERS CREEK	INTERCEPTOR	160+00	TO 168+04
6.	DETAIL	SHEET		

ROANOKE COUNTY PUBLIC SERVICE AUTHORITY
APPROVED *James A. Beavers*
JAMES A.BEAVERS,EXECUTIVE DIRECTOR

ROANOKE COUNTY BOARD OF SUPERVISORS
APPROVED *Paul B. Matthews*
PAUL B.MATTHEWS,EXECUTIVE OFFICER

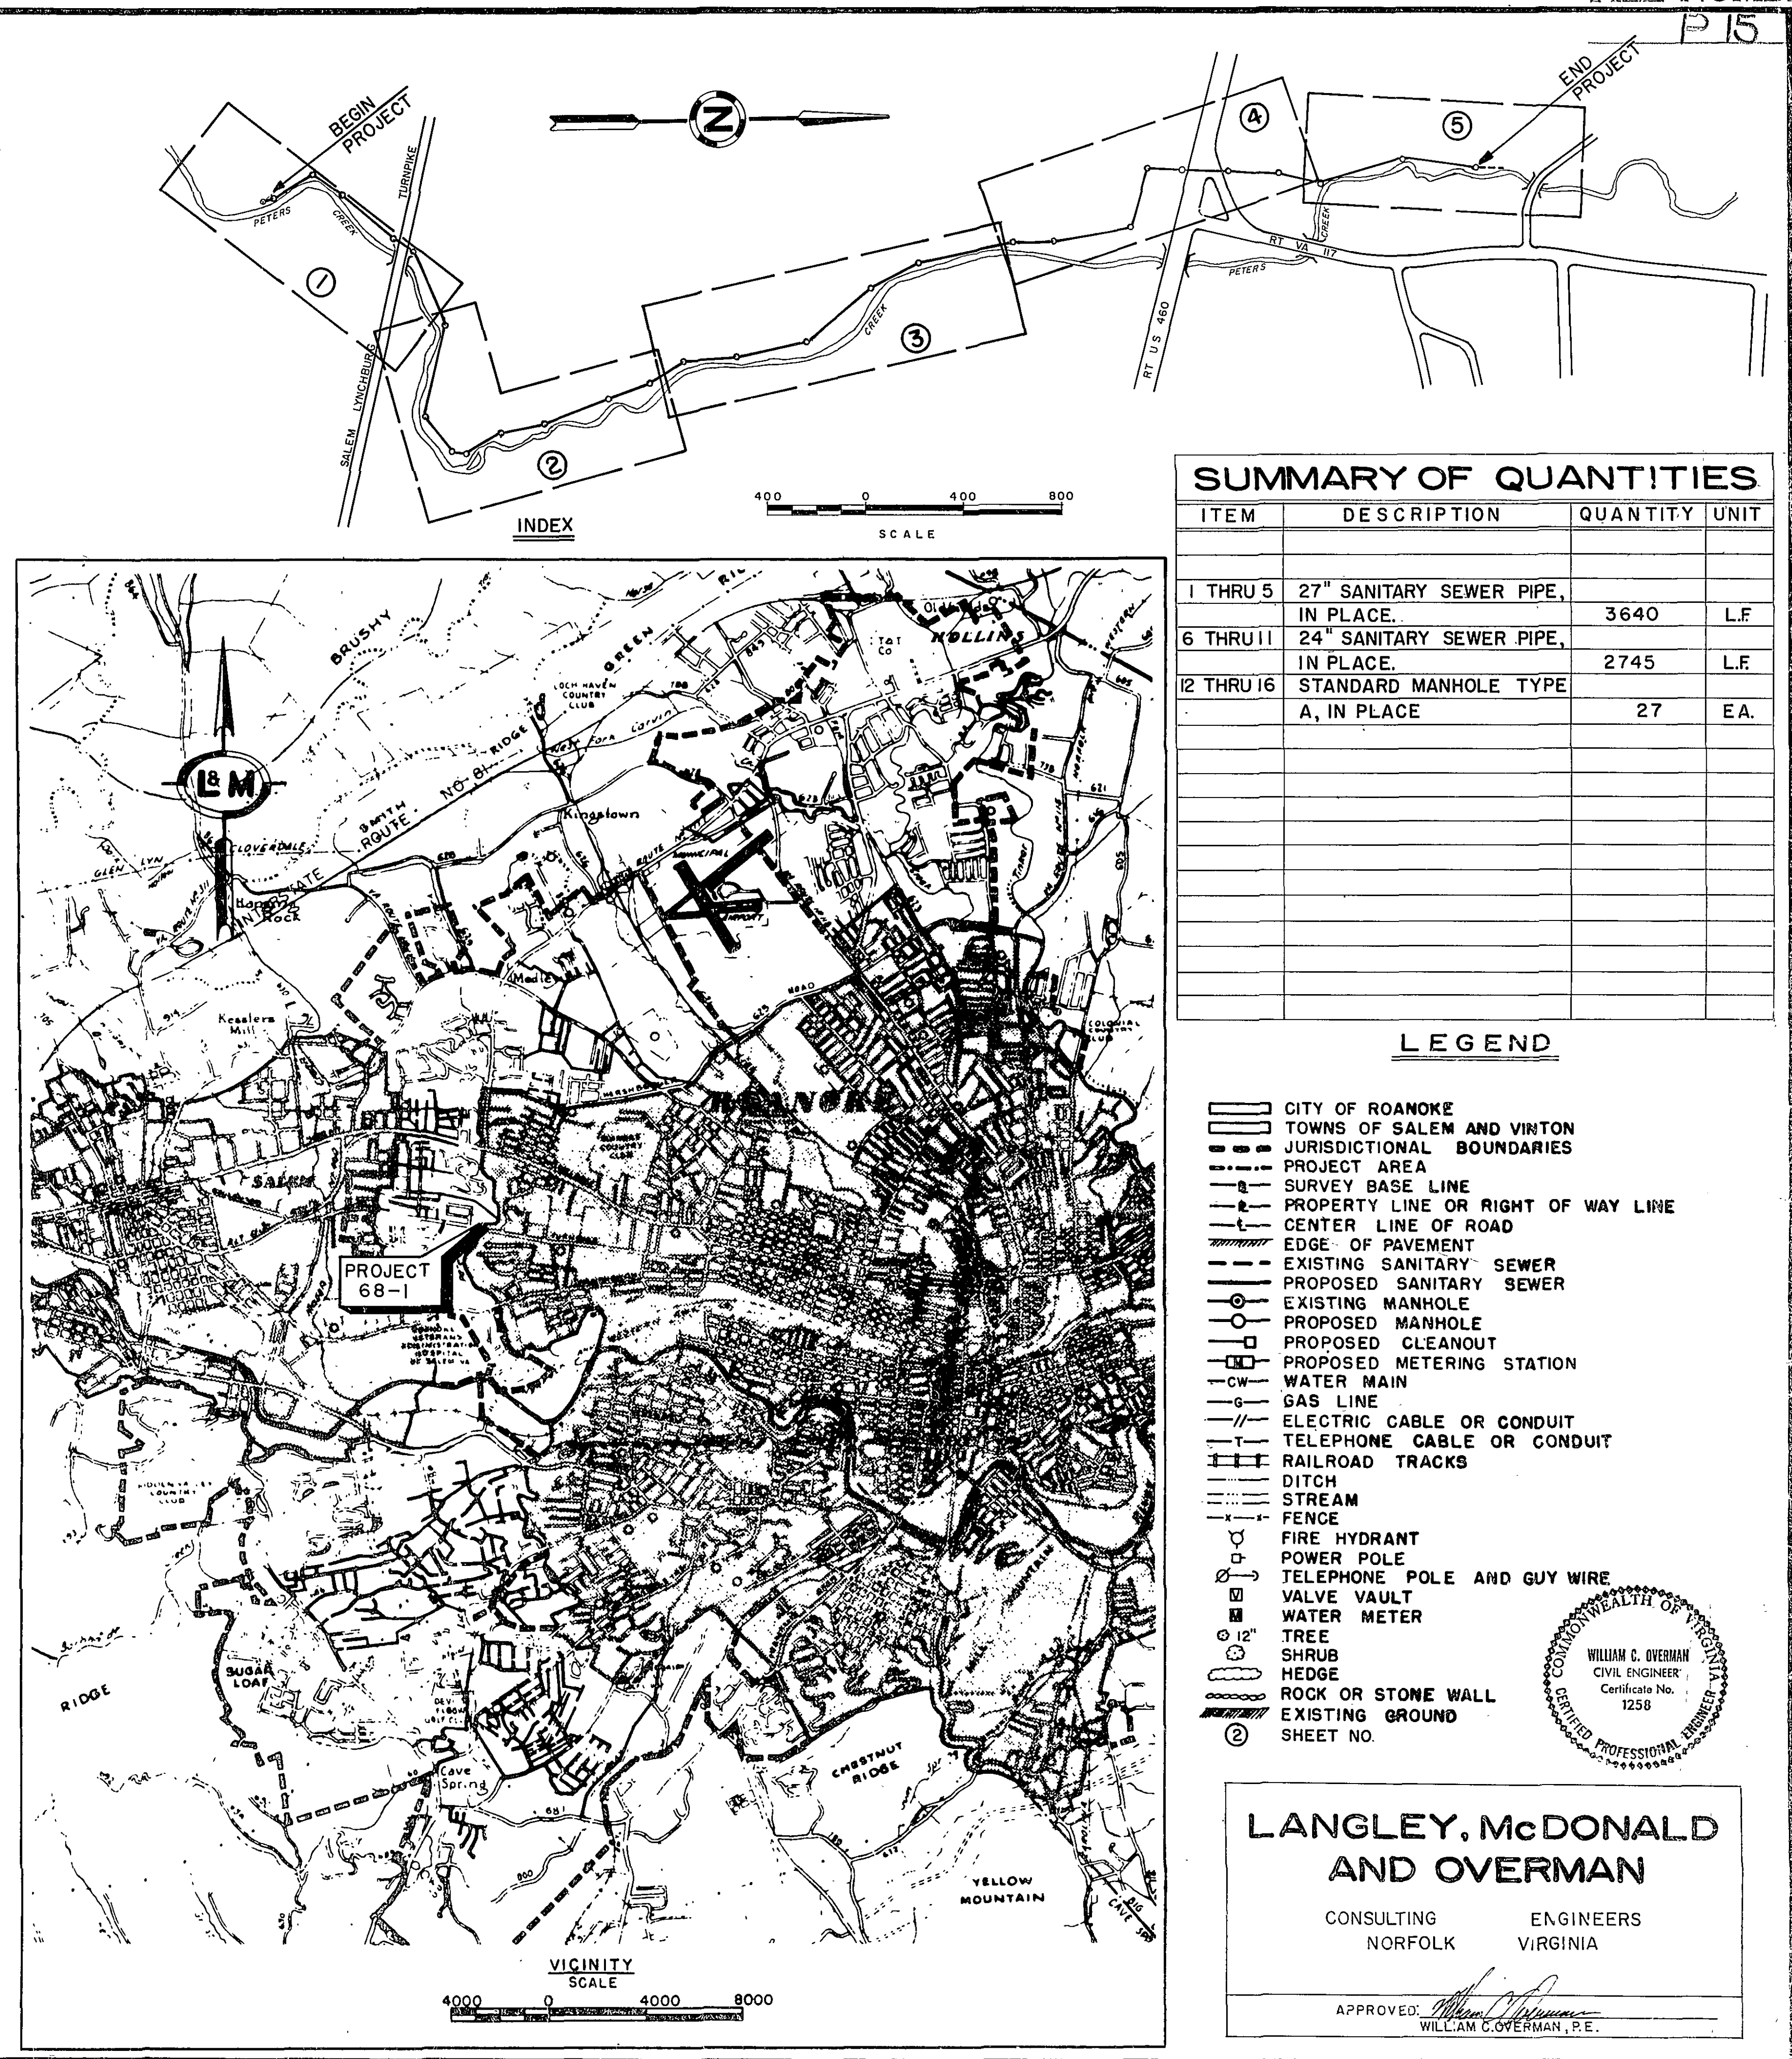

LANGLEY, McDONALD
AND OVERMAN
CONSULTING ENGINEERS
NORFOLK VIRGINIA
APPROVED: *William C. Overman*
WILLIAM C.OVERMAN, P.E.