

ROANOKE COUNTY

PUBLIC SERVICE AUTHORITY


ROANOKE COUNTY, VIRGINIA

PROJECT NO. 70-2-S

AUTHORITY MEMBERS

L. S. WALDROP		C H A I R M A N
F. R. ANGELL	V I C E	C H A I R M A N
H. F. REED		
R. H. RICHARDSON		
B. W. MAHONEY		

J.A. BEAVERS EXECUTIVE DIRECTOR

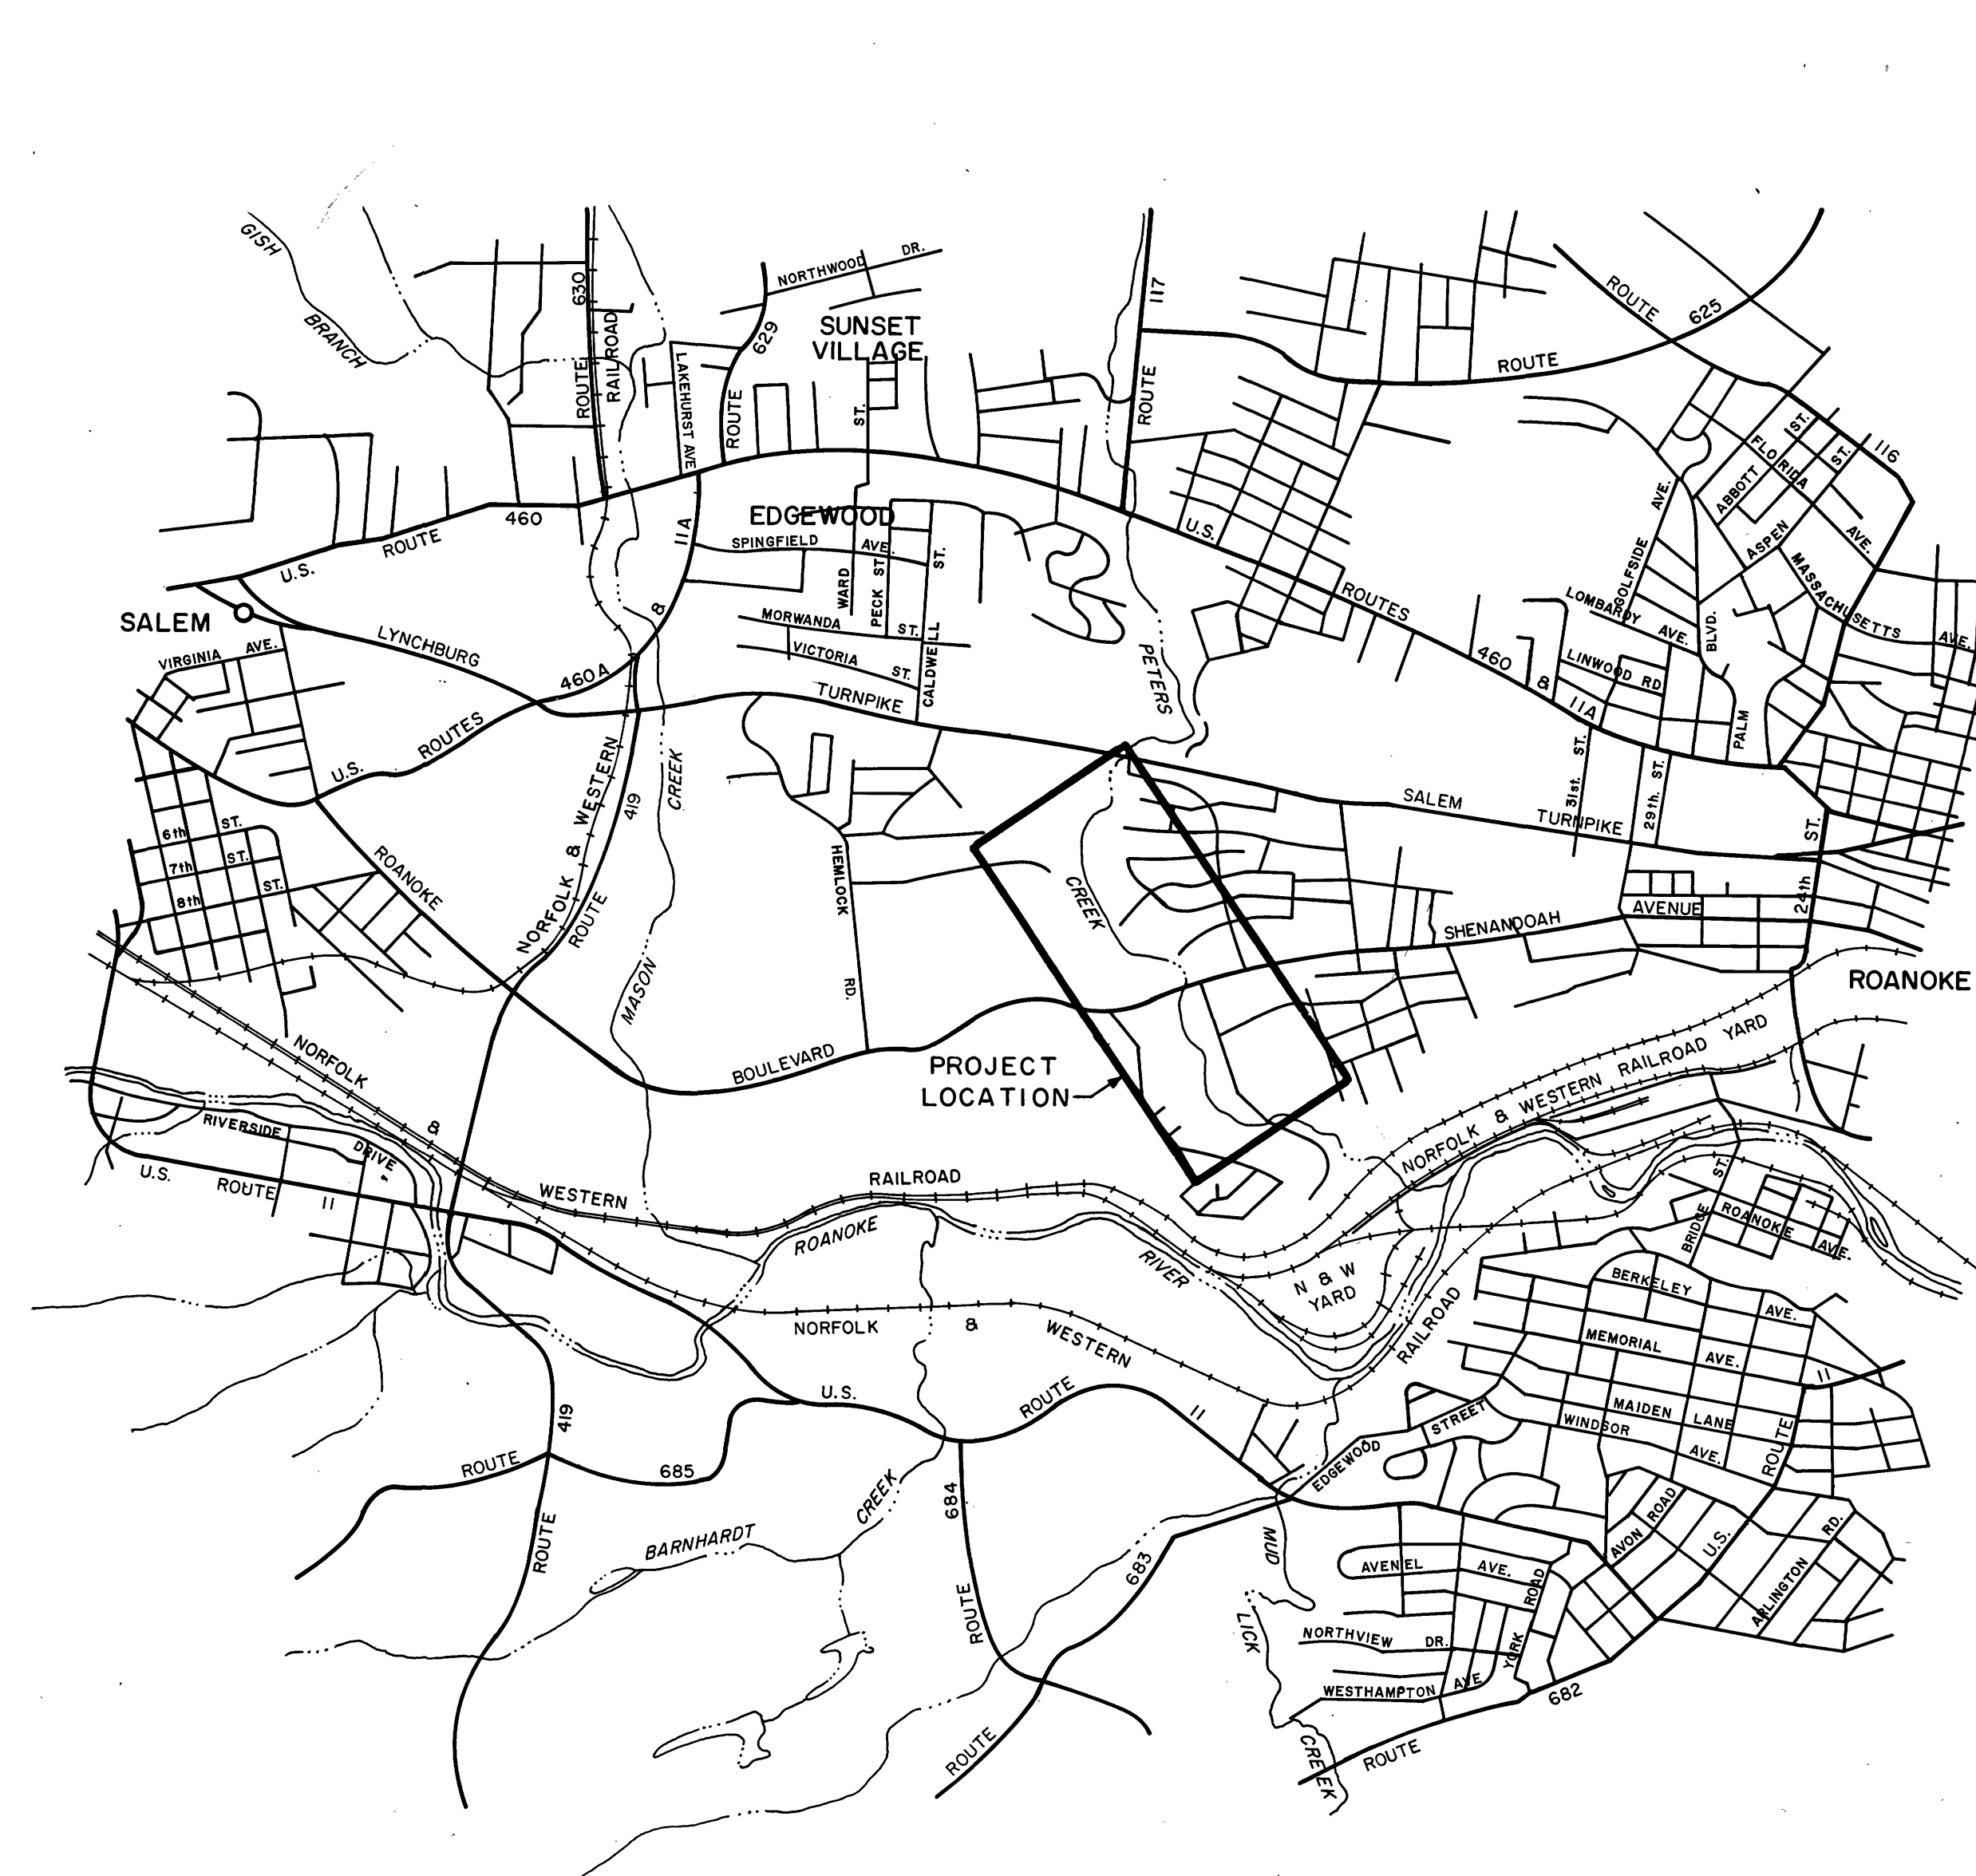

LEGEND

- | | |
|---|-----------------------------|
|  | SURVEY BASE LINE |
|  | PROPERTY LINE |
|  | RIGHT OF WAY LINE |
|  | EDGE OF PAVEMENT |
|  | EXISTING SANITARY SEWER |
|  | PROPOSED SANITARY SEWER |
|  | EXISTING MANHOLE |
|  | PROPOSED MANHOLE |
|  | PROPOSED CLEANOUT |
|  | PROPOSED METERING STATION |
|  | WATER MAIN |
|  | GAS LINE |
|  | ELECTRIC CABLE OR CONDUIT |
|  | TELEPHONE CABLE OR CONDUIT |
|  | RAILROAD TRACKS |
|  | DITCH |
|  | STREAM |
|  | FENCE |
|  | FIRE HYDRANT |
|  | POWER POLE |
|  | TELEPHONE POLE AND GUY WIRE |
|  | VALVE VAULT |
|  | WATER METER |
|  | TREE |
|  | SHRUB |
|  | HEDGE |
|  | ROCK OR STONE WALL |
|  | EXISTING GROUND |

S C H E D U L E O F D R A W I N G S

<u>SHEET</u>	<u>TITLE</u>	<u>STATION</u>
1	PETERS CREEK INTERCEPTOR	40+00 - 55+00
2	PETERS CREEK INTERCEPTOR	55+00 - 70+00
3	PETERS CREEK INTERCEPTOR	70+00 - 85+00
4	PETERS CREEK INTERCEPTOR	85+00 - 100+00
5	PETERS CREEK INTERCEPTOR	100+00 - 115+00
6	DETAILS	

S U M M A R Y O F Q U A N T I T I E S

[illegible]

LANGLEY, McDONALD AND OVERMAN
CONSULTING ENGINEERS
NORFOLK, VIRGINIA

AS BUILT

SANITARY SEWERAGE SYSTEM PETERS CREEK