

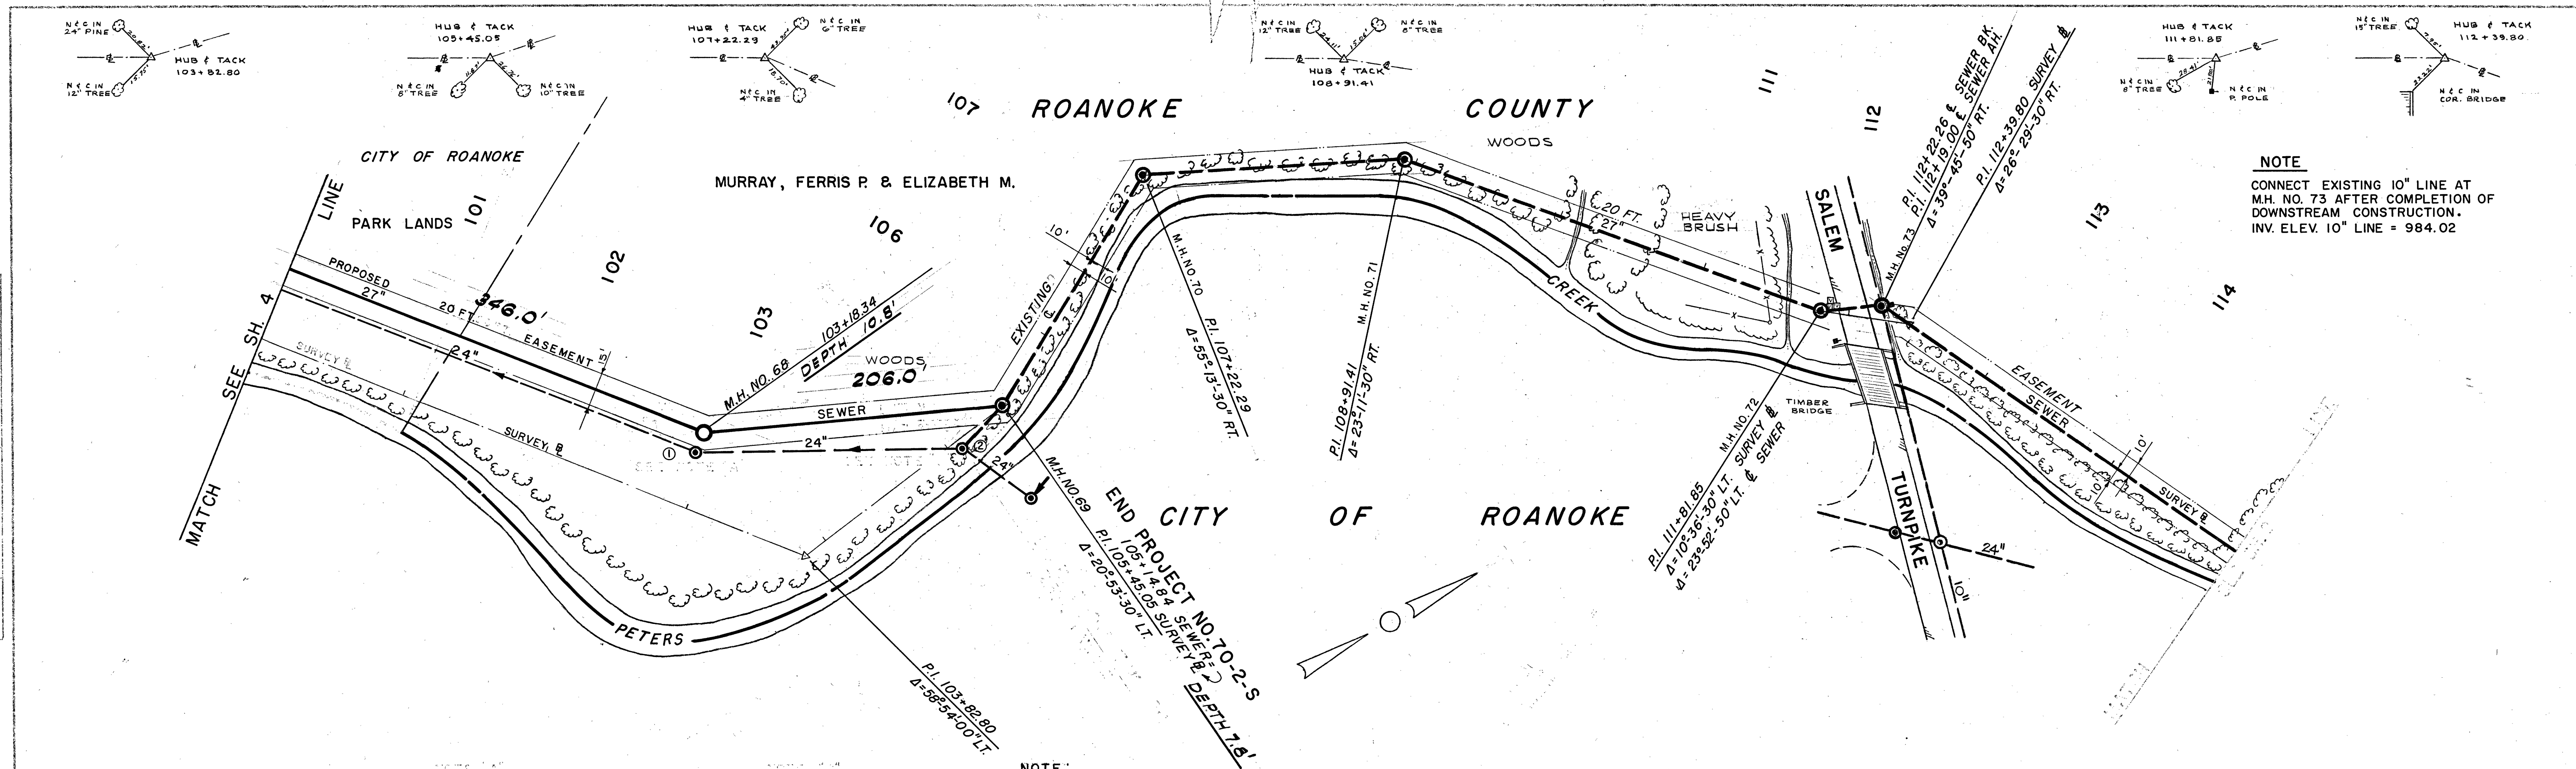


DATE	5/14/66
BY	W.L.S.
CHECKED	A.N.E.
NOTED	W.L.S.
REVISION	
NO.	

DATE	5/14/66
BY	W.L.S.
CHECKED	A.N.E.
NOTED	W.L.S.
REVISION	
NO.	

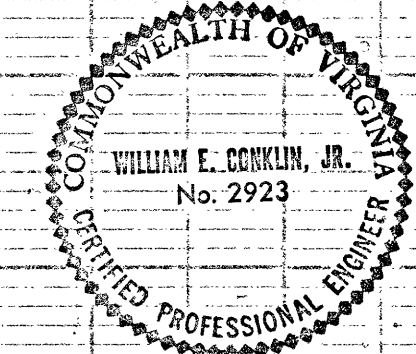

AS BUILT

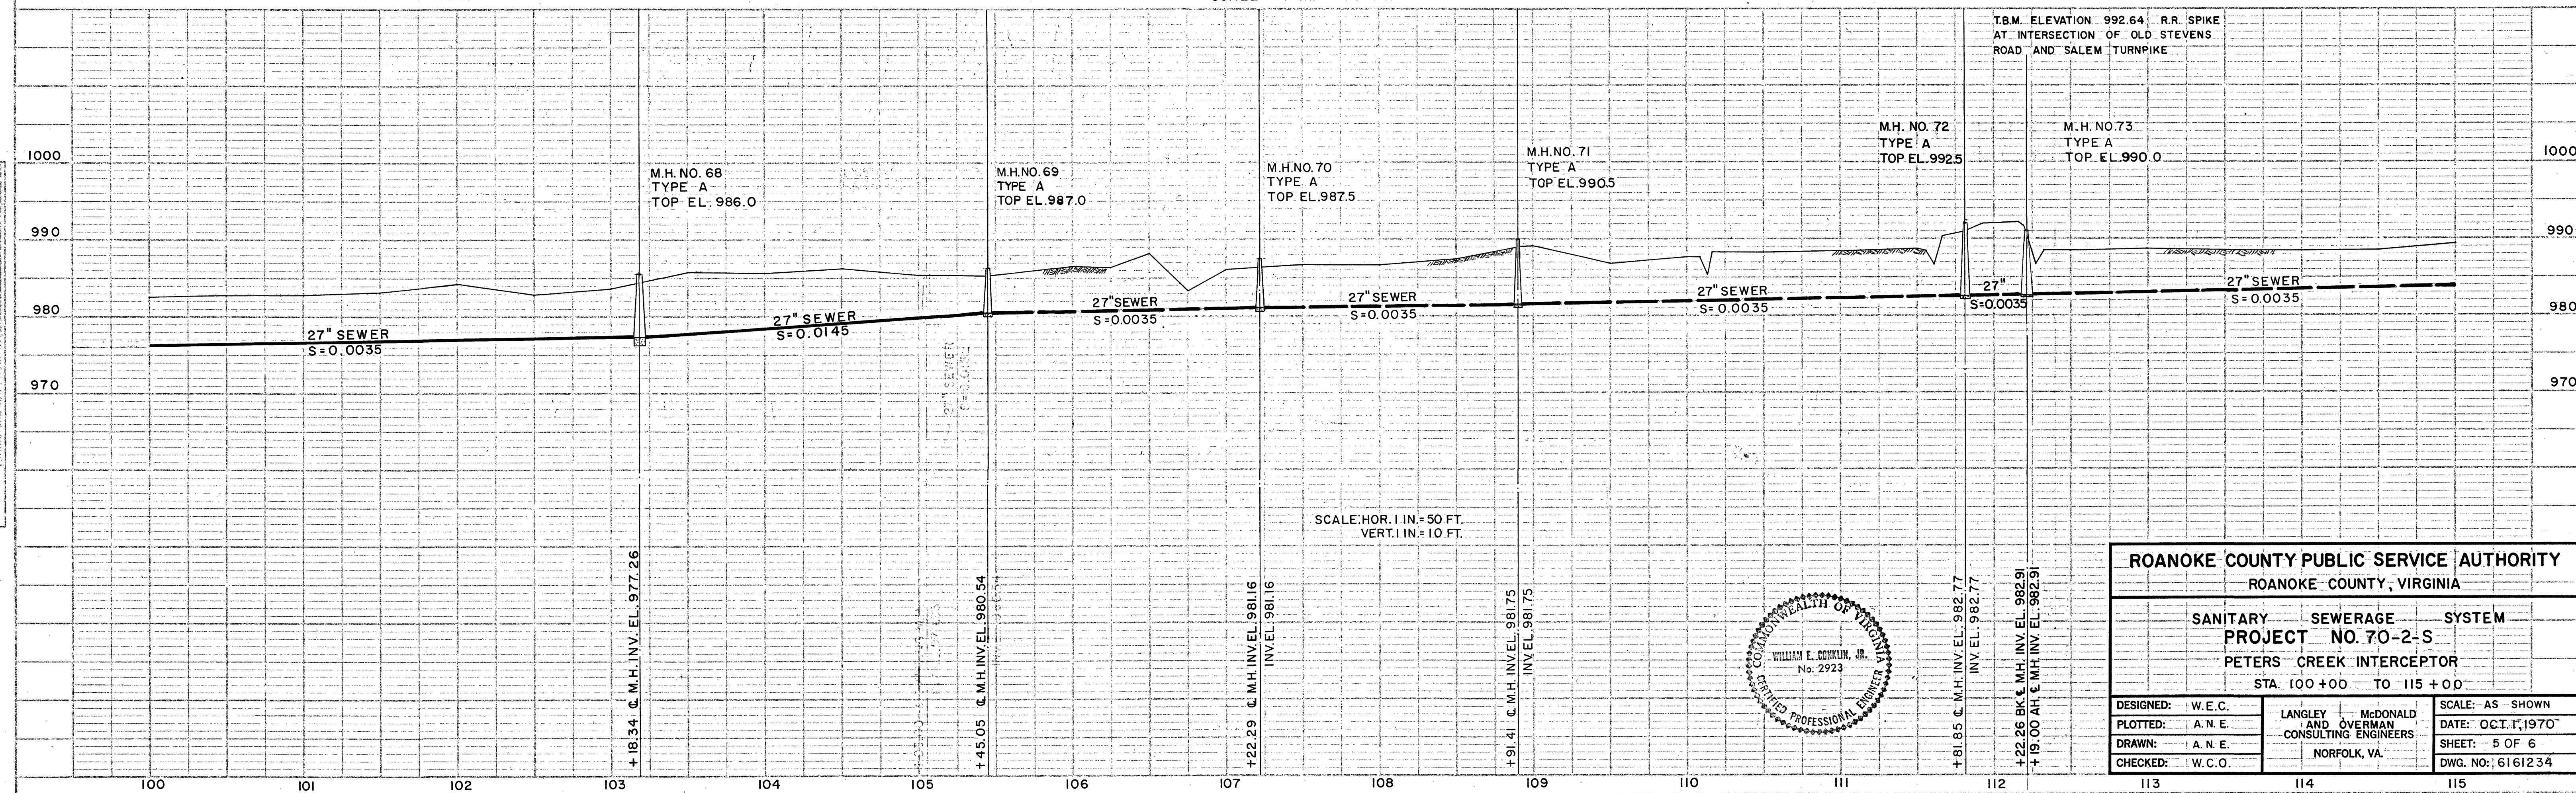

ROANOKE COUNTY PUBLIC SERVICE AUTHORITY ROANOKE COUNTY, VIRGINIA			
SANITARY SEWERAGE SYSTEM			
PROJECT NO. 70-2-S			
PETERS CREEK INTERCEPTOR			
STA. 100+00 TO 115+00			
DESIGNED:	W.E.C.	LANGLEY & McDONALD CONSULTING ENGINEERS NORFOLK, VA.	SCALE: AS SHOWN
PLOTTED:	A.N.E.		DATE: OCT. 1, 1970
DRAWN:	A.N.E.		SHEET: 5 OF 6
CHECKED:	W.C.O.		DWG. NO.: 6161234