


ROANOKE COUNTY
PUBLIC SERVICE AUTHORITY
ROANOKE COUNTY, VIRGINIA
PROJECT NO. 71-1-S

AUTHORITY MEMBERS

L. S. WALDROP		CHAIRMAN
F. R. ANGELL	VICE	CHAIRMAN
H. F. REED		
R. H. RICHARDSON		
B. W. MAHONEY		

J. A. BEAVERS **EXECUTIVE DIRECTOR**

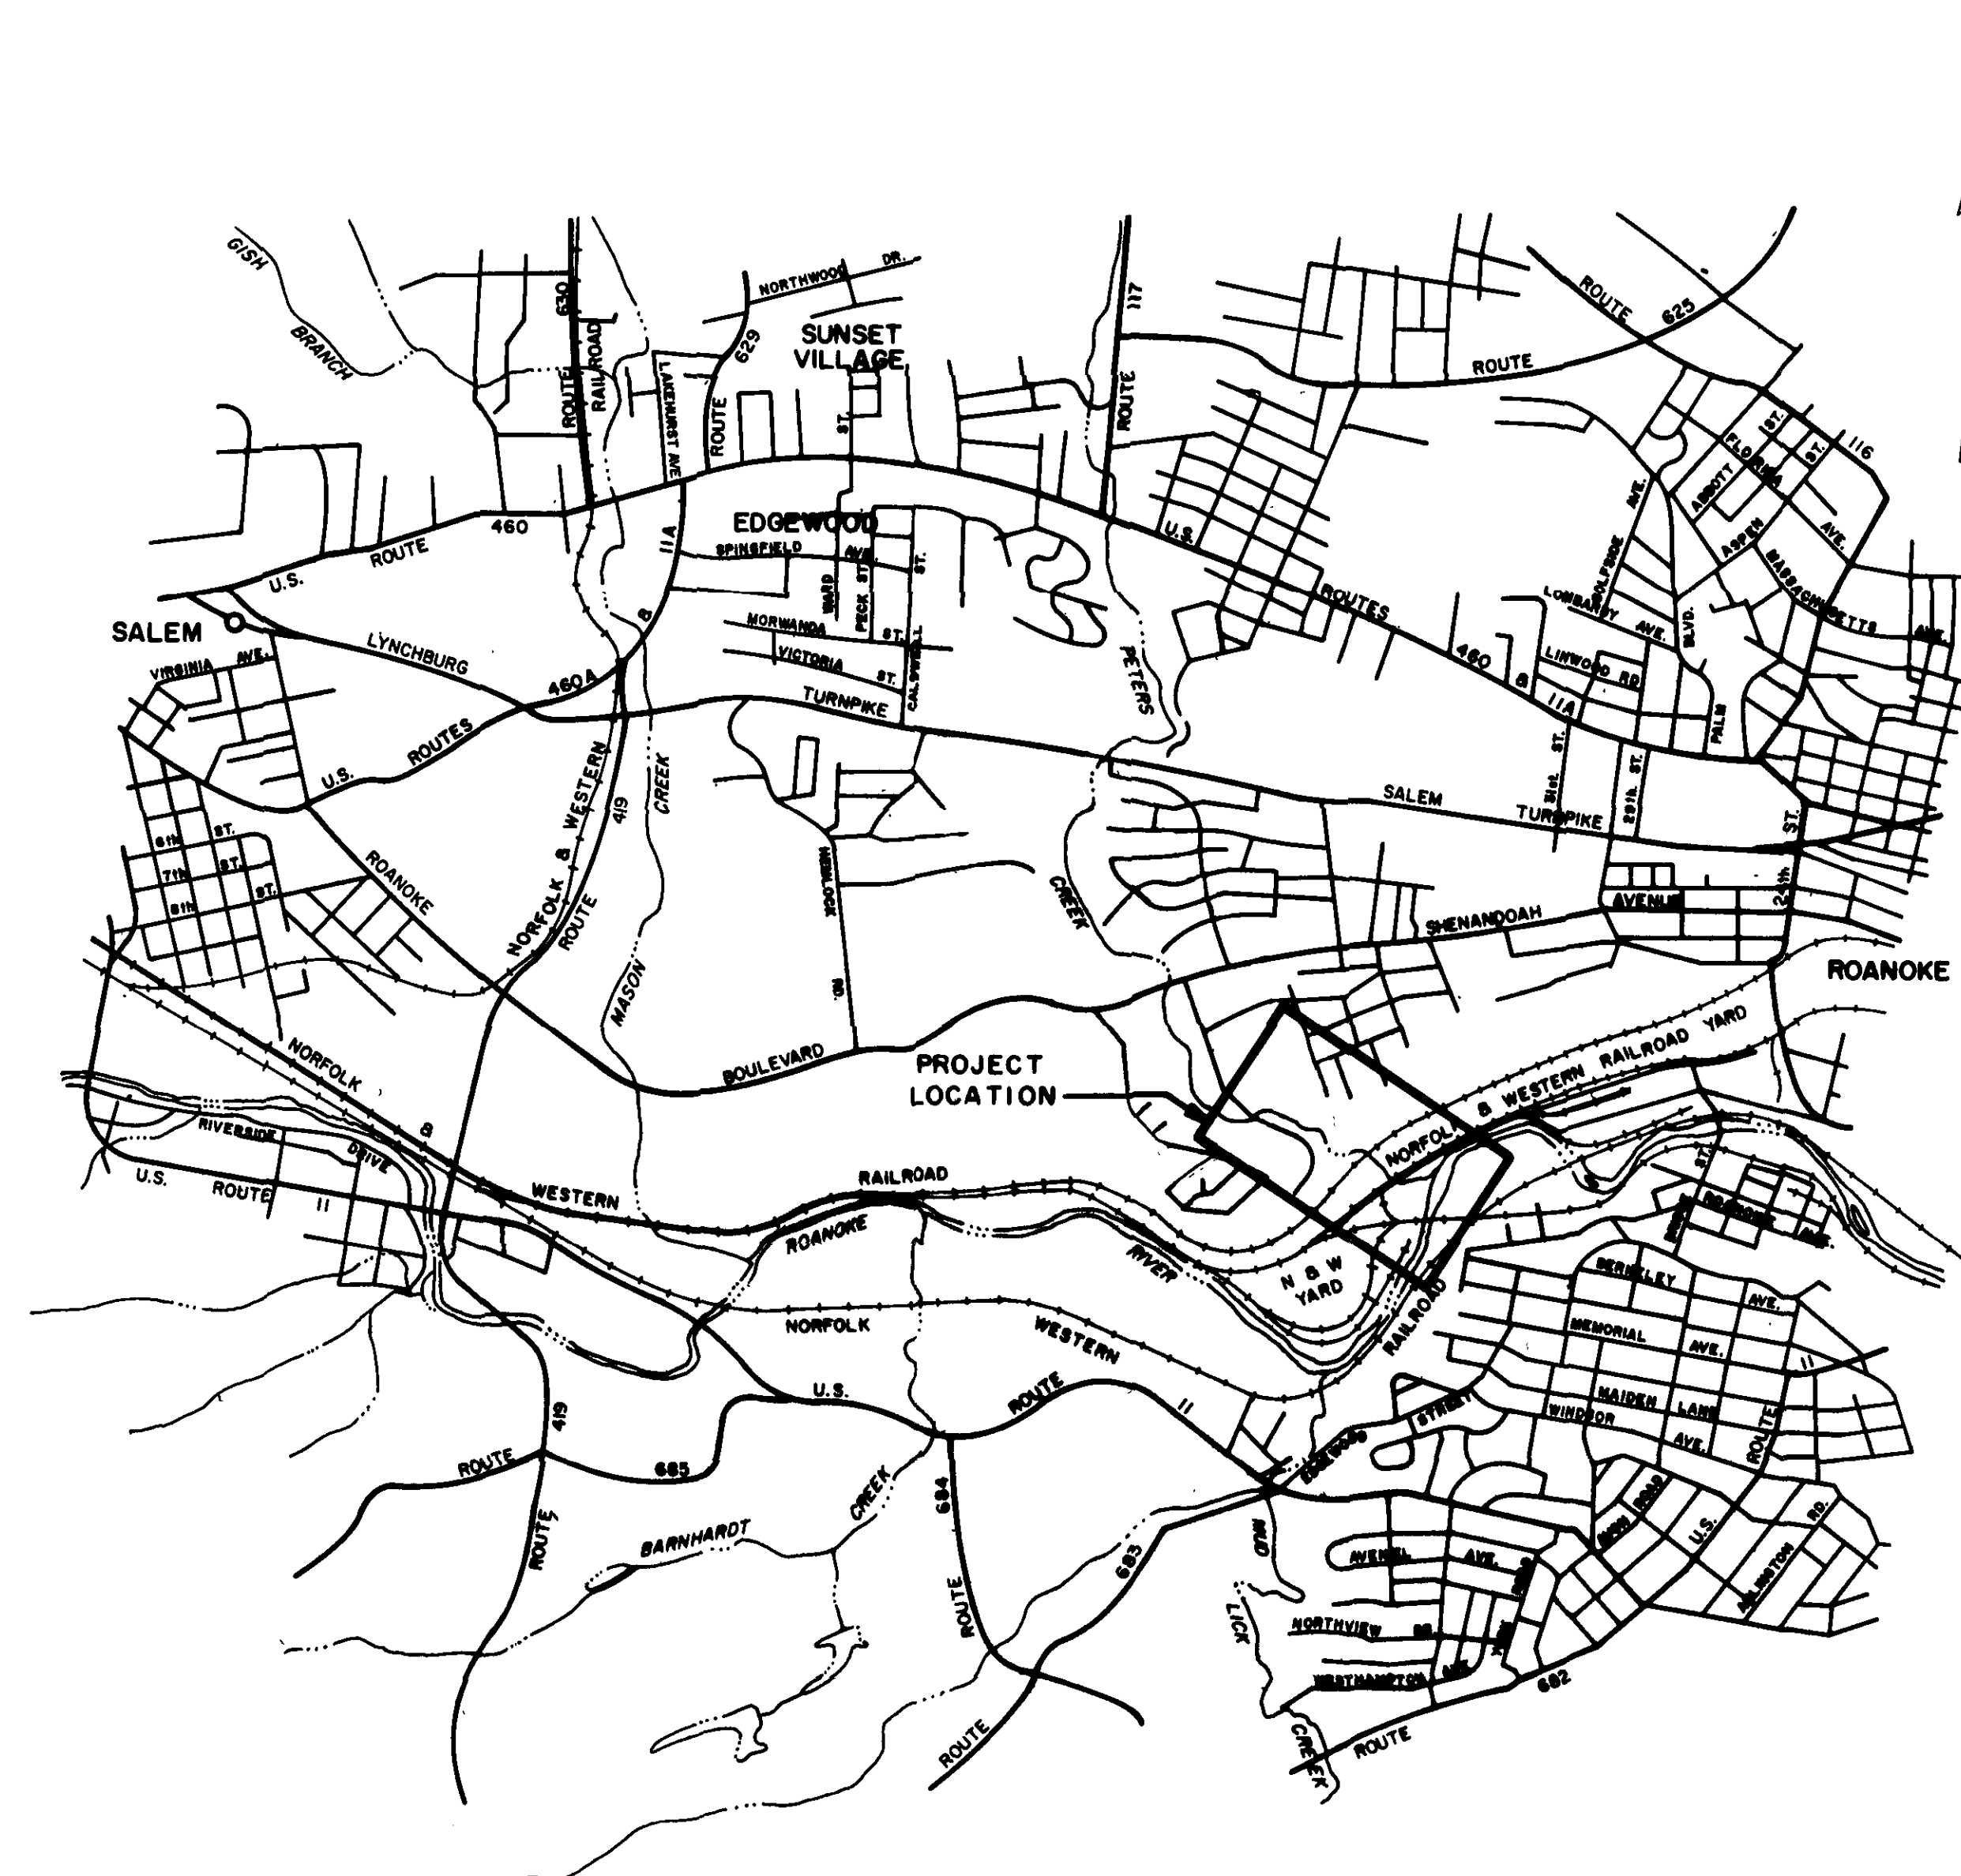

LEGEND

-  SURVEY BASE LINE
-  PROPERTY LINE
-  RIGHT OF WAY LINE
-  EDGE OF PAVEMENT
-  EXISTING SANITARY SEWER
-  PROPOSED SANITARY SEWER
-  EXISTING MANHOLE
-  PROPOSED MANHOLE
-  PROPOSED CLEANOUT
-  PROPOSED METERING STATION
-  WATER MAIN
-  GAS LINE
-  ELECTRIC CABLE OR CONDUIT
-  TELEPHONE CABLE OR CONDUIT
-  RAILROAD TRACKS
-  DITCH
-  STREAM
-  FENCE
-  FIRE HYDRANT
-  POWER POLE
-  TELEPHONE POLE AND GUY WIRE
-  VALVE VAULT
-  WATER METER
-  TREE
-  SHRUB
-  HEDGE
-  ROCK OR STONE WALL
-  EXISTING GROUND


SCHEDULE OF DRAWINGS

<u>SHEET</u>	<u>TITLE</u>	<u>STATION</u>
1	PETERS CREEK INTERCEPTOR	1 + 19.56 - 13 + 00
2	PETERS CREEK INTERCEPTOR	13 + 00 - 27 + 00
3	PETERS CREEK INTERCEPTOR	27 + 00 - 33 + 53
4	SIPHON	
5	METERING CHAMBER	
6	DETAILS	
7	DETAILS	

[illegible]

SANITARY SEWERAGE SYSTEM PETERS CREEK

LANGLEY, McDONALD AND OVERMAN
CONSULTING ENGINEERS
NORFOLK, VIRGINIA

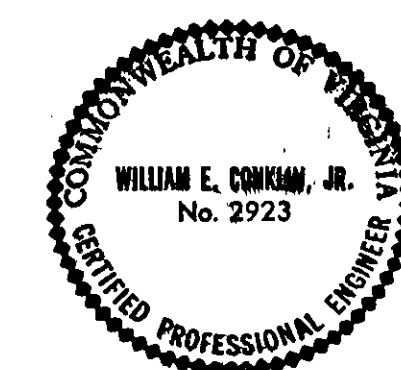

AS BUILT