

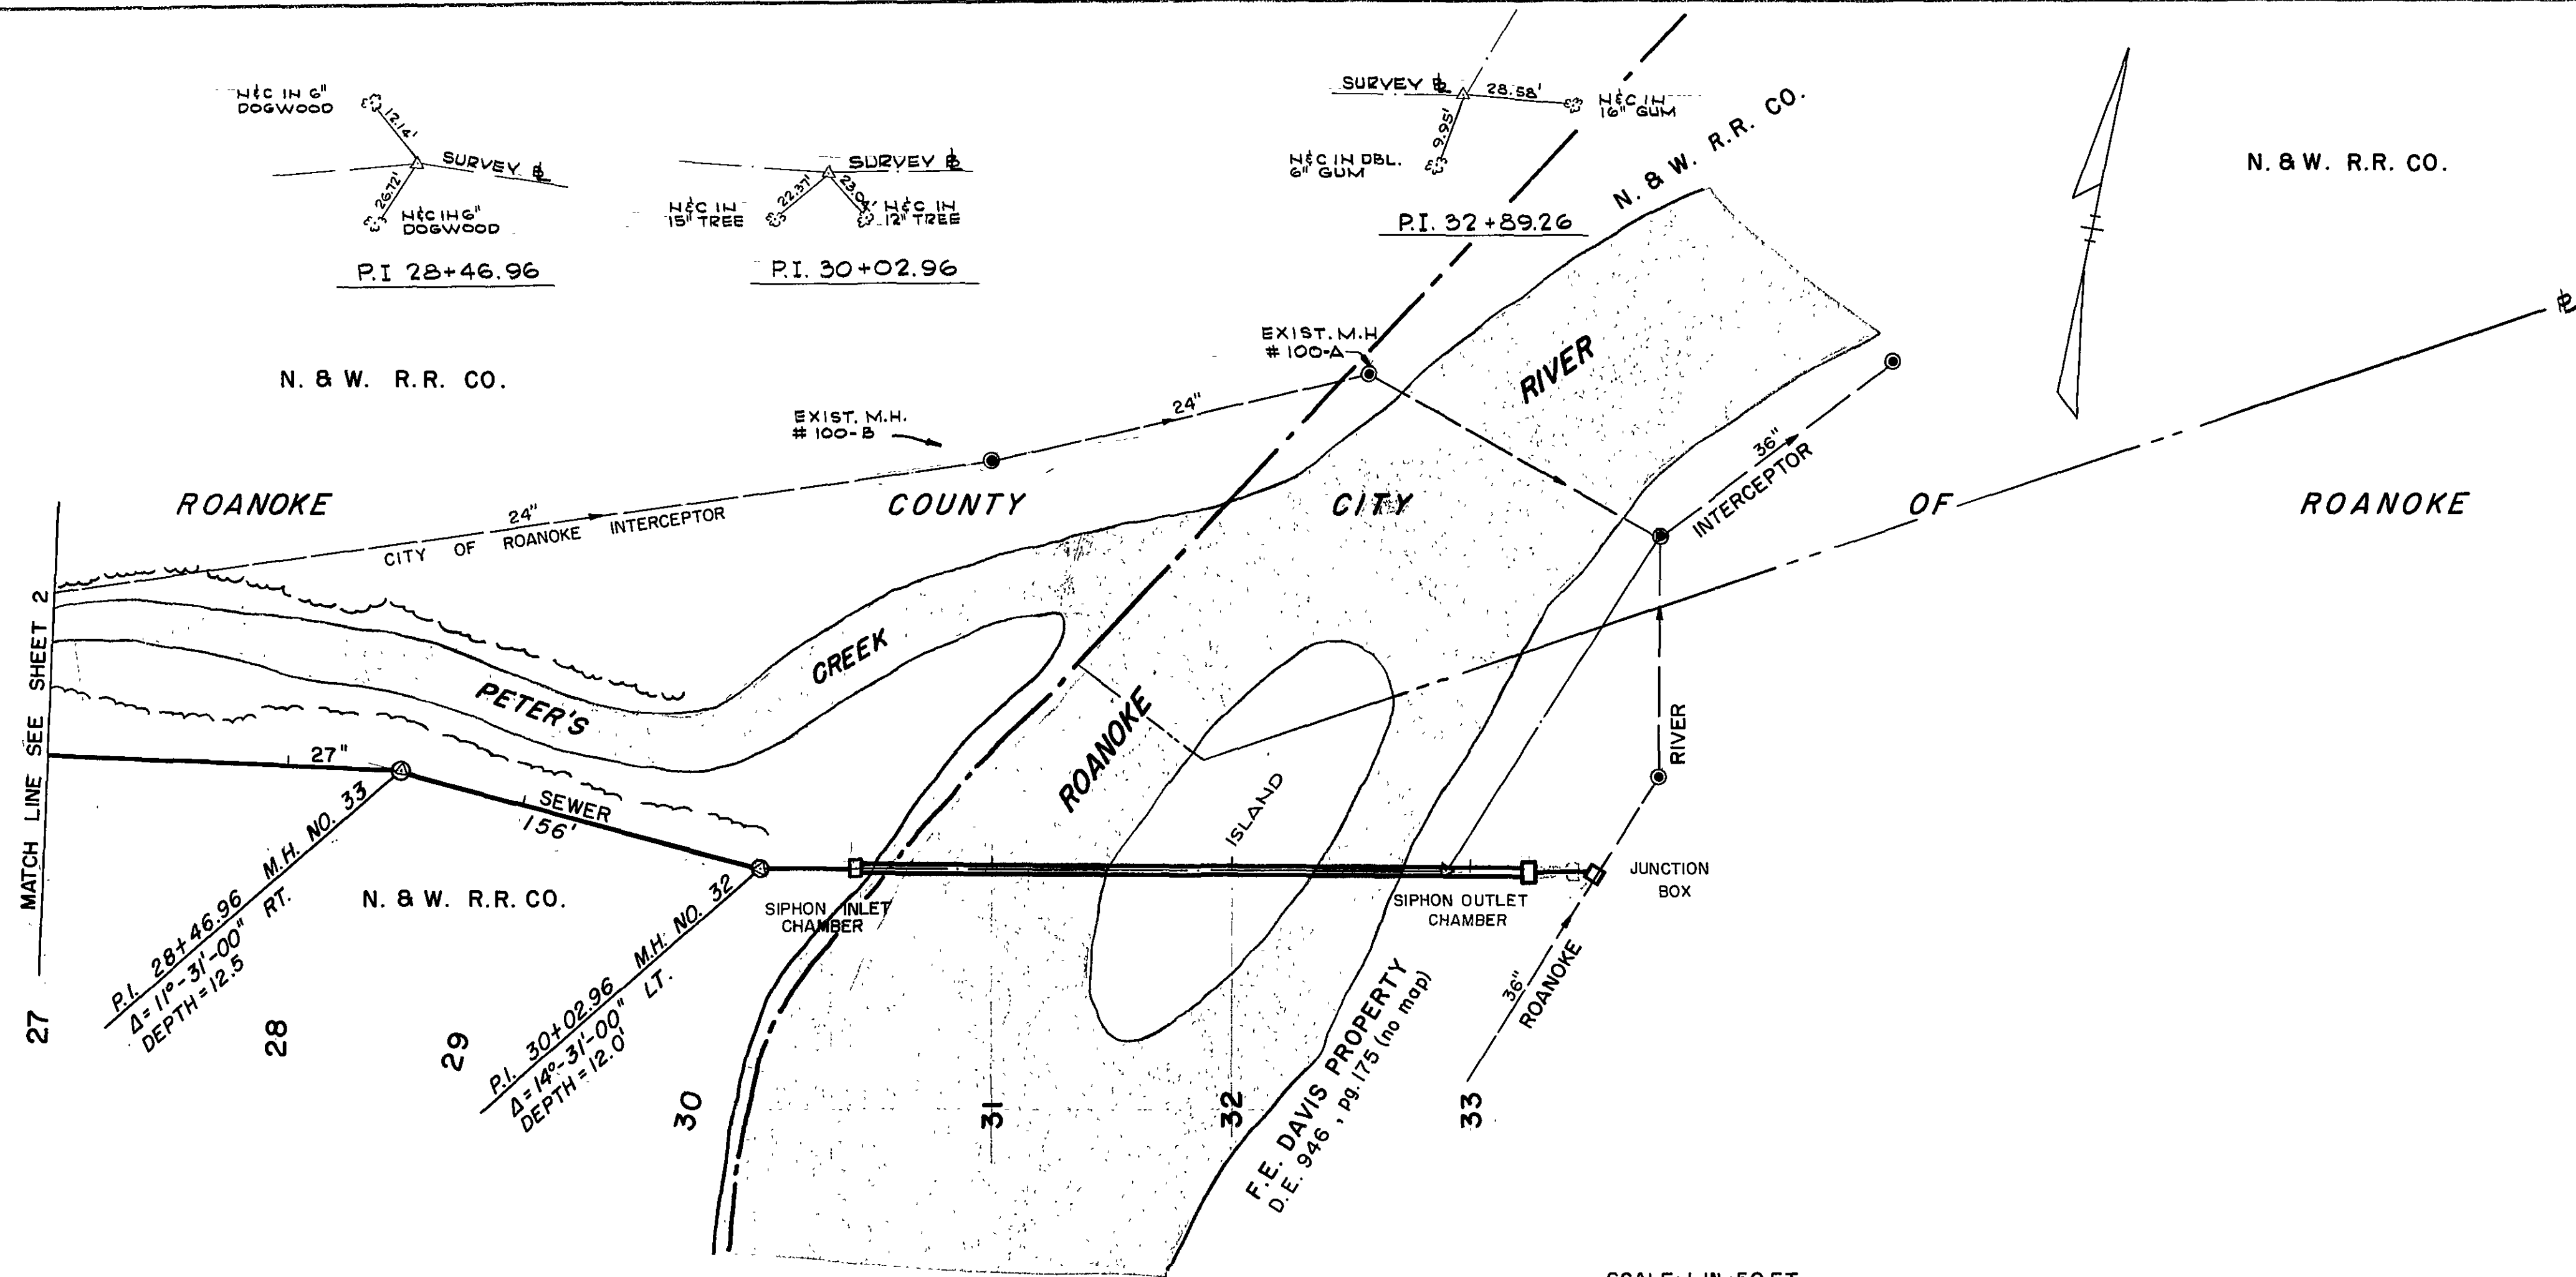


PLAN	SURVEYED	DATE
	NOTED	BY
NO.	PLotted	
	RT. OF WAY CHECKED	

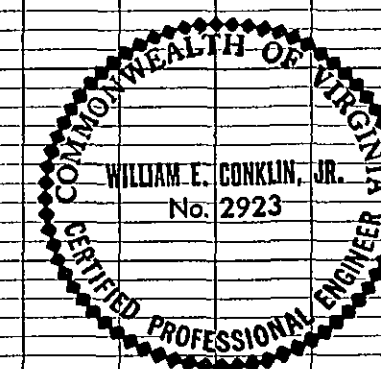

PROFILE	SURVEYED	DATE
	NOTED	BY
NO.	GRADES CHECKED	
	STRUCTURE NOTATION CHNG	

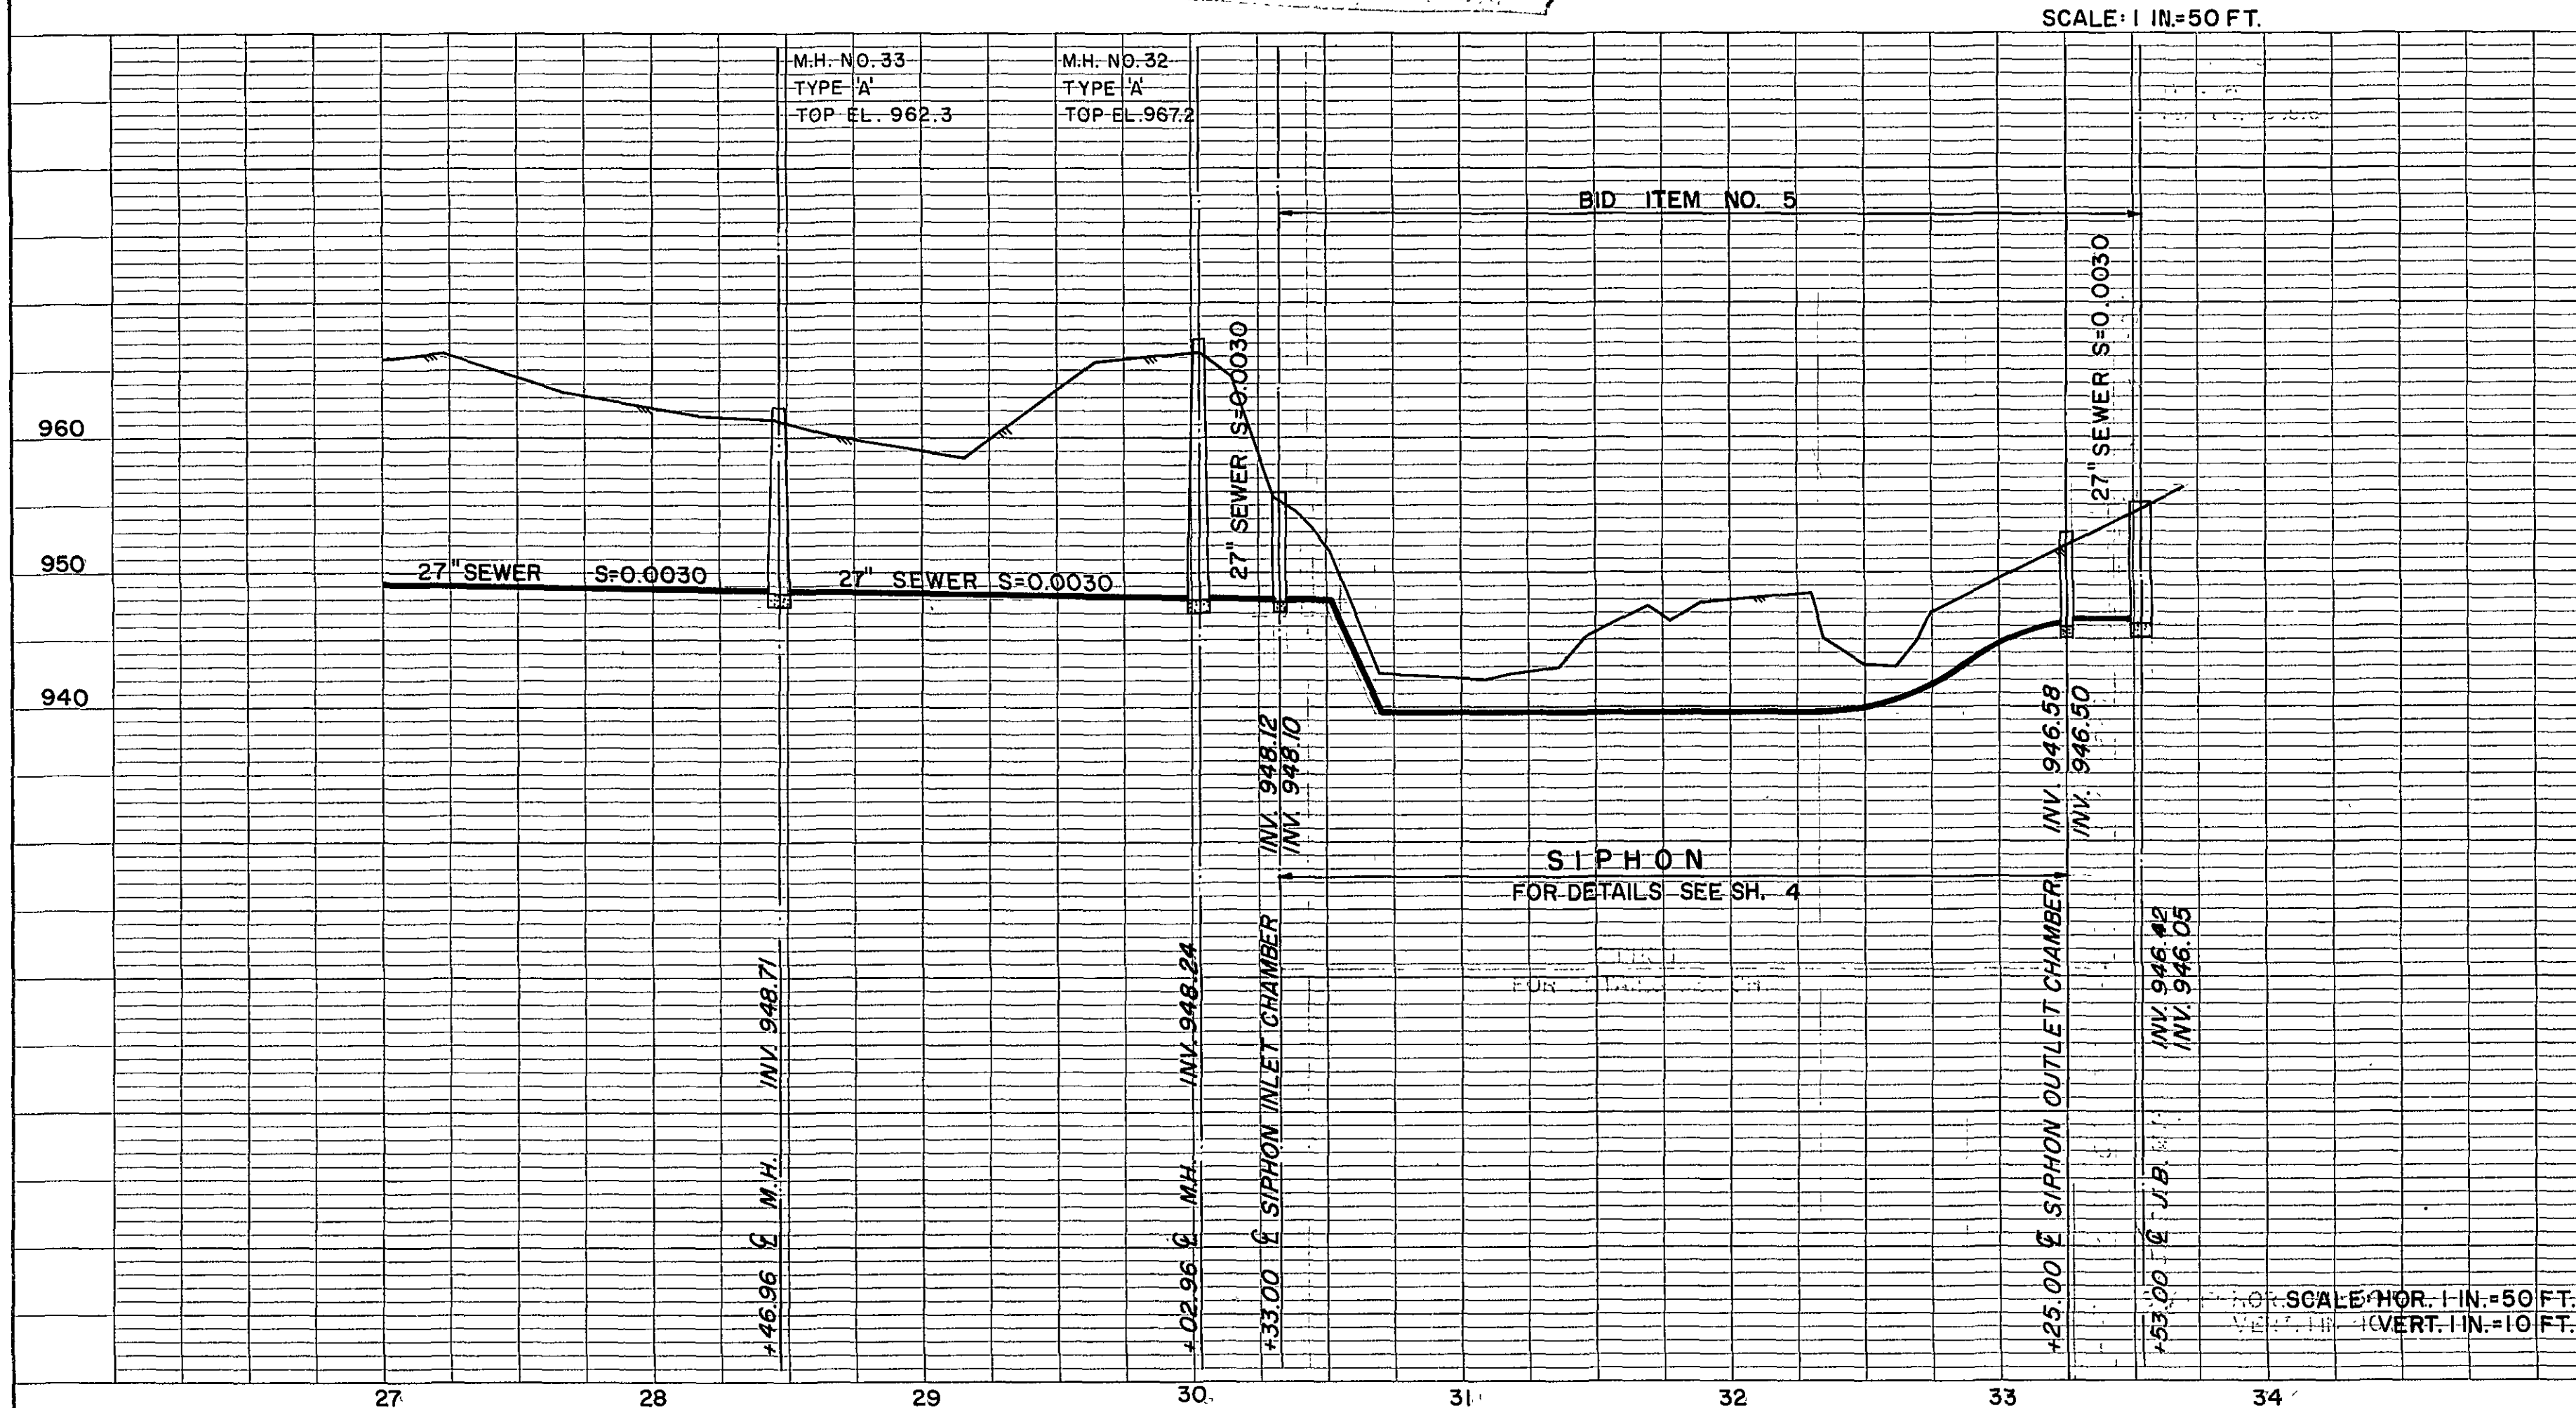

AS BUILT		
ROANOKE COUNTY PUBLIC SERVICE AUTHORITY ROANOKE COUNTY, VIRGINIA		
SANITARY	SEWERAGE	SYSTEM
PETERS	CREEK	INTERCEPTOR
PROJECT No. 71-1-S		
STA. 27+00 TO STA. 33+53		
DES: G.E.P.	LANGLEY, McDONALD and OVERMAN	
DR: J.W.M.	CONSULTING ENGINEERS	
CHK: W.E.C.	NORFOLK, VIRGINIA	
SCALE: AS SHOWN	DATE: 5-20-71	SHEET 3 OF 7