




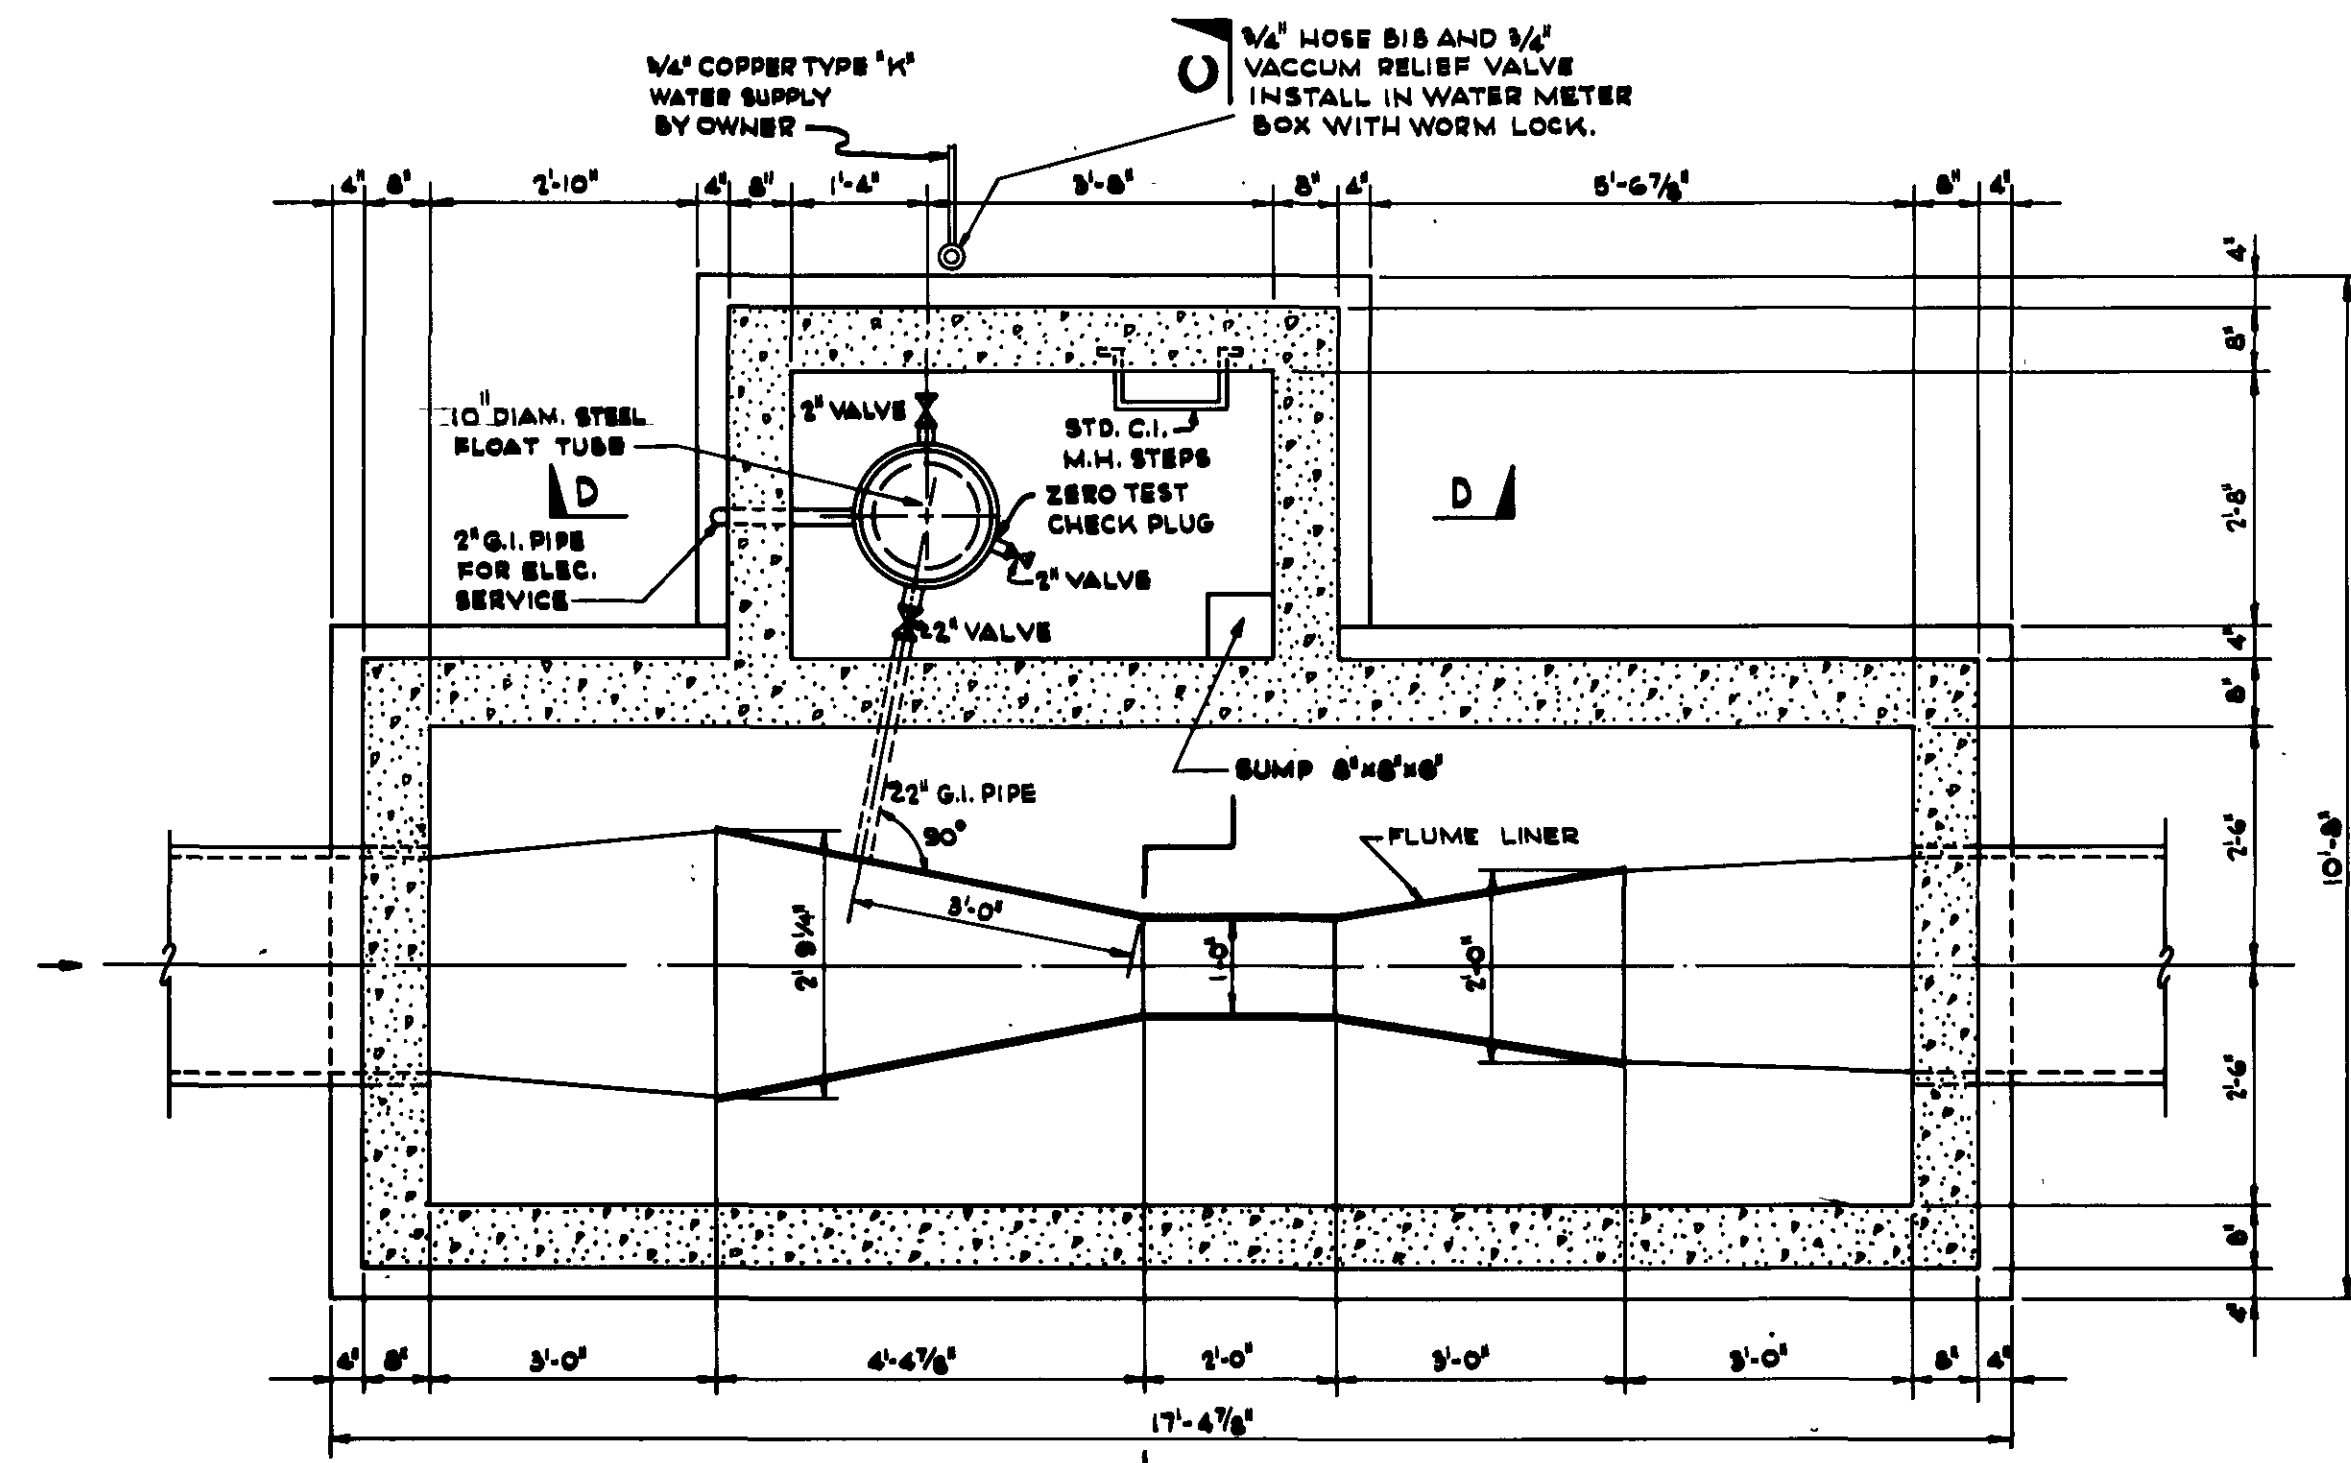


SECTION 'A-A'  
SCALE: 1/4" = 1'-0"

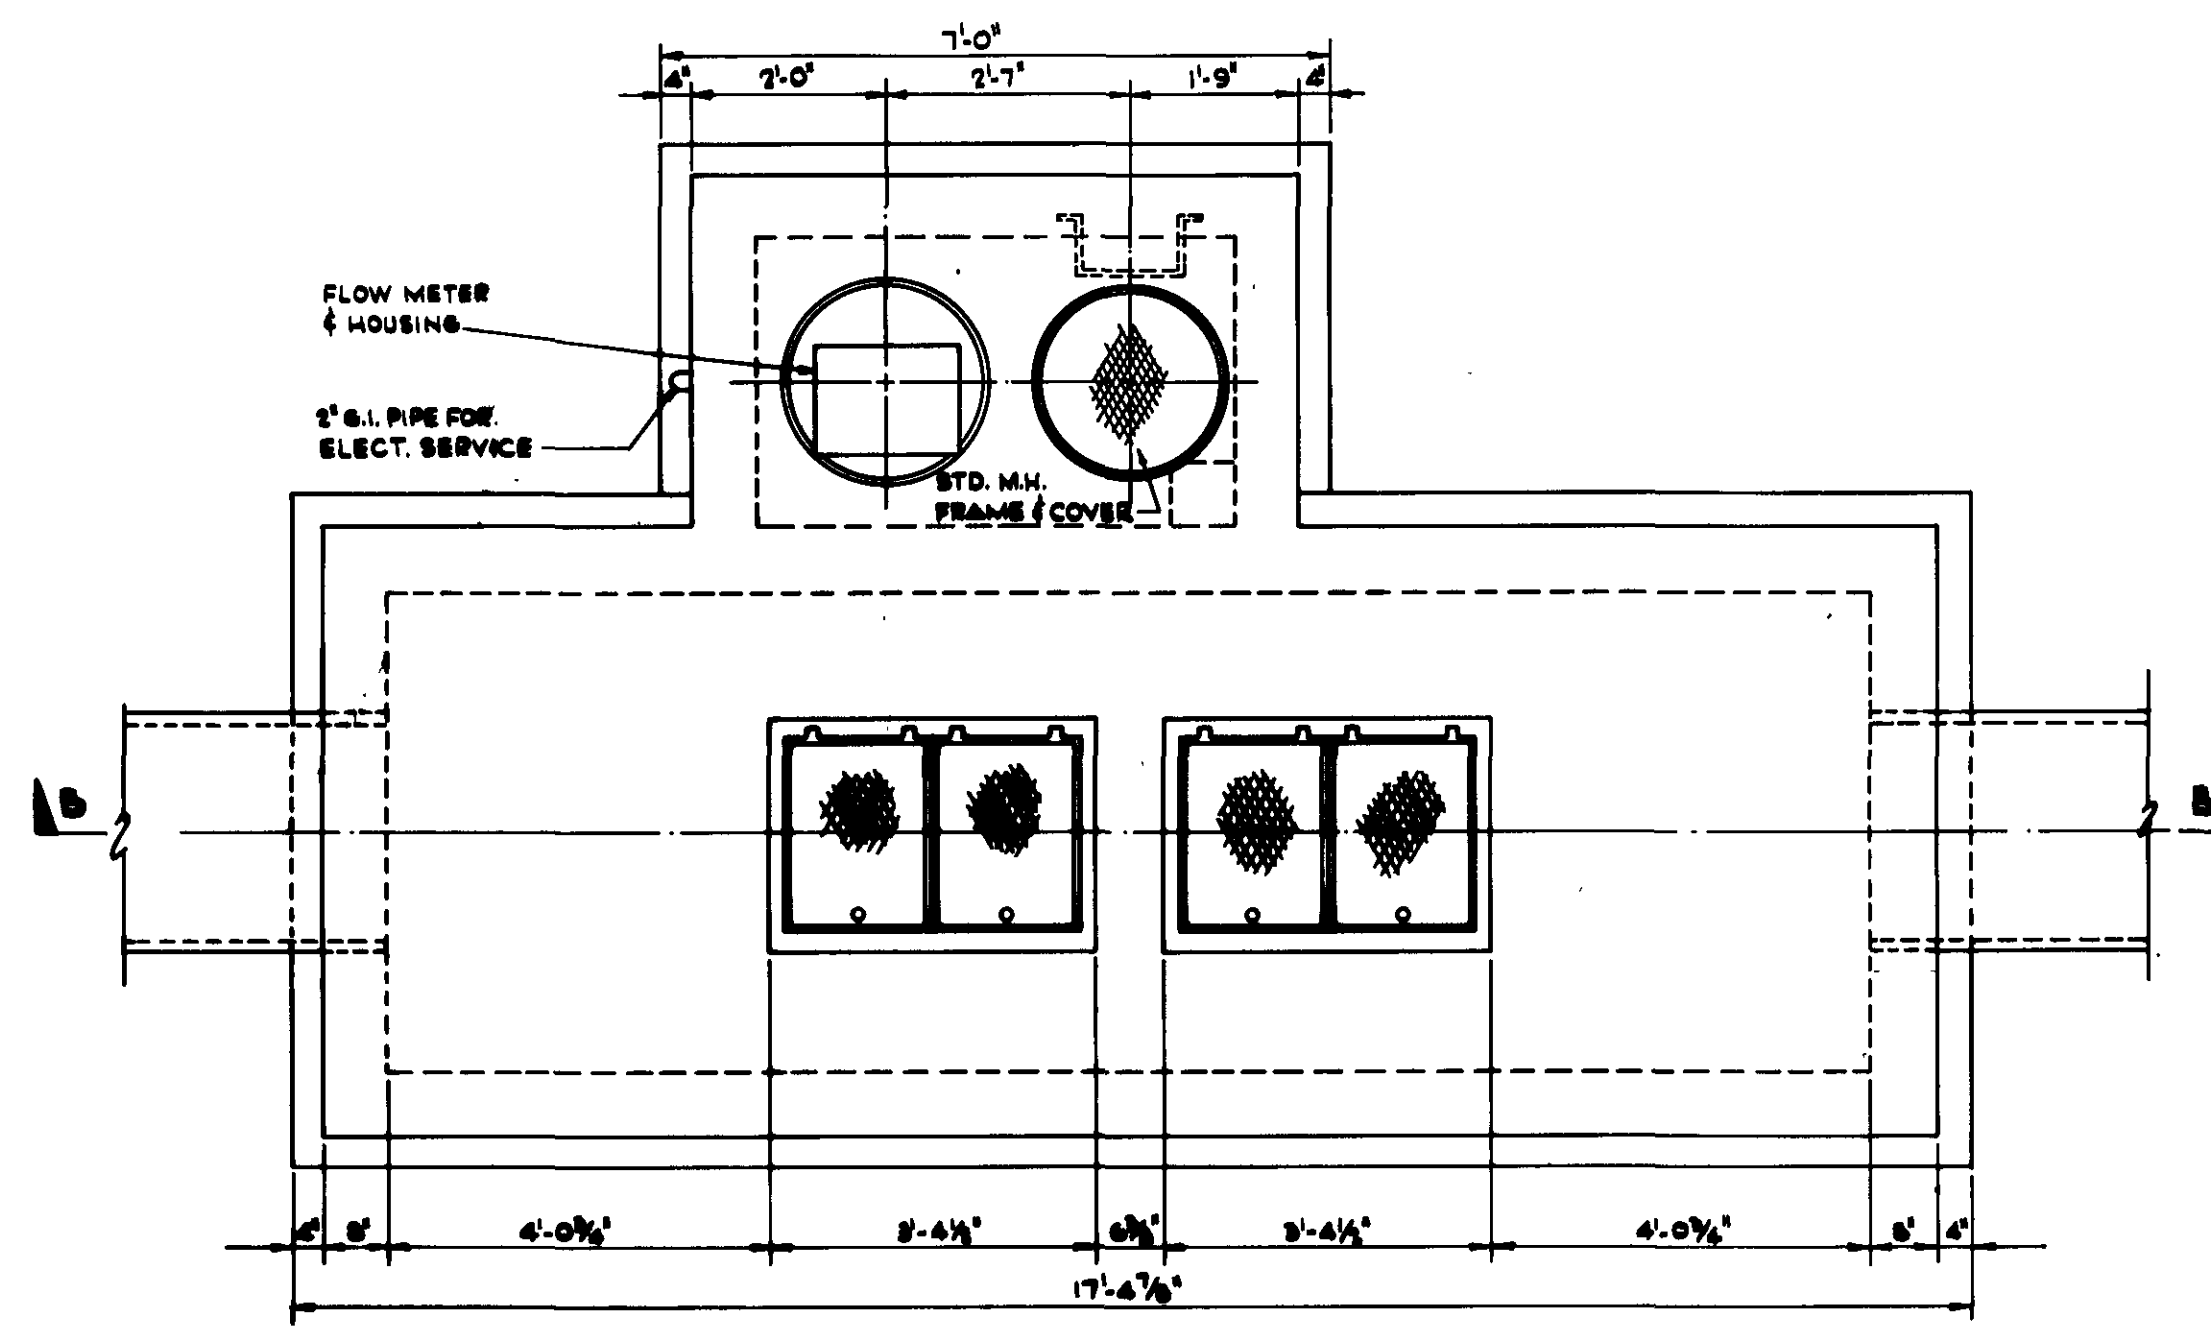


PLAN  
SCALE: 1/4" = 1'-0"

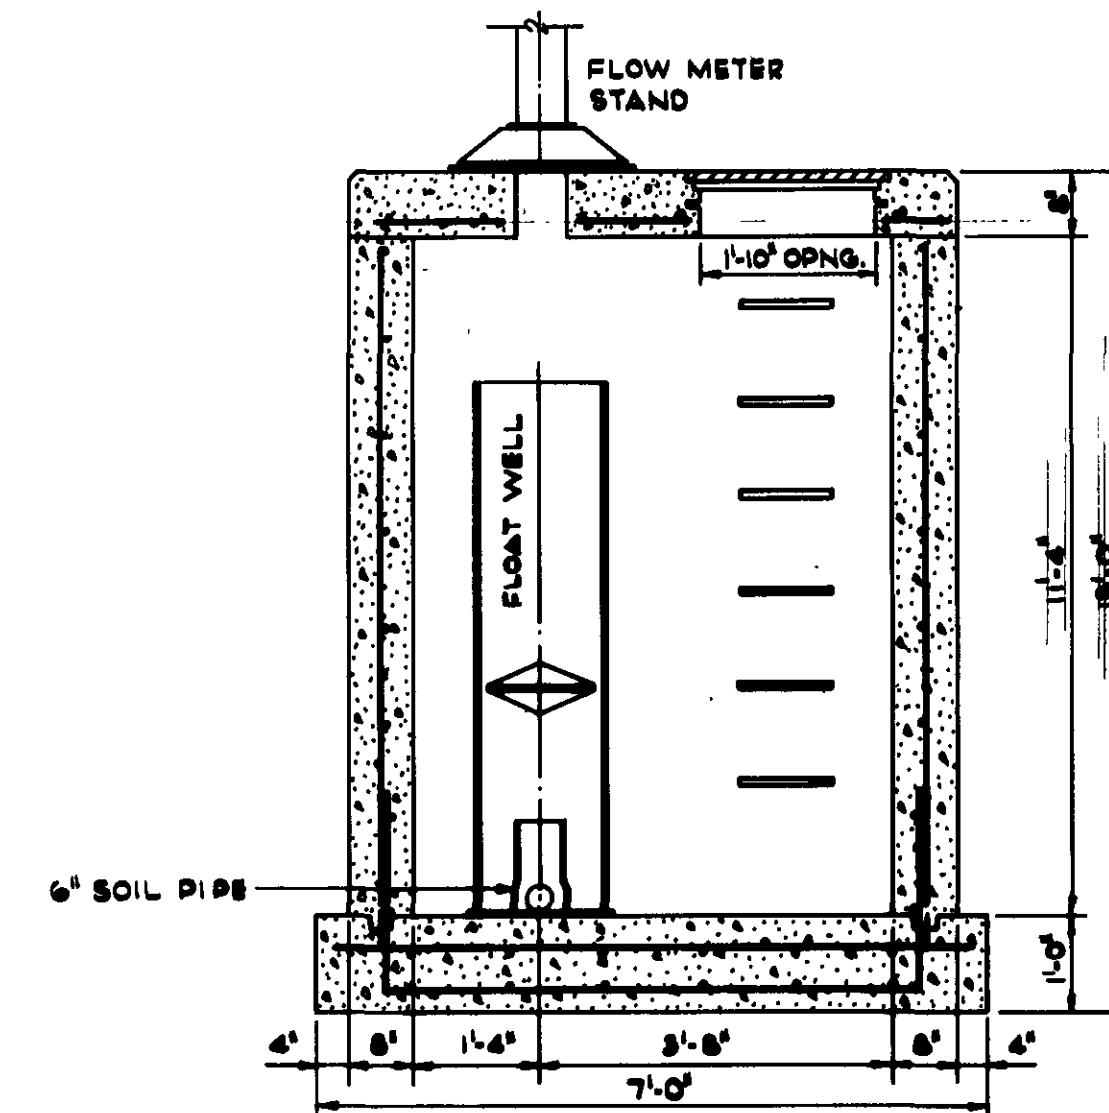


SECTION 'D-D'  
SCALE: 1/4" = 1'-0"

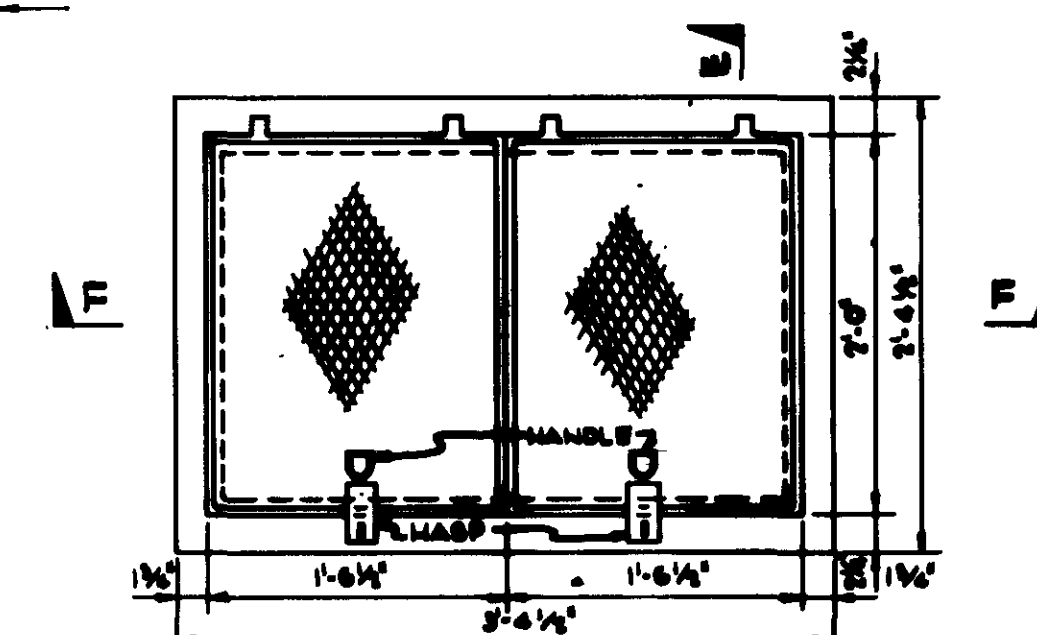


PLAN  
SCALE: 1/4" = 1'-0"

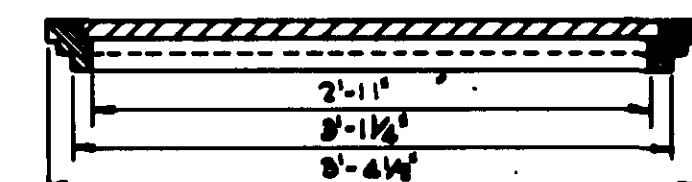


SECTION 'E-E'  
SCALE: 1/4" = 1'-0"

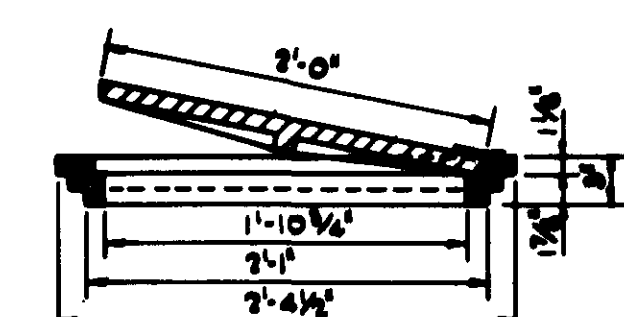

SECTION 'F-F'  
SCALE: 1/4" = 1'-0"

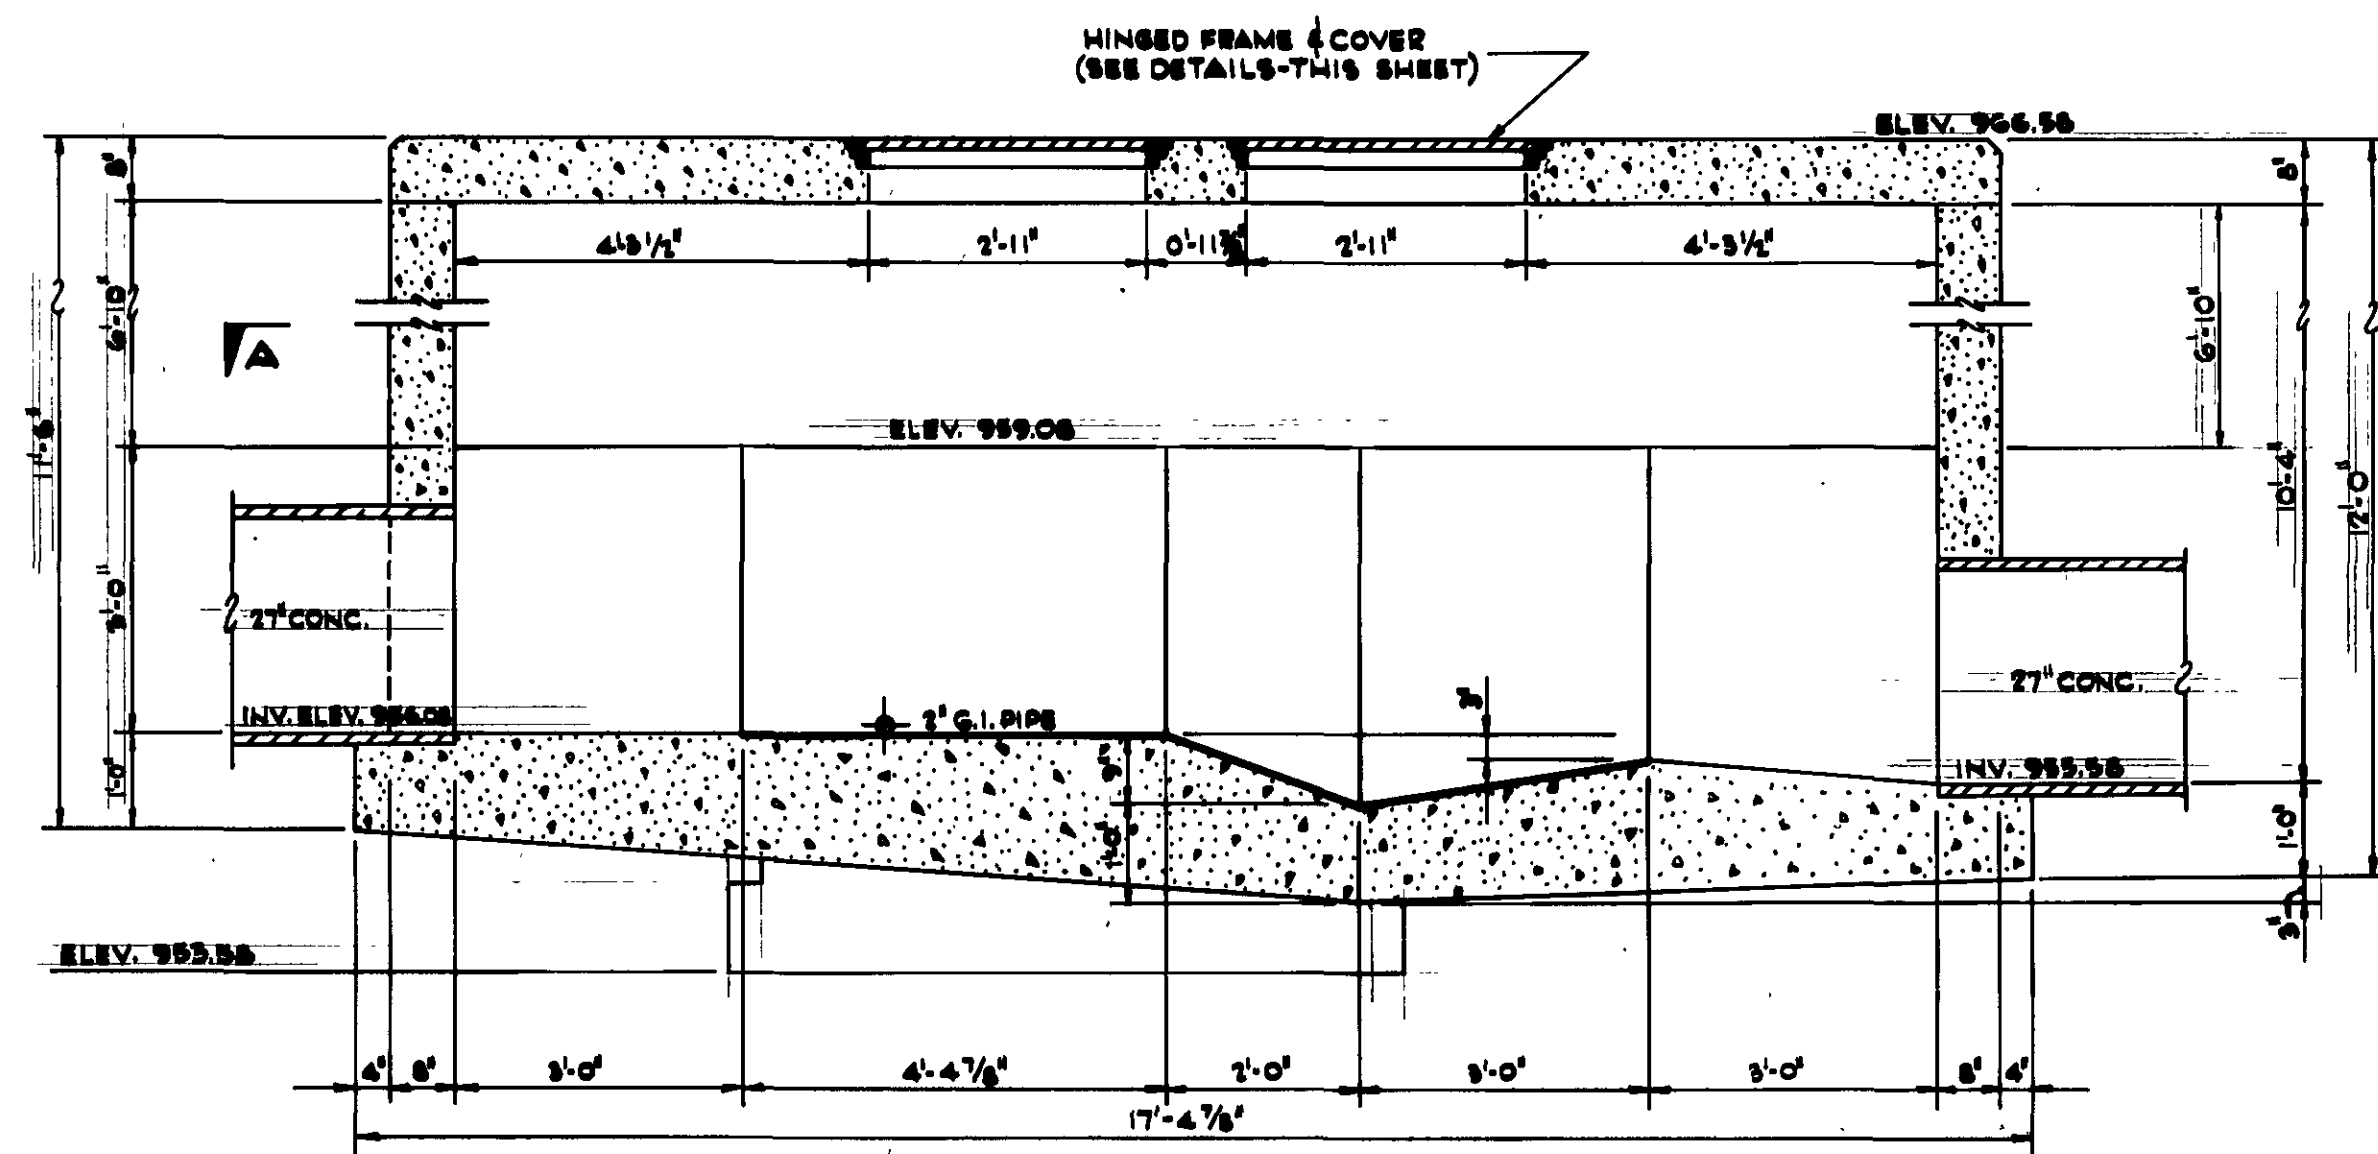


SECTION 'B-B'  
SCALE: 1/4" = 1'-0"

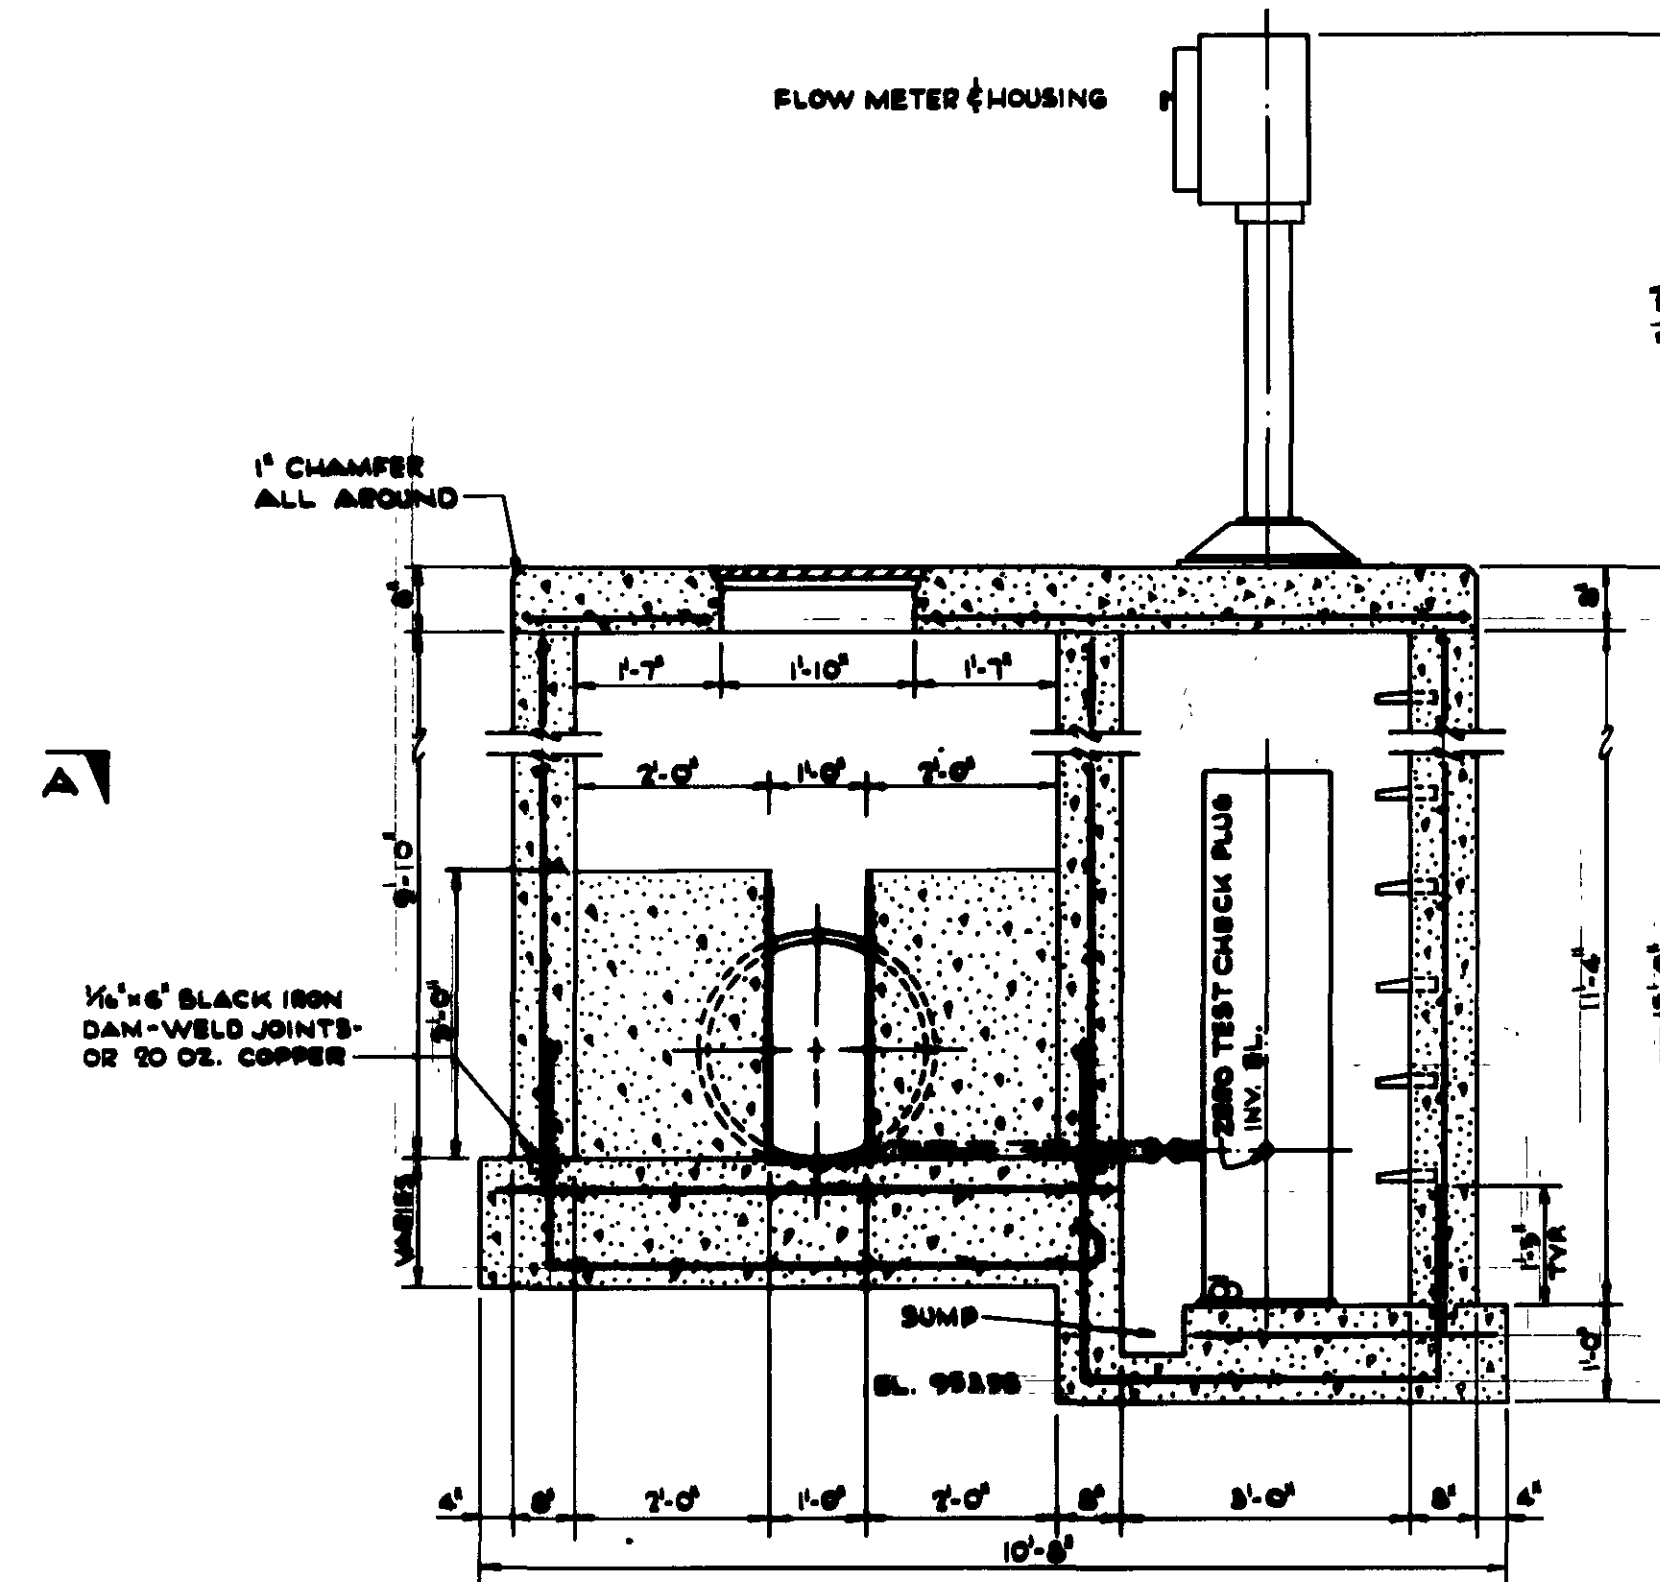


SECTION 'C-C'  
SCALE: 1/4" = 1'-0"

PAINT O.S. WALLS  
WITH 2 COATS  
BITUMASTIC NO. 50

ALL REINF.  
STEEL #5 @ 12"

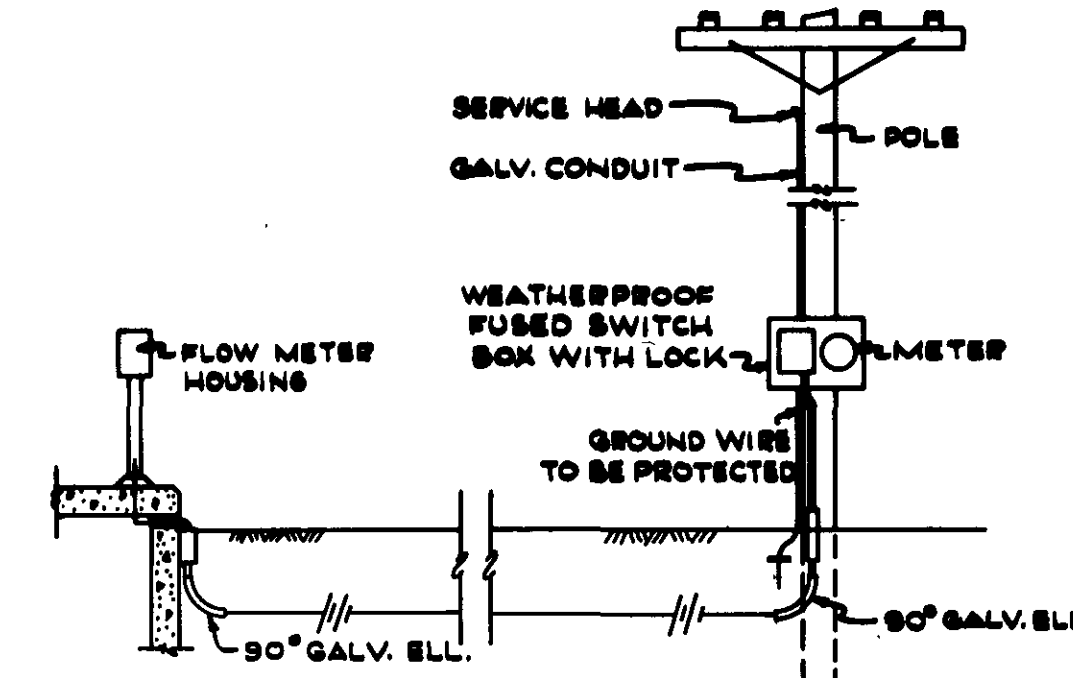

ELECTRICAL SERVICE CONNECTION  
NOT TO SCALE

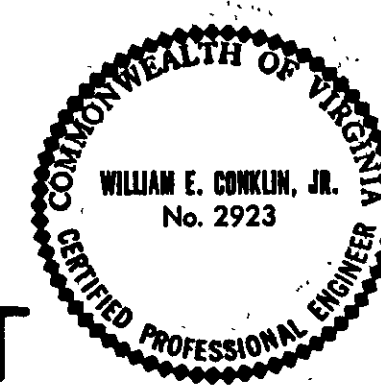

AS BUILT

|                                                                     |                               |                 |
|---------------------------------------------------------------------|-------------------------------|-----------------|
| ROANOKE COUNTY PUBLIC SERVICE AUTHORITY<br>ROANOKE COUNTY, VIRGINIA |                               |                 |
| SANITARY SEWERAGE SYSTEM<br>PETERS CREEK INTERCEPTOR                |                               |                 |
| PROJECT No. 71-1-S<br>METERING CHAMBER                              |                               |                 |
| DES: W.E.C.                                                         | LANGLEY, McDONALD and OVERMAN | SCALE: AS SHOWN |
| DR: W.H.C.                                                          | CONSULTING ENGINEERS          | DATE: 5-20-71   |
| CK: W.E.C.                                                          | NORFOLK, VIRGINIA             | SHEET 5 OF 7    |