


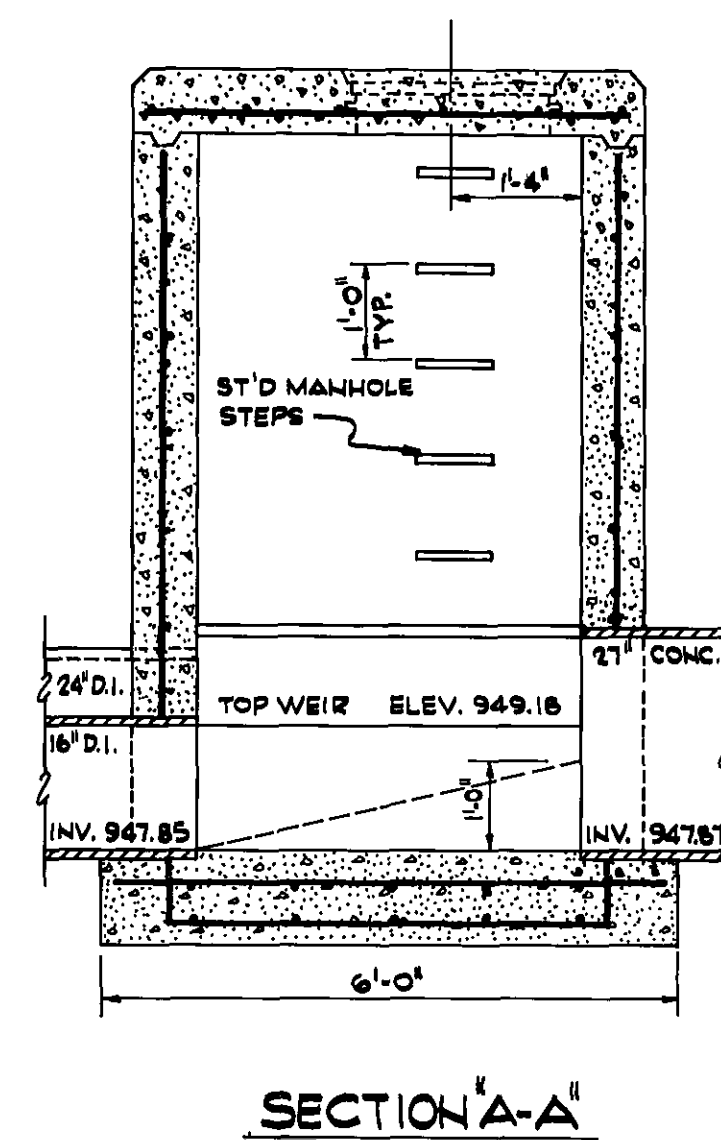
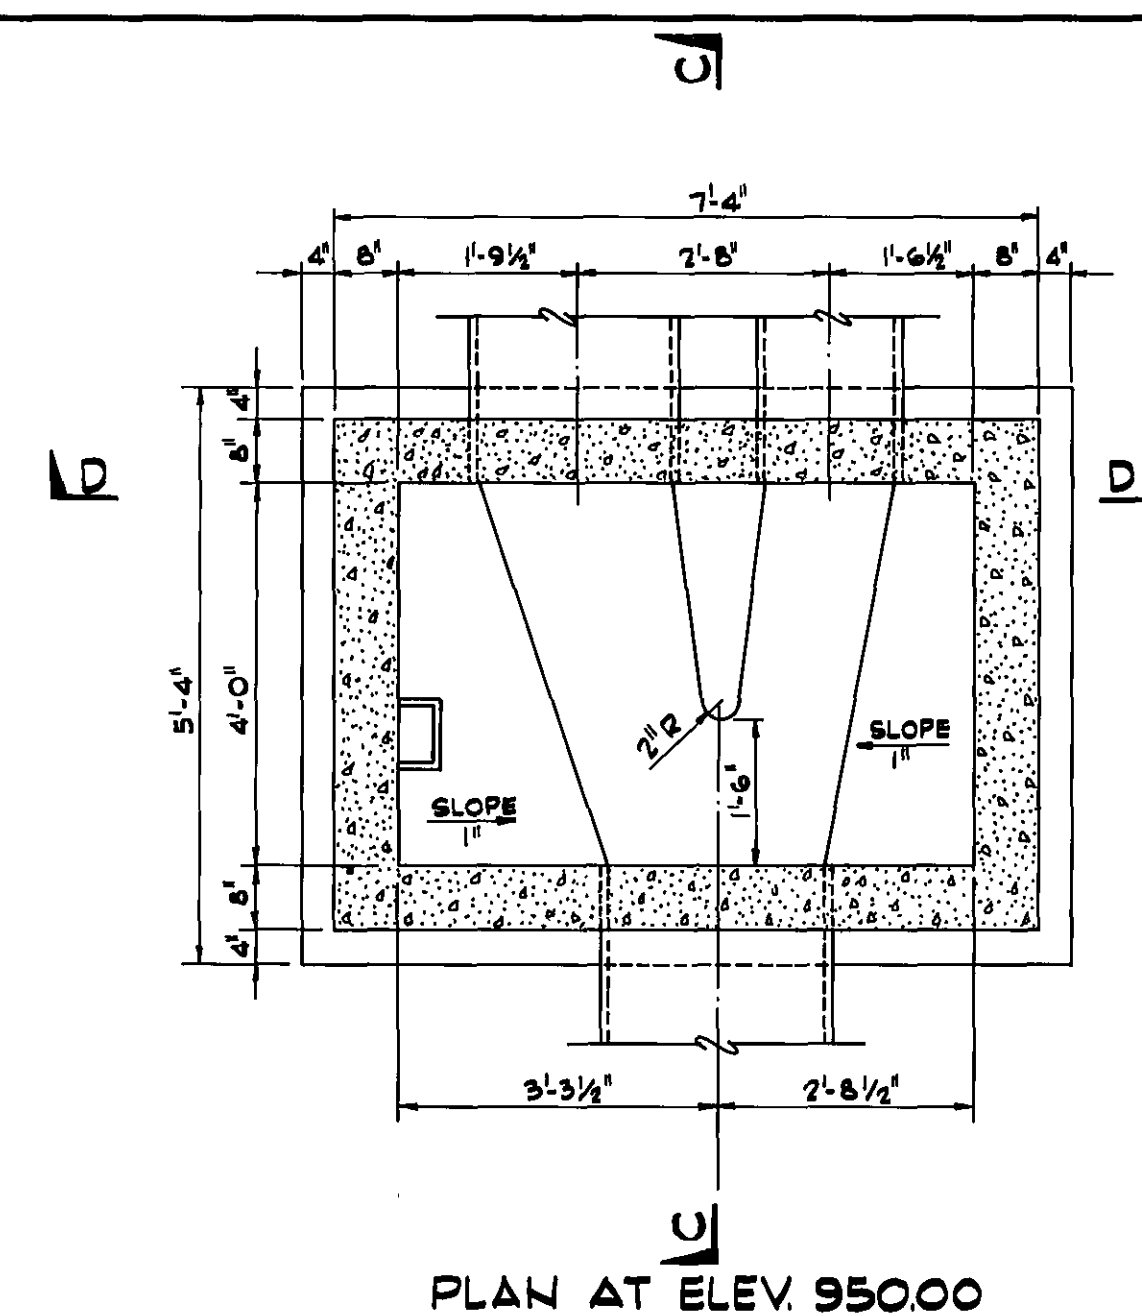
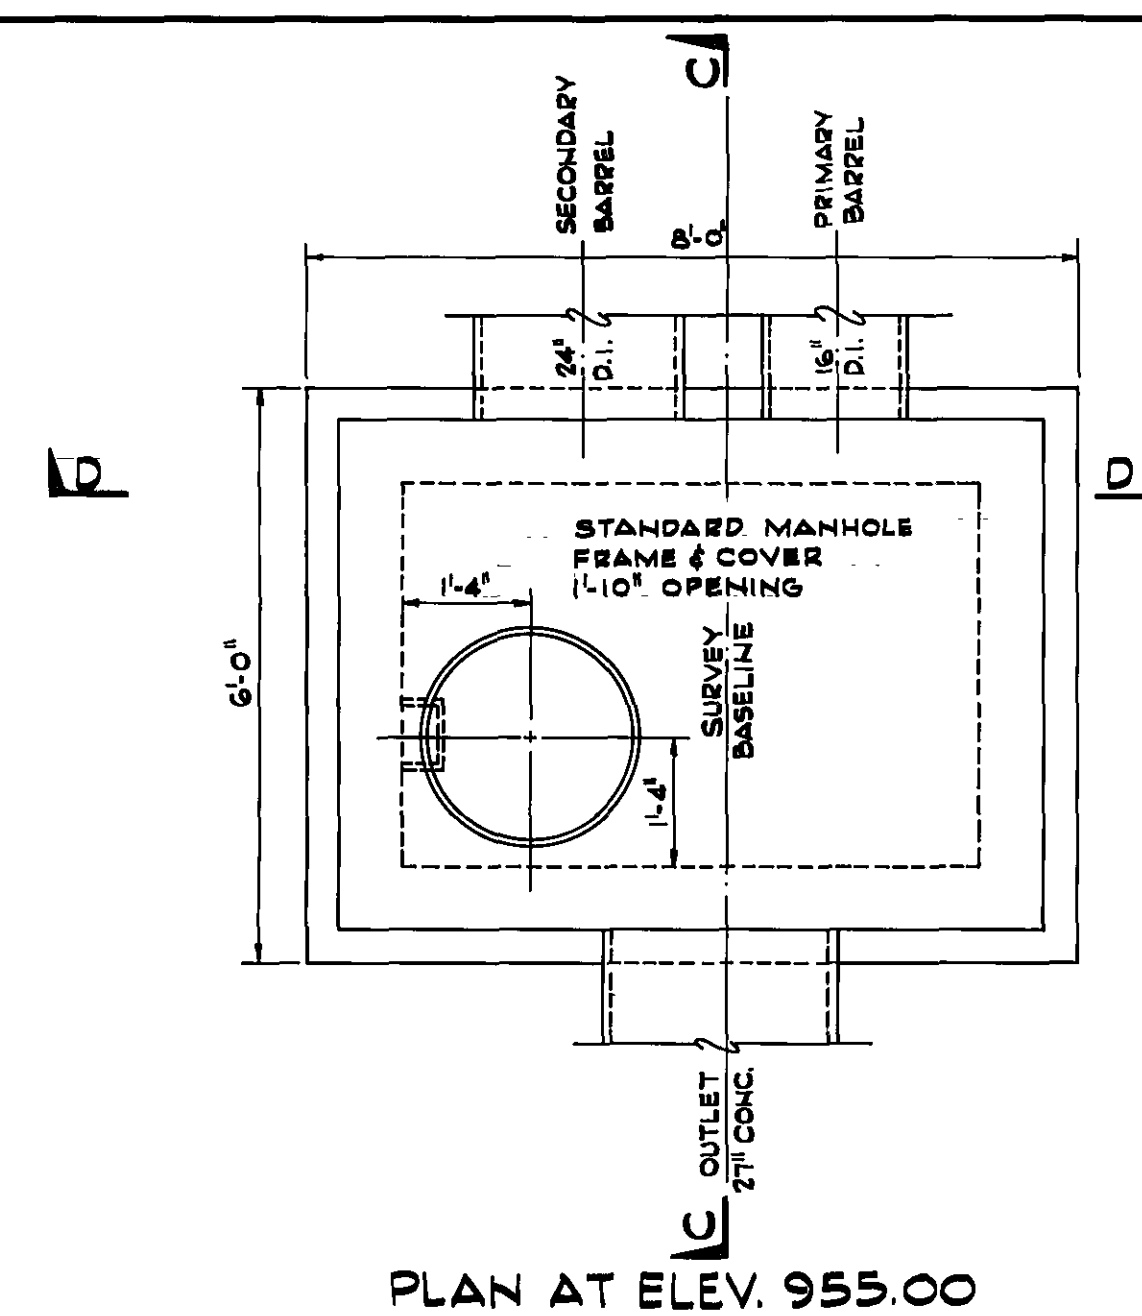
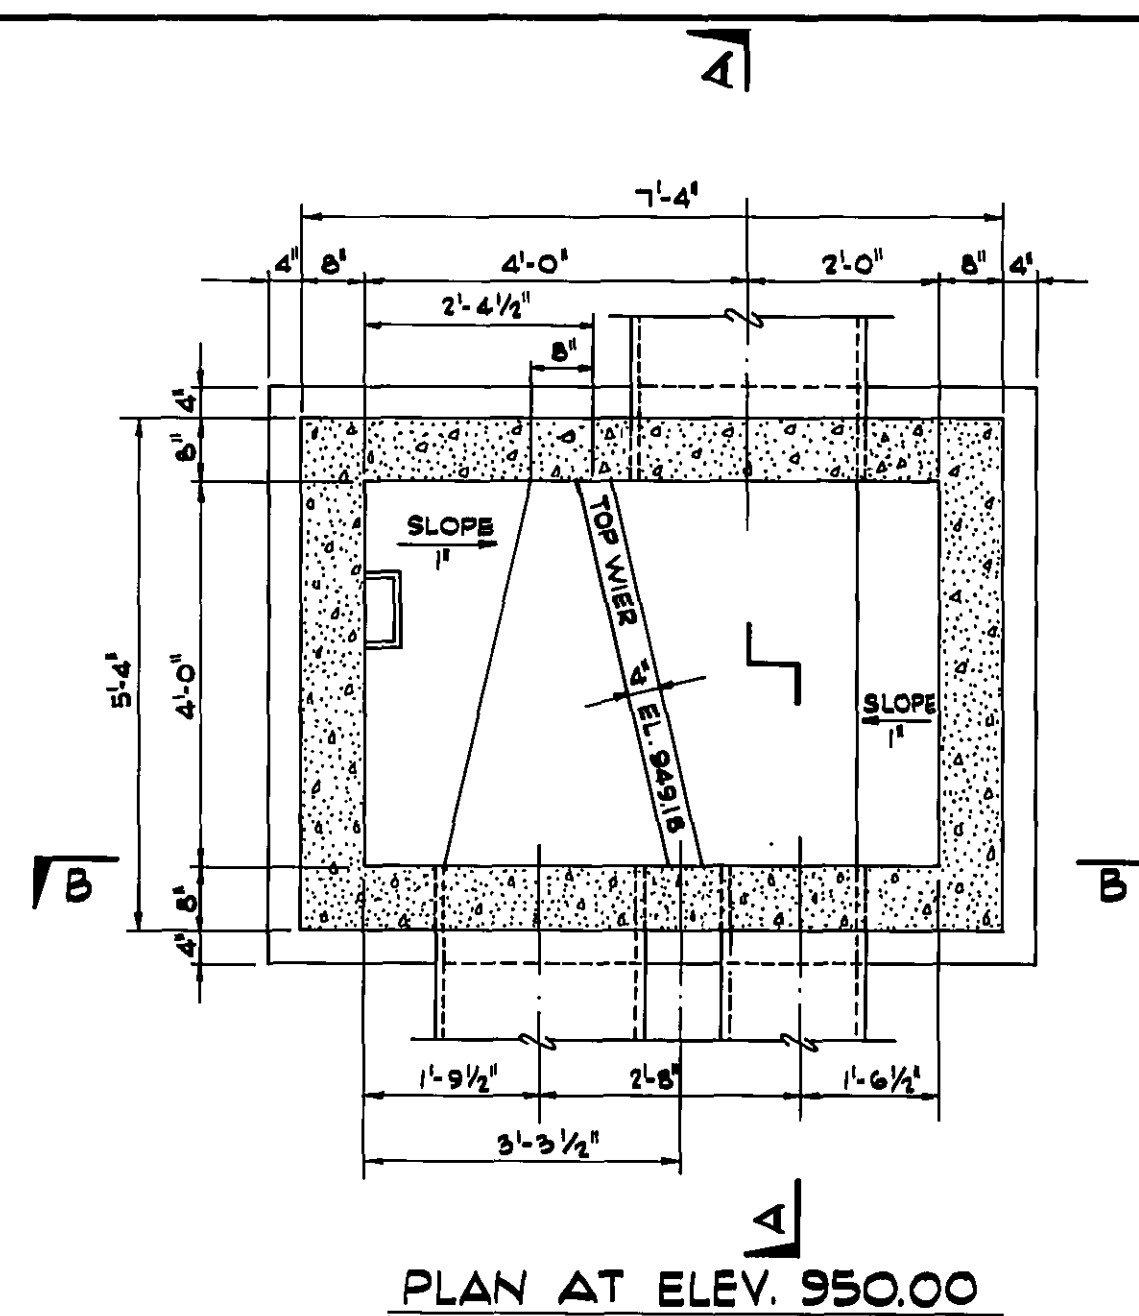
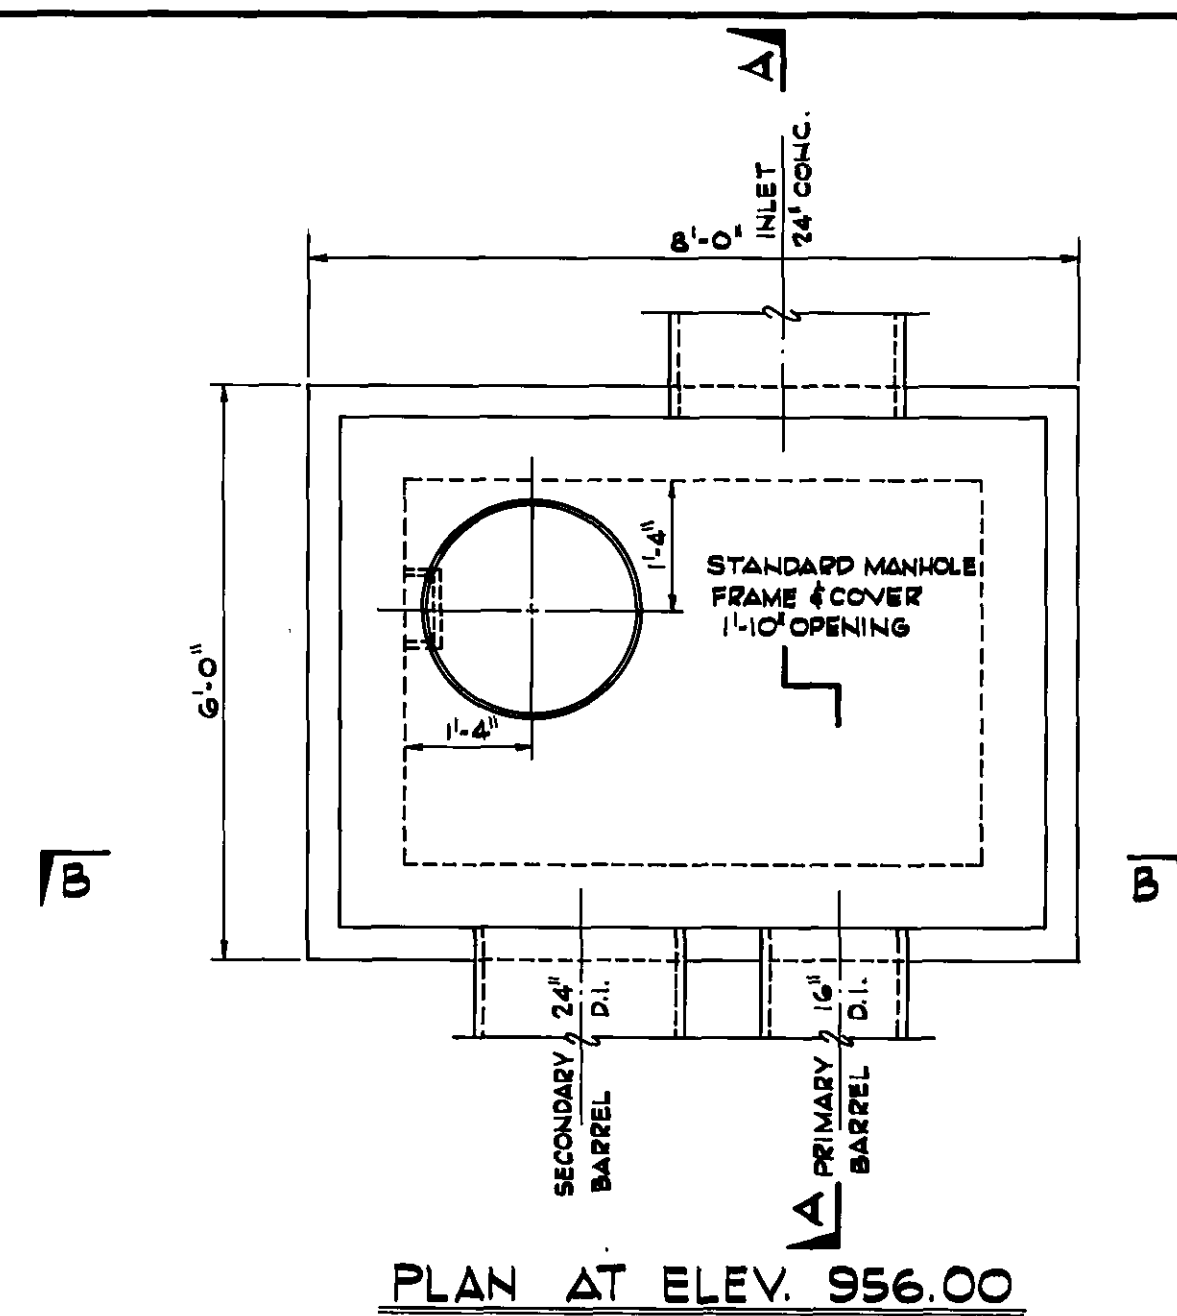


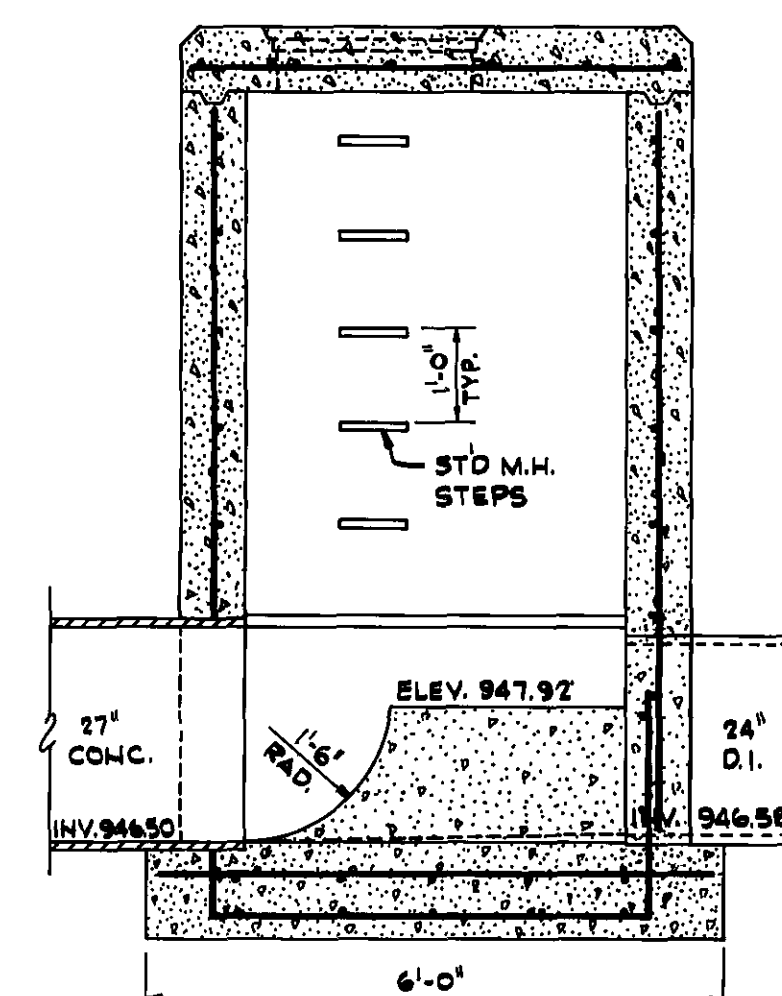

ALL REINF. STEEL
#5 @ 12" @

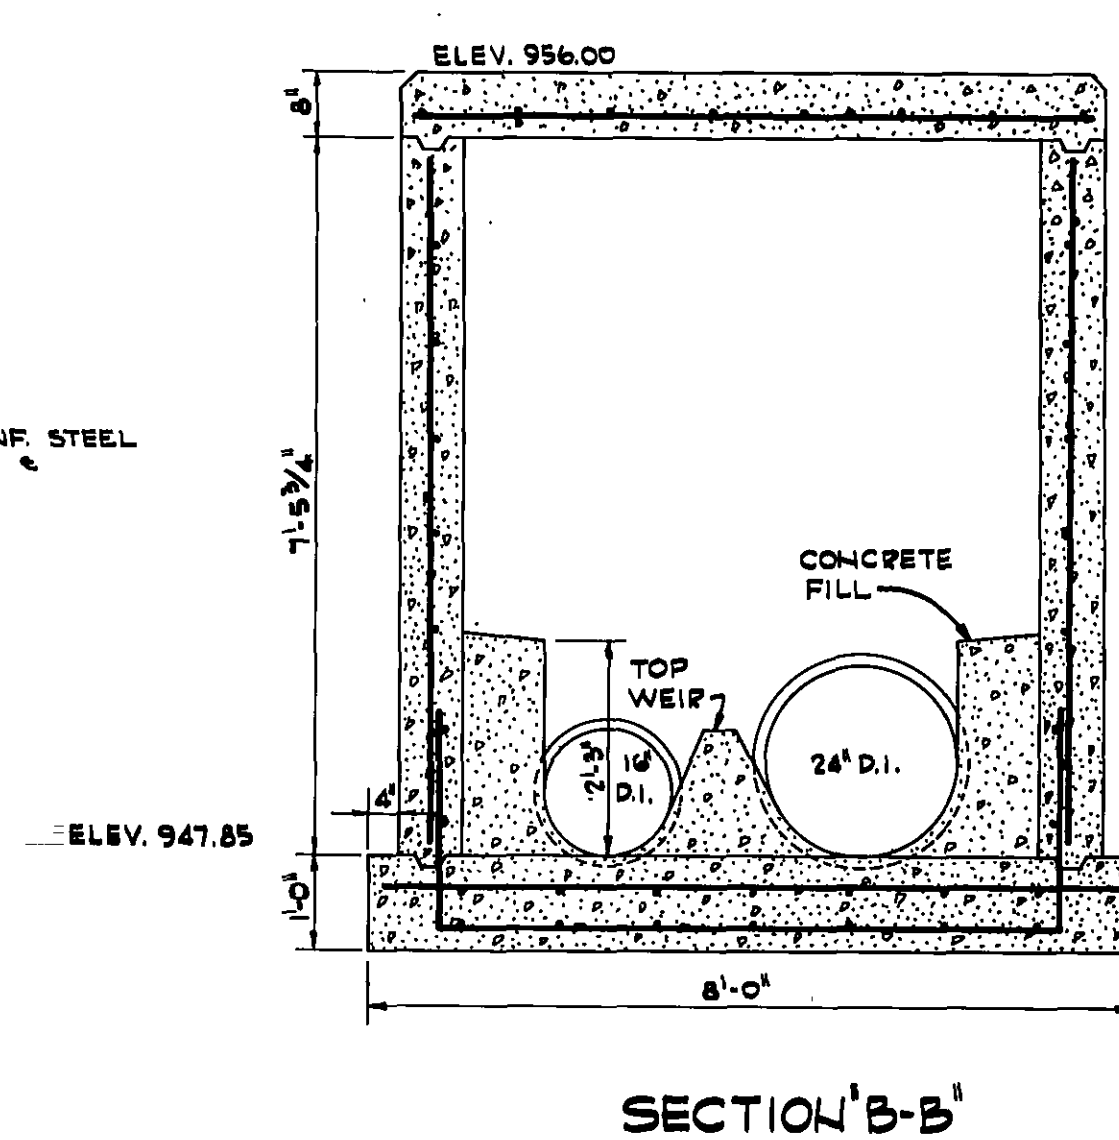

ALL REINF. STEEL
#5 @ 12" @

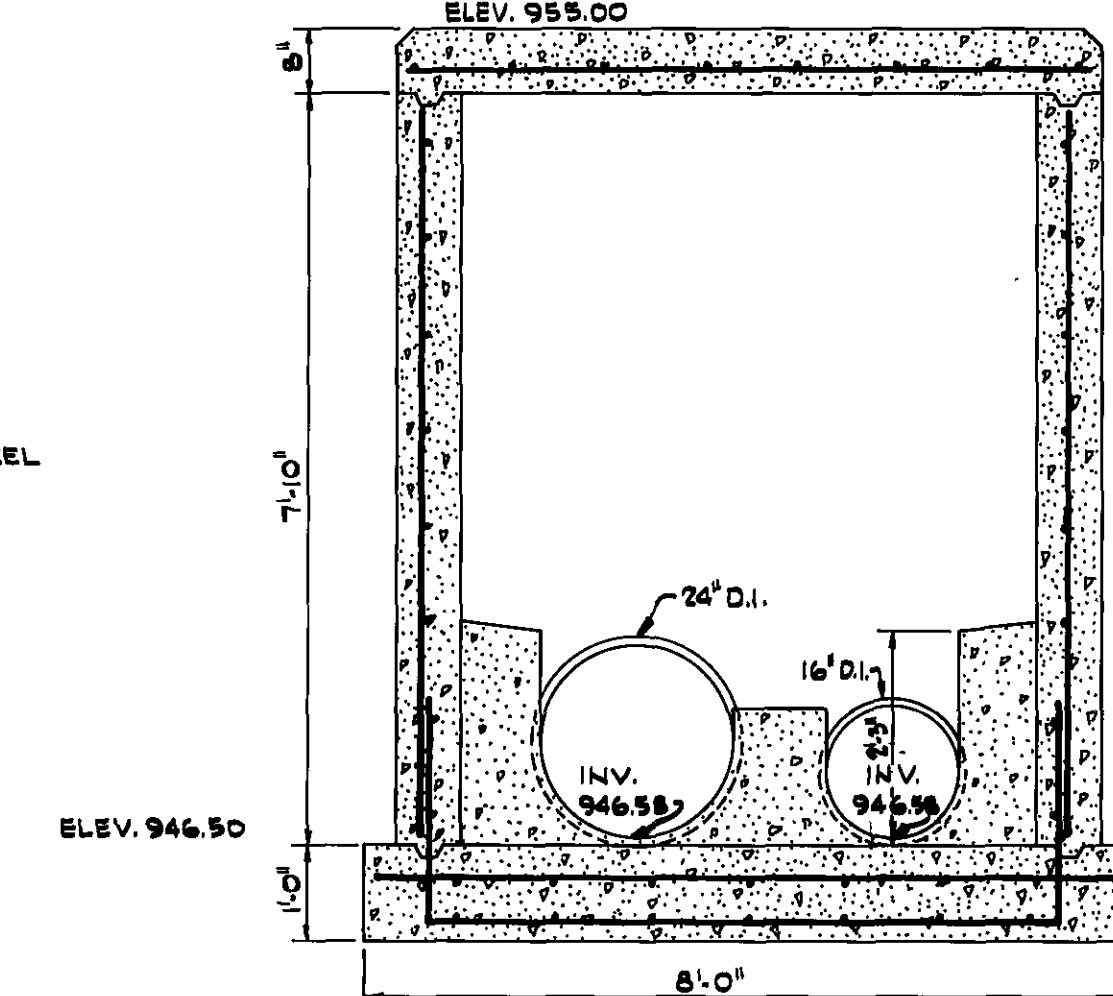

INLET CHAMBER


SCALE: 1/2" = 1'-0"

SECTION C-C


SECTION D-D

OUTLET CHAMBER


SCALE: 1/2" = 1'-0"

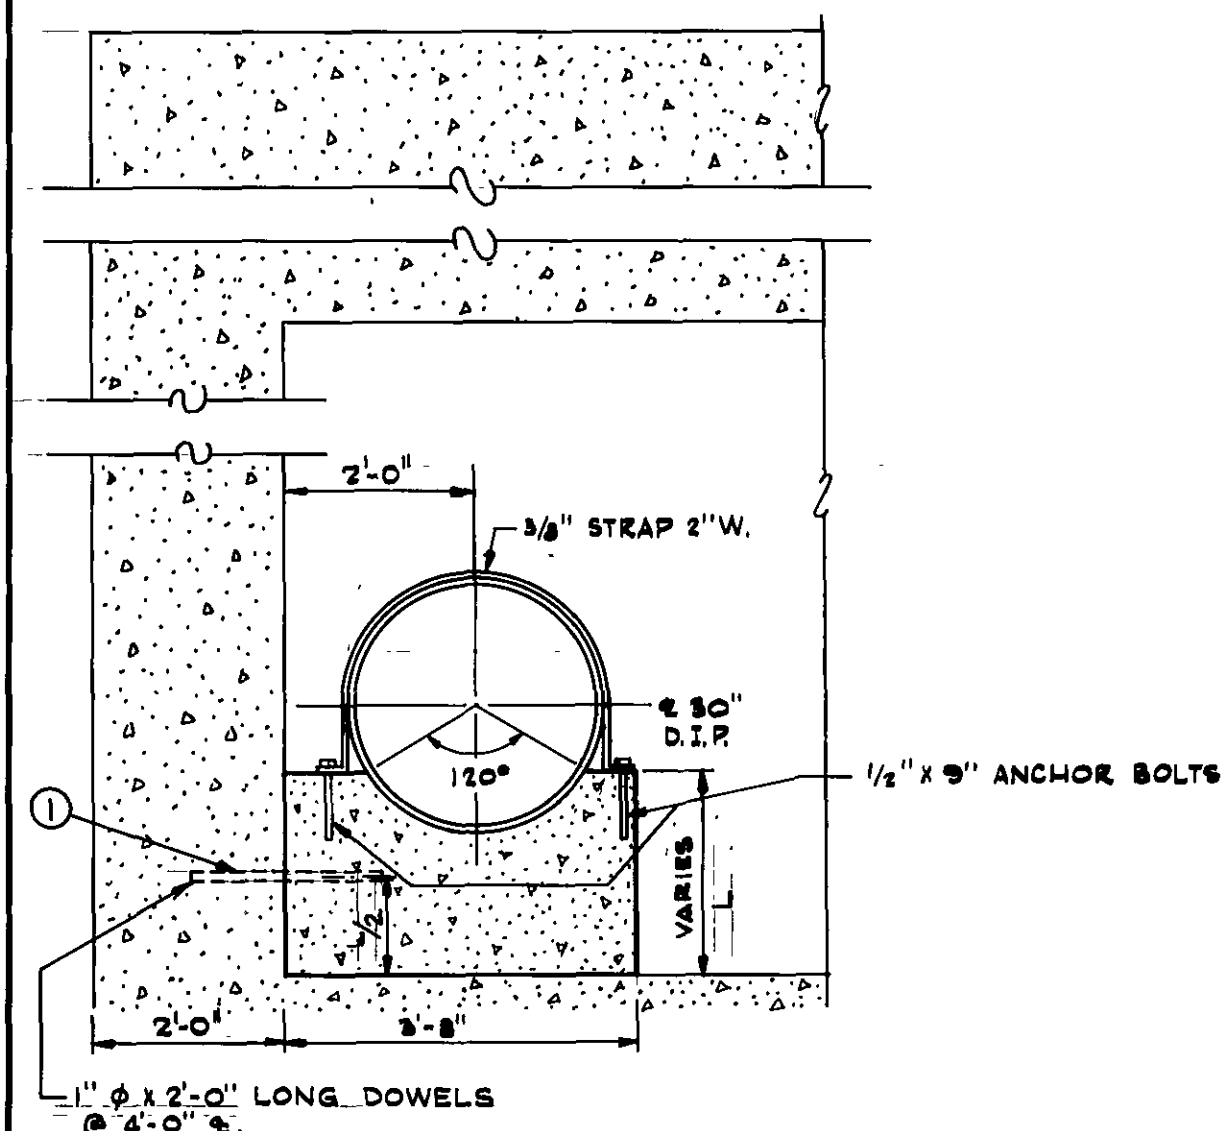

SCALE: 1/2" = 1'-0"

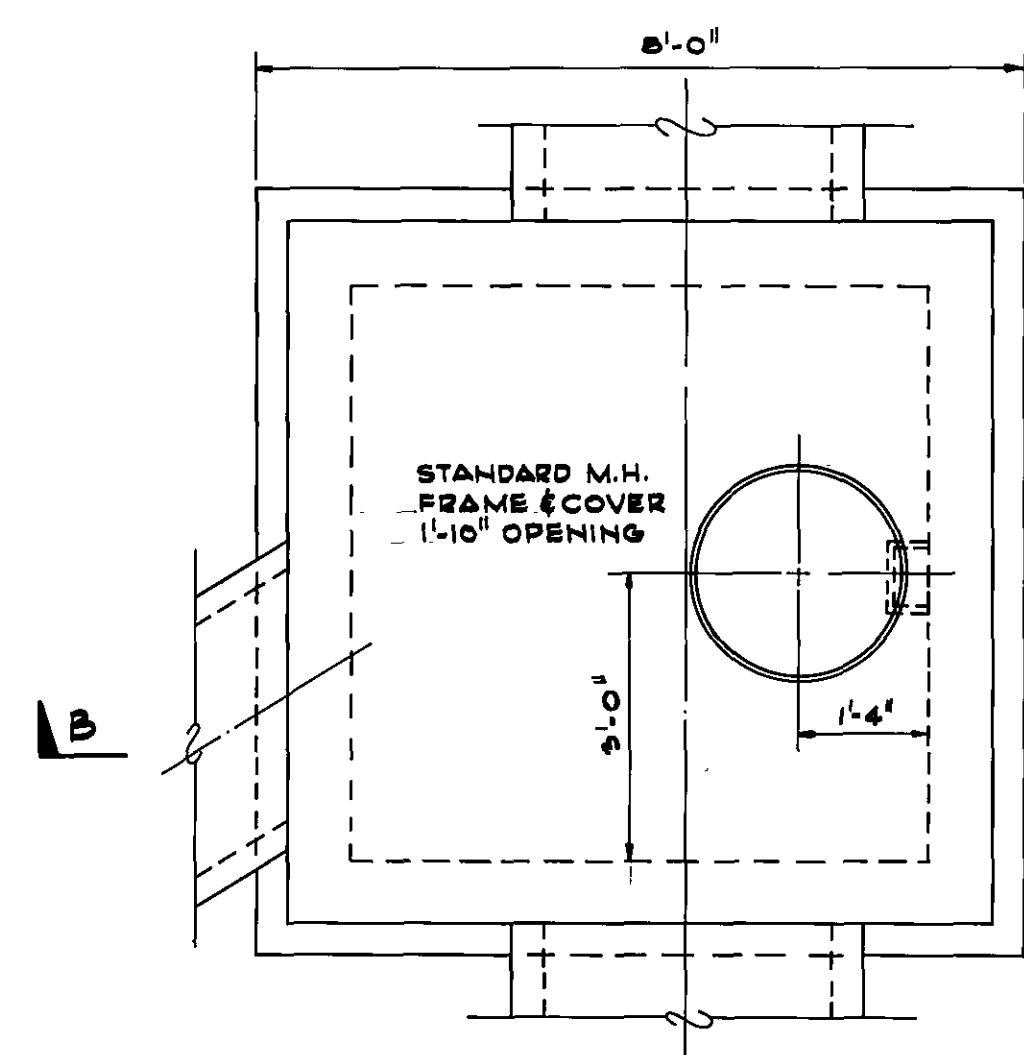


PLAN

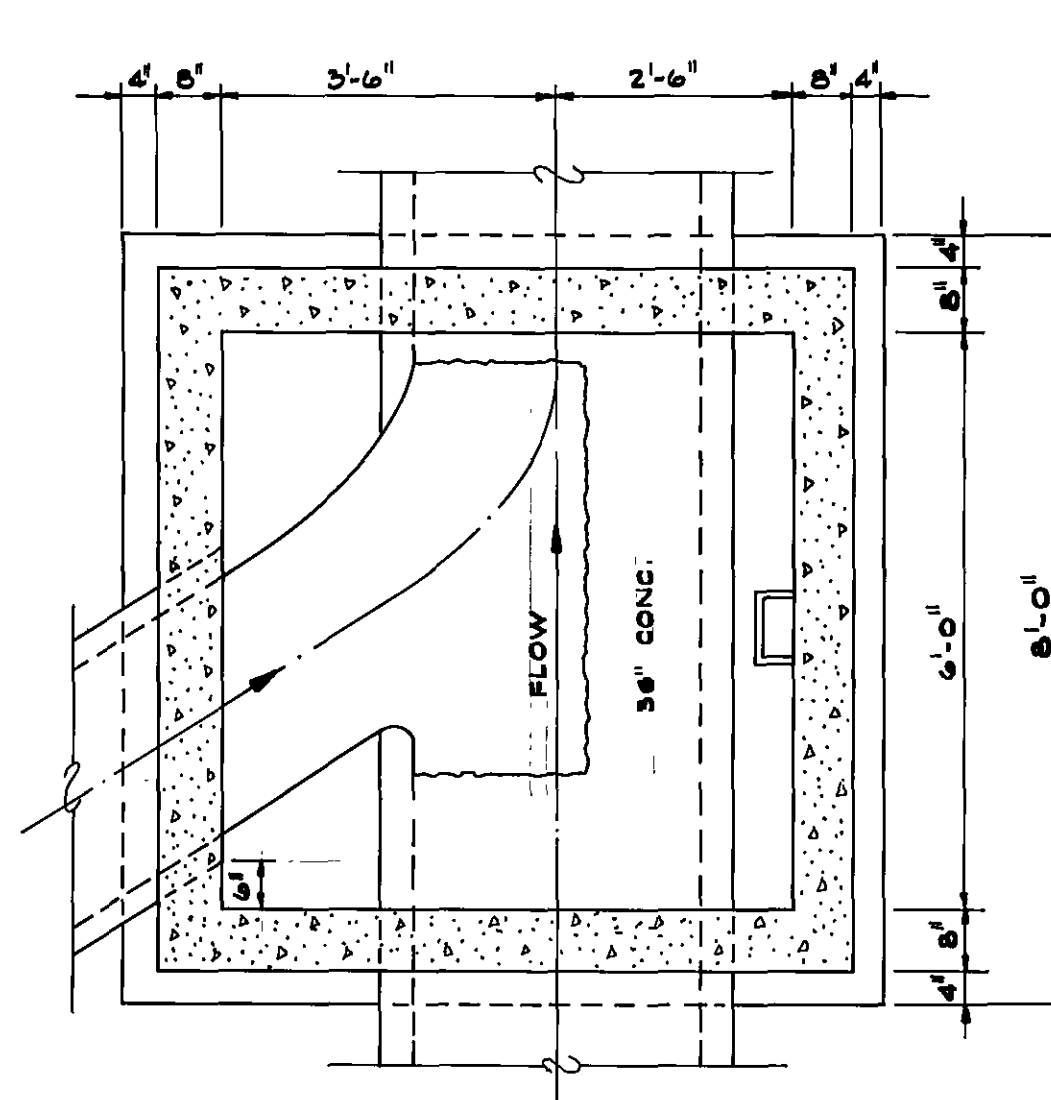

JUNCTION BOX

SCALE: 1/2" = 1'-0"

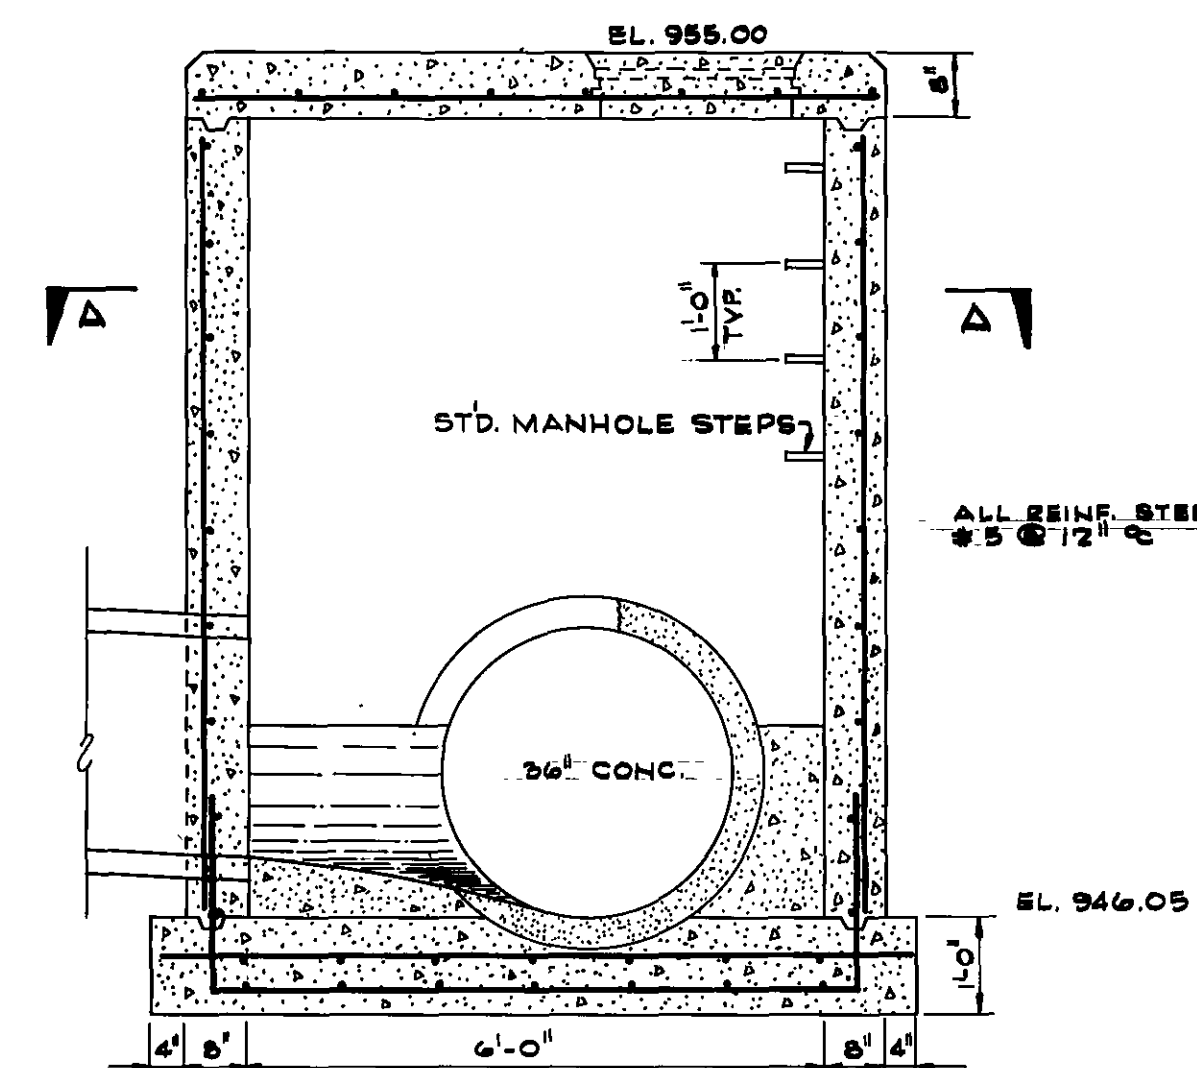

ALL REINF. STEEL
#5 @ 12" @

AS BUILT

REVISION	PIPE SUPPORT DOWELS	12/1/71
DESCRIPTION	DATE	
ROANOKE COUNTY PUBLIC SERVICE AUTHORITY		
ROANOKE COUNTY, VIRGINIA		
SANITARY SEWERAGE SYSTEM		
PETERS CREEK INTERCEPTOR		
PROJECT No. 71-1-S		
DETAILS		
DES: G.E.P.	LANGLEY, McDONALD and OVERMAN	SCALE: AS SHOWN
DR: W.H.C.	CONSULTING ENGINEERS	DATE: 5-20-71
CK: W.E.C.	NORFOLK, VIRGINIA	SHEET 6 OF 7