
WESTERN VIRGINIA WATER AUTHORITY PIEDMONT PARK SANITARY SEWER REPLACEMENT




PREPARED FOR:
WESTERN VIRGINIA WATER AUTHORITY
601 SOUTH JEFFERSON STREET
ROANOKE, VIRGINIA 24011
(540) 853-5700

PREPARED BY:
CHA CONSULTING INC.
1341 RESEARCH CENTER DRIVE
SUITE 2100
BLACKSBURG, VIRGINIA 24060
(540) 552-5548

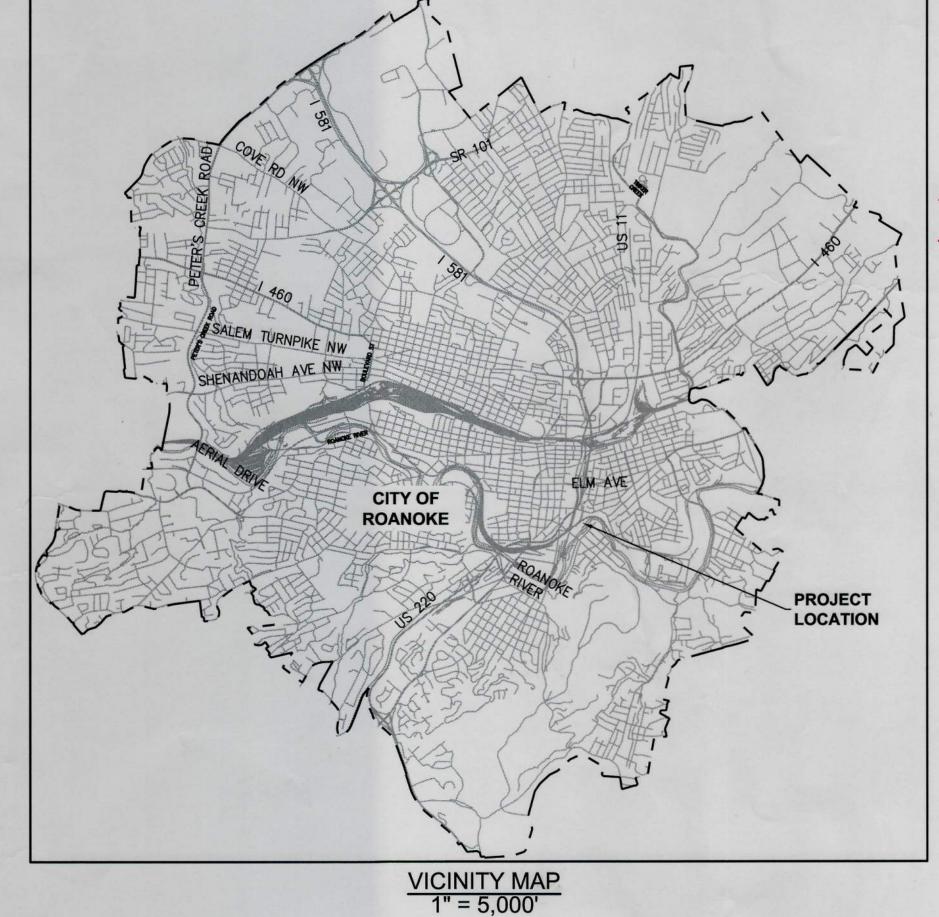


See page (101 For Materials

As builts

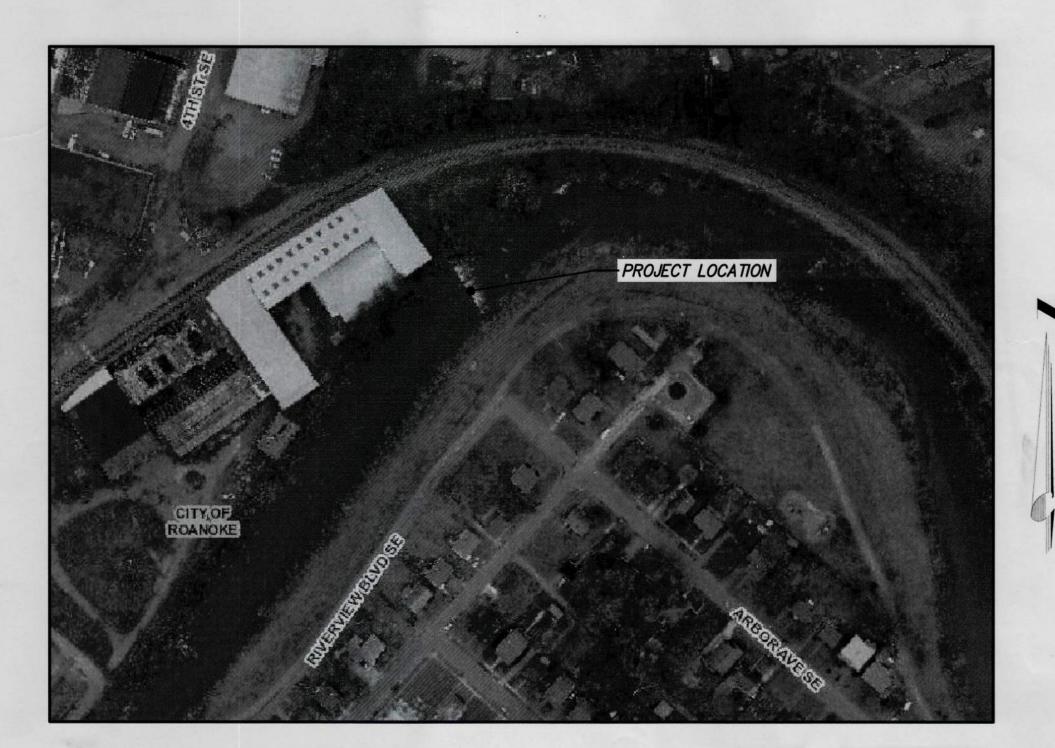

 $\frac{\text{LOCATION MAP}}{1" = 150'}$



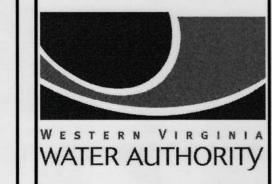



ACTING UNDER THE DIRECTION OF A LICENSED PROFESSIONAL ENGINEER, ARCHITECT, LANDSCAPE ARCHITECT OR LAND SURVEYOR TO ALTER AN ITEM IN ANY WAY, IF AN ITEM BEARING STAMP OF A LICENSED PROFESSIONAL IS ALTERED, THE ALTERIS ENGINEER, ARCHITECT, LANDSCAPE ARCHITECT OR LAND SURVEYOR SHALL STAMP THE DOCUMENT AND INCLUDE THE NOTATION "ALTERED BY" FOLLOWED BY THEIR SIGNATURE, THE DATE OF SUCH ALTERATION, AND A SPECIFIC DESCRIPTION

WESTERN VIRGINIA WATER AUTHORITY

PIEDMONT PARK SANITARY SEWER REPLACEMENT

No.	Submittal / Revision	App'd.	Ву	Date
◬	BIDDING DOCUMENTS	EES	ACW	03/25/2

COVER SHEET

Designed By:	Drawn By:	Checked By
EES	ACW	DBH
Issue Date: 03/25/22	Project No: 65825	

G-001