



SANITARY SEWER SCHEDULE:

- NEW S.S. CLEANOUT
TOP: 916.88
INV. IN: 913.50'
INV. OUT: 913.40'
- 7.5' LF OF 6" SDR-35 PVC PIPE @ 8%
- EX. S.S. MH
EX. RIM: 916.53'
EX. INV. OUT: 911.78'
NEW INV. IN: 912.38'

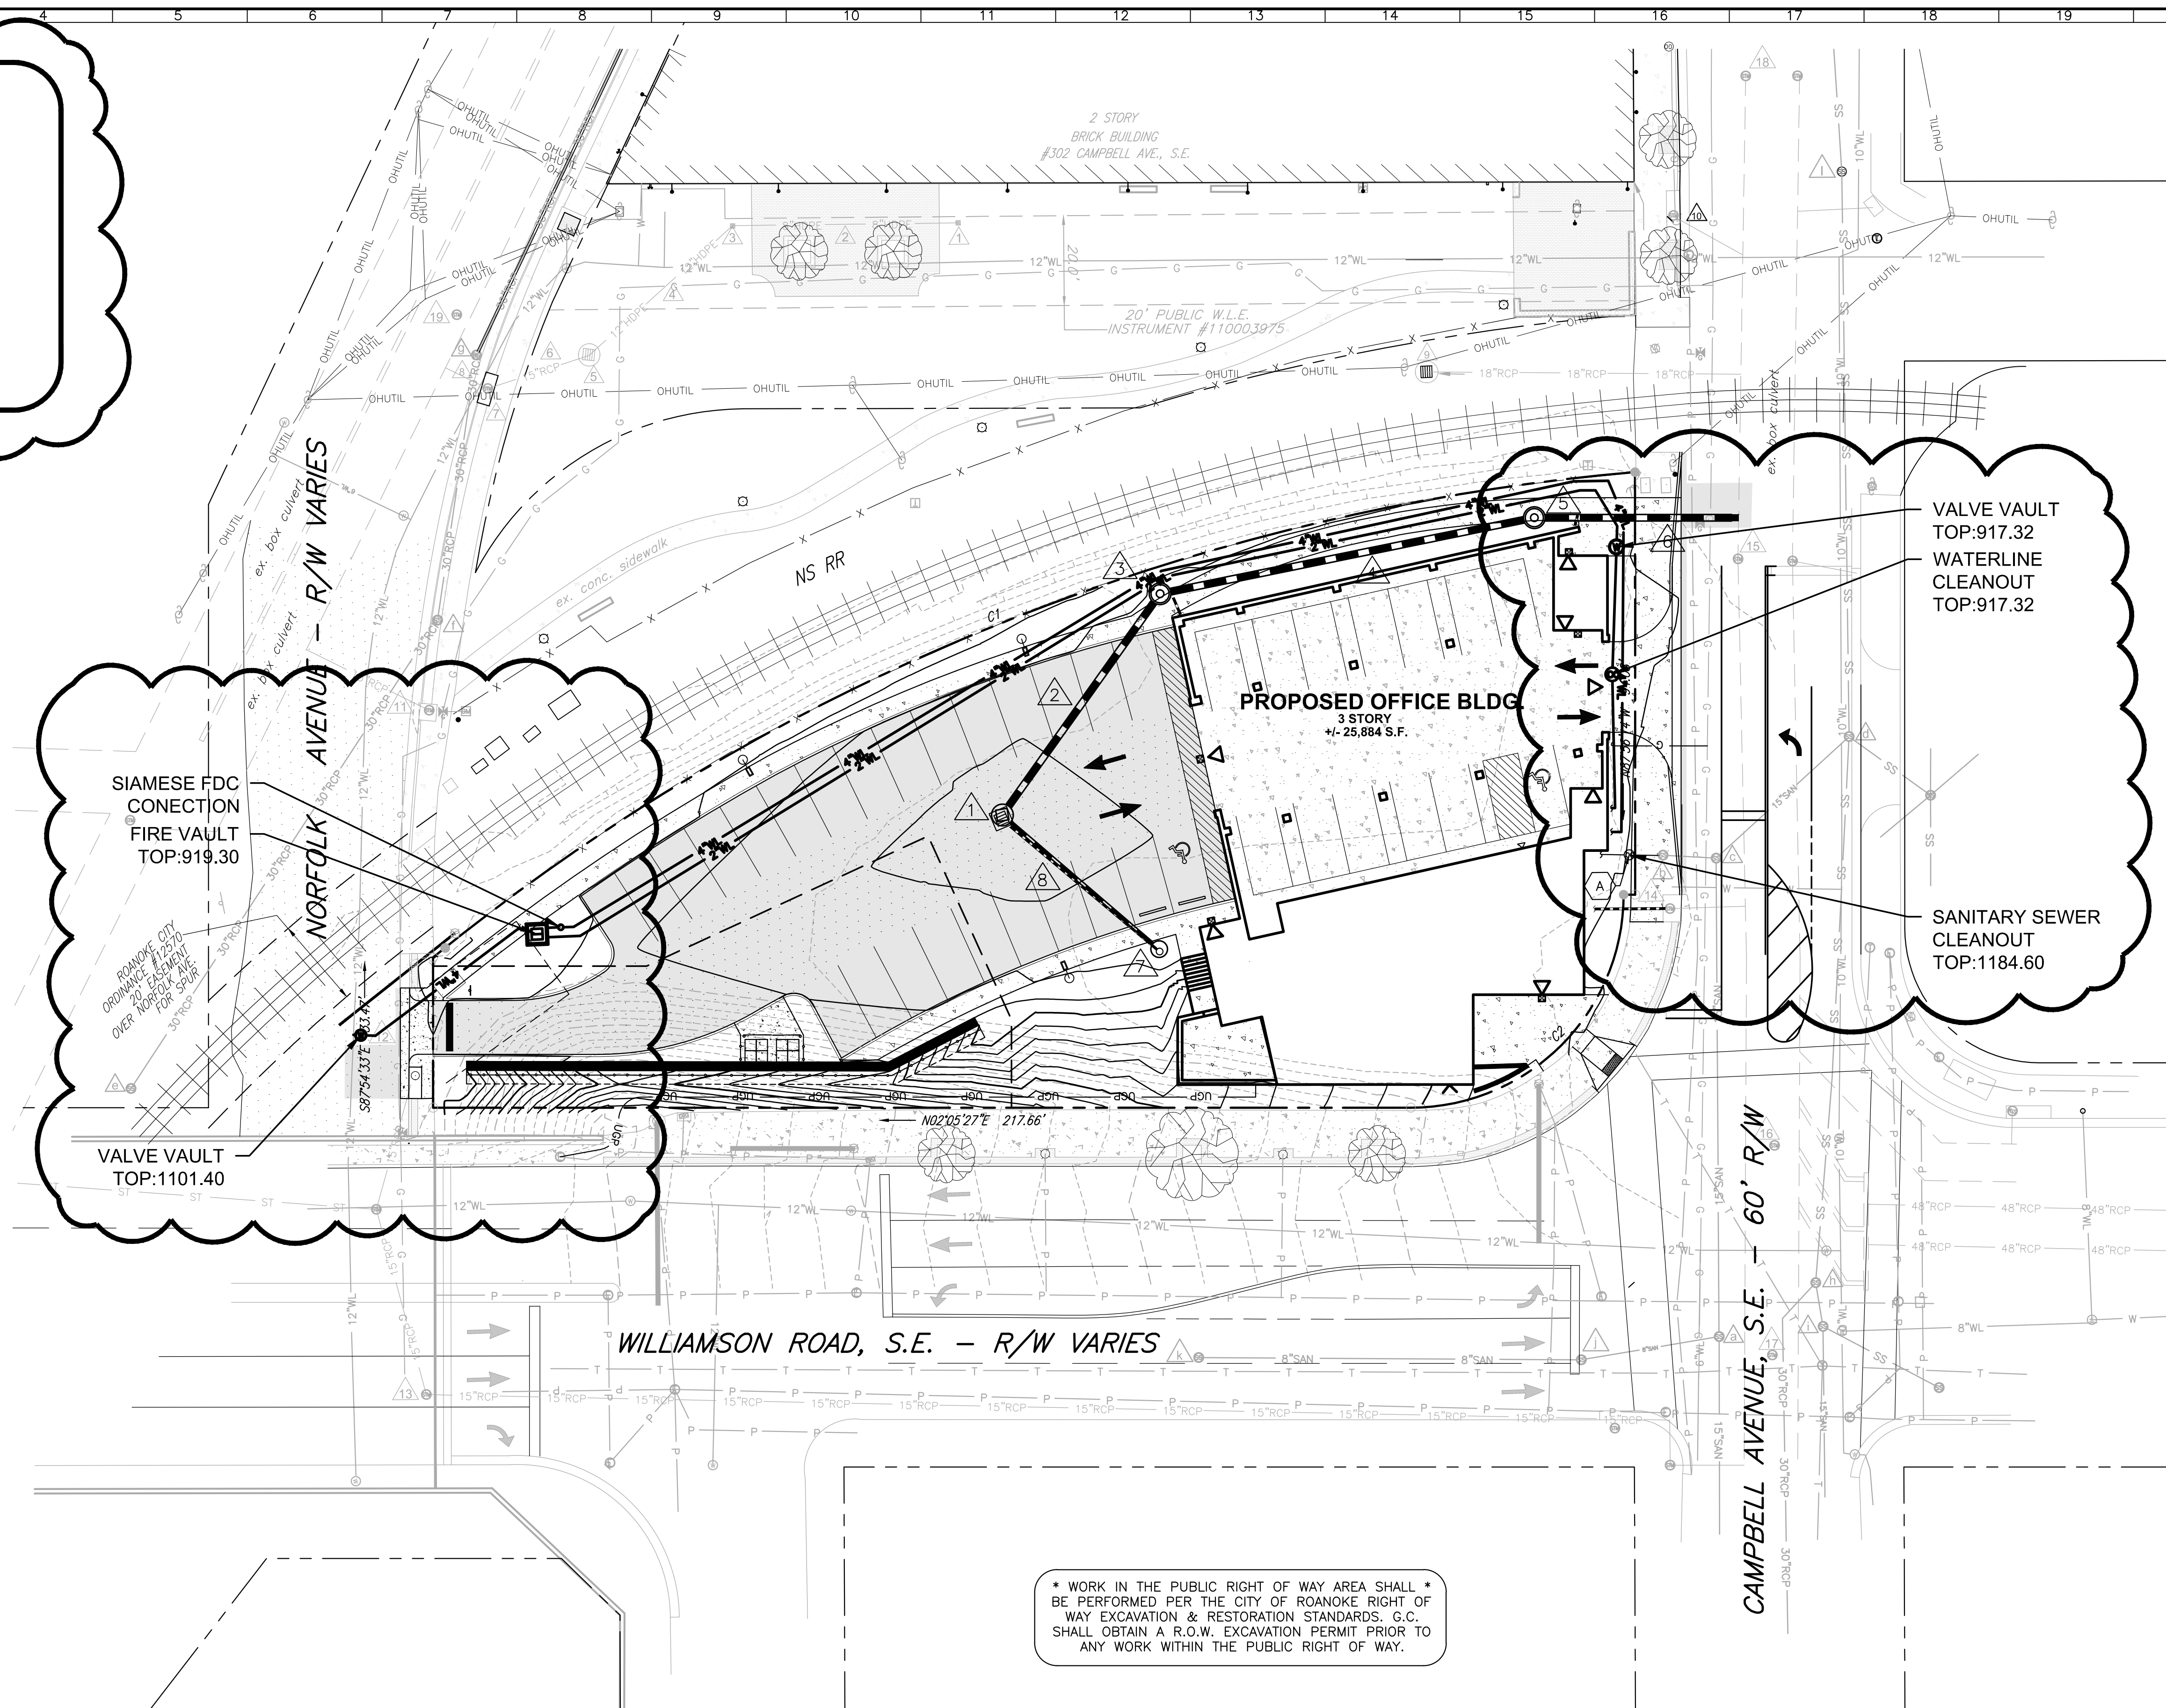

AS-BUILT DRAWING NOTE:
AS-BUILT DRAWING FOR SANITARY SEWER AND WATERLINE IMPROVEMENTS ARE FOR AS-BUILT PURPOSES ONLY. NO IMPROVEMENTS OTHER THAN WATER AND SANITARY SEWER STRUCTURES WERE AS-BUILT OR INDICATED AS SUCH ON THE SUBJECT PLAN SET. UNDERGROUND PIPING WAS NOT LOCATED. LOCATION SHOWN IS APPROXIMATE BASED ON SURFACE FEATURES AND INFORMATION PROVIDED BY CONTRACTOR.

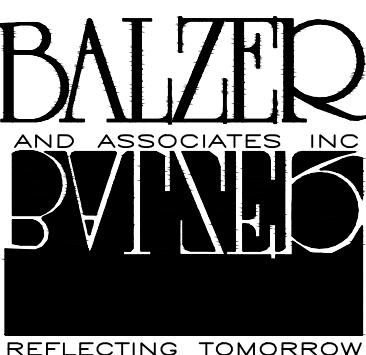


REFLECTING TOMORROW
www.balzer.cc

Roanoke
New River Valley
Richmond
Staunton
Harrisonburg

RESIDENTIAL LAND DEVELOPMENT ENGINEERING
SITE DEVELOPMENT ENGINEERING
LAND USE PLANNING & ZONING
LANDSCAPE ARCHITECTURE
LAND SURVEYING
ARCHITECTURE
STRUCTURAL ENGINEERING
TRANSPORTATION ENGINEERING
ENVIRONMENTAL & SOIL SCIENCE
WETLAND DELINEATIONS & STREAM EVALUATIONS

Balzer and Associates, Inc.

1208 Corporate Circle
Roanoke, VA 24018
540-772-9580
FAX 540-772-8050

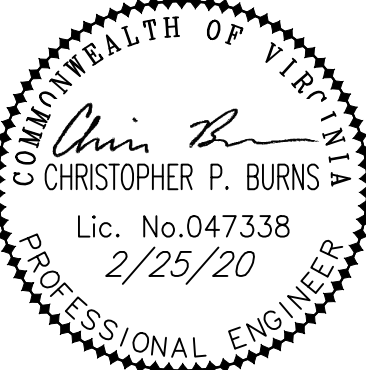

PINNACLE BANK CORPORATE
202 CAMPBELL AVE SOUTHEAST
PUBLIC WATER & SANITARY SEWER AS-BUILT
CITY OF ROANOKE, VIRGINIA

DRAWN BY EJP
DESIGNED BY BTC
CHECKED BY BTC
DATE 2/25/2020
SCALE 1"=20'
REVISIONS:

SHEET NO.
AS-BUILT
JOB NO. 03180055.00