


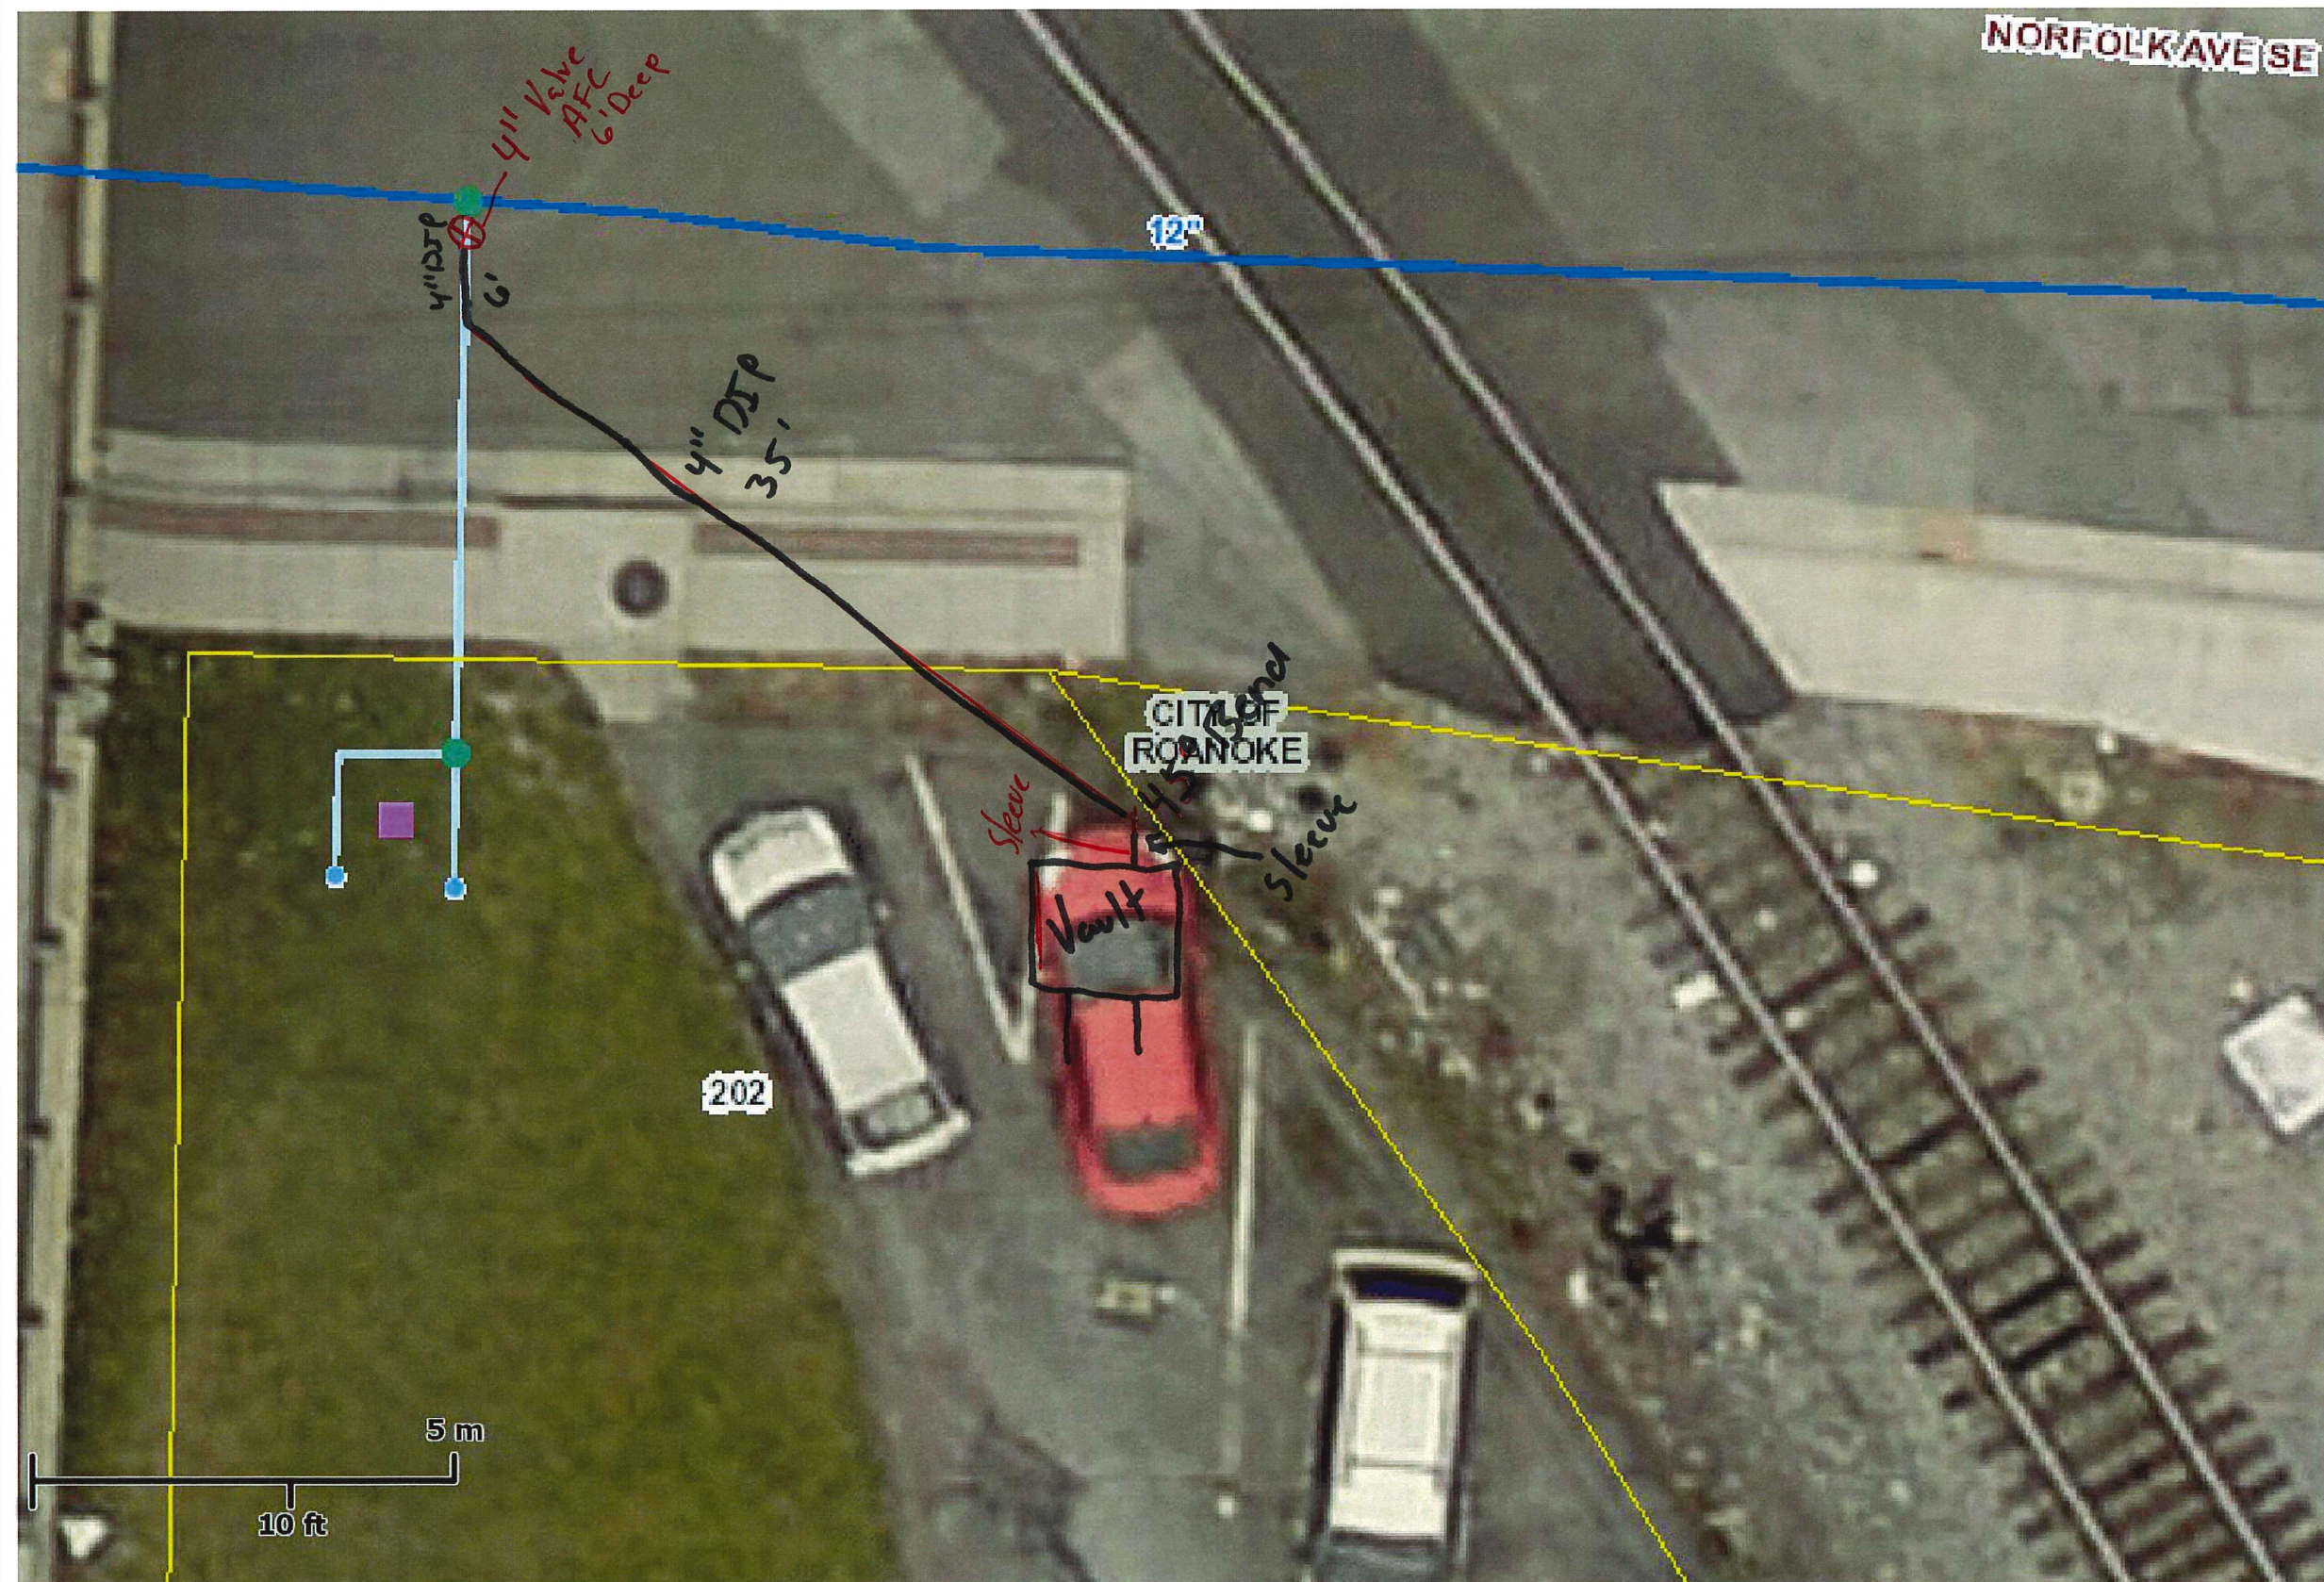

Pinnacle BANK
202 Campbell Ave
SE
As-built
www
Brian Whitnack
Contractor
J.B. Plumbing