




I-7 to I-9 PROFILE  
Scale-Horizontal: 1" = 40'  
Vertical: 1" = 10'

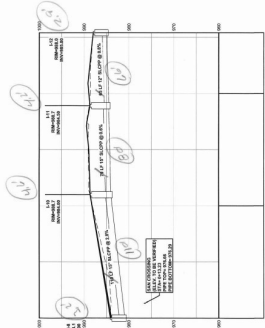


I-8 to I-12 PROFILE  
Scale-Horizontal: 1" = 40'  
Vertical: 1" = 10'

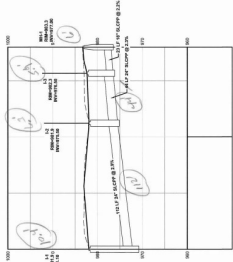


I-1 to MH-1 PROFILE  
Scale-Horizontal: 1" = 40'  
Vertical: 1" = 10'

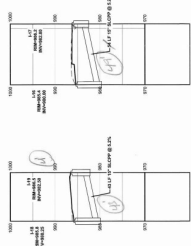


I-18 to I-19 PROFILE  
Scale-Horizontal: 1" = 40'  
Vertical: 1" = 10'

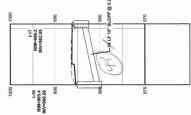


I-18 to I-17 PROFILE  
Scale-Horizontal: 1" = 40'  
Vertical: 1" = 10'

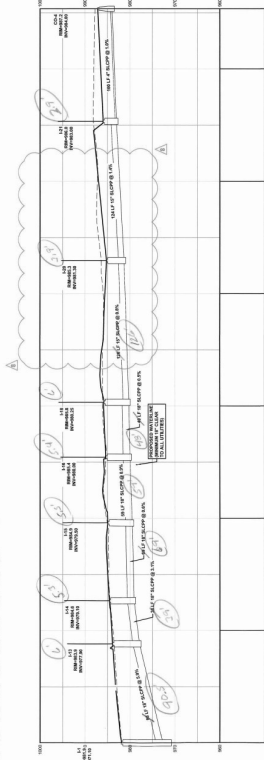


I-1 to CO-4 PROFILE  
Scale-Horizontal: 1" = 40'  
Vertical: 1" = 10'

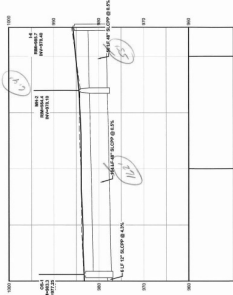


PCSM FACILITY (MH-1 TO I-8) PROFILE  
Scale-Horizontal: 1" = 40'  
Vertical: 1" = 10'

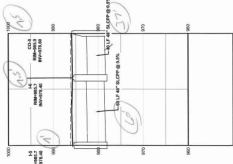


PCSM FACILITY (I-5 to CO-9) PROFILE  
Scale-Horizontal: 1" = 40'  
Vertical: 1" = 10'

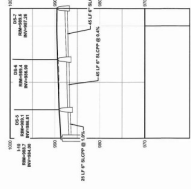


I-1 to DS-2 PROFILE  
Scale-Horizontal: 1" = 40'  
Vertical: 1" = 10'

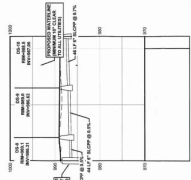


I-1 to DS-4 PROFILE  
Scale-Horizontal: 1" = 40'  
Vertical: 1" = 10'

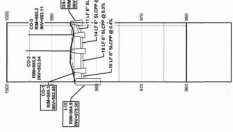


I-1 to DS-2 PROFILE  
Scale-Horizontal: 1" = 40'  
Vertical: 1" = 10'

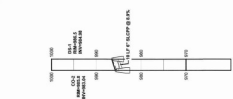

CO-9 to DS-1 PROFILE  
Scale-Horizontal: 1" = 40'  
Vertical: 1" = 10'

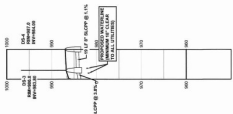

WVE to DS-1 PROFILE  
Scale-Horizontal: 1" = 40'  
Vertical: 1" = 10'

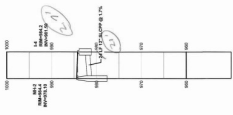

MH-3 to I-8 PROFILE  
Scale-Horizontal: 1" = 40'  
Vertical: 1" = 10'

ISSUED FOR CONSTRUCTION



Prepared For  
Terminal Leasing, Inc.  
10000 Terminal Blvd.  
Philadelphia, PA 19122

811  
Call before you dig.  
Call 800-4-A-DIG or visit  
www.811.com

DATE ISSUED: 01/17/2022  
DRAWN BY: J. L. BROWN  
CHECKED BY: J. L. BROWN  
APPROVED BY: J. L. BROWN

PROJECT NO.: 202100471  
SHEET NO.: 10 OF 10

PROJECT NAME: PITT OHIO-ROANOKE  
COMMERCIAL LAND DEVELOPMENT

PROJECT LOCATION: City of Roanoke, Virginia

PROJECT NO.: 202100471  
SHEET NO.: 10 OF 10

PROJECT NAME: PITT OHIO-ROANOKE  
COMMERCIAL LAND DEVELOPMENT

PROJECT LOCATION: City of Roanoke, Virginia

PROJECT NO.: 202100471  
SHEET NO.: 10 OF 10