


SANITARY SEWER STRUCTURE INFO

SSM#1	SSM#2	SSM#3	SSM#4	SSM#5	SSM#6
TOP = 864.40'	TOP = 864.40'	TOP = 864.40'	TOP = 864.40'	TOP = 864.40'	TOP = 864.40'
AVN F.T.C. = 878.67'	AVN F.T.C. = 878.67'	AVN F.T.C. = 878.67'	AVN F.T.C. = 878.67'	AVN F.T.C. = 878.67'	AVN F.T.C. = 878.67'
AVN F.T.C. = 878.67'	AVN F.T.C. = 878.67'	AVN F.T.C. = 878.67'	AVN F.T.C. = 878.67'	AVN F.T.C. = 878.67'	AVN F.T.C. = 878.67'
ITEM	DATE	BY	CHKD	APP'D
1	08/15/2021	JAC	JAC	JAC
2	08/15/2021	JAC	JAC	JAC
3	08/15/2021	JAC	JAC	JAC
4	08/15/2021	JAC	JAC	JAC
5	08/15/2021	JAC	JAC	JAC
6	08/15/2021	JAC	JAC	JAC
7	08/15/2021	JAC	JAC	JAC
8	08/15/2021	JAC	JAC	JAC
9	08/15/2021	JAC	JAC	JAC
10	08/15/2021	JAC	JAC	JAC

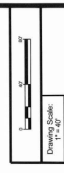

ISSUED FOR CONSTRUCTION



Terminal Leasing, Inc.
Pittsburgh, PA 15222

811
Call before you dig.
1-800-4-A-DIG

DATE ISSUED: 08/15/2021
DATE: 08/15/2021

PROJECT NAME: PITT OHIO-ROANOKE
COMMERCIAL LAND DEVELOPMENT

DRAWING NAME: SANITARY SEWER PLAN
PROJECT NO: 202100471
DRAWING NO: C-600

STATE: VA
CITY: Roanoke

DATE: 08/15/2021
SCALE: 1" = 40'

