



VIRGINIA STATE PLANE - NAD83
SOUTH ZONE - GRID NORTH

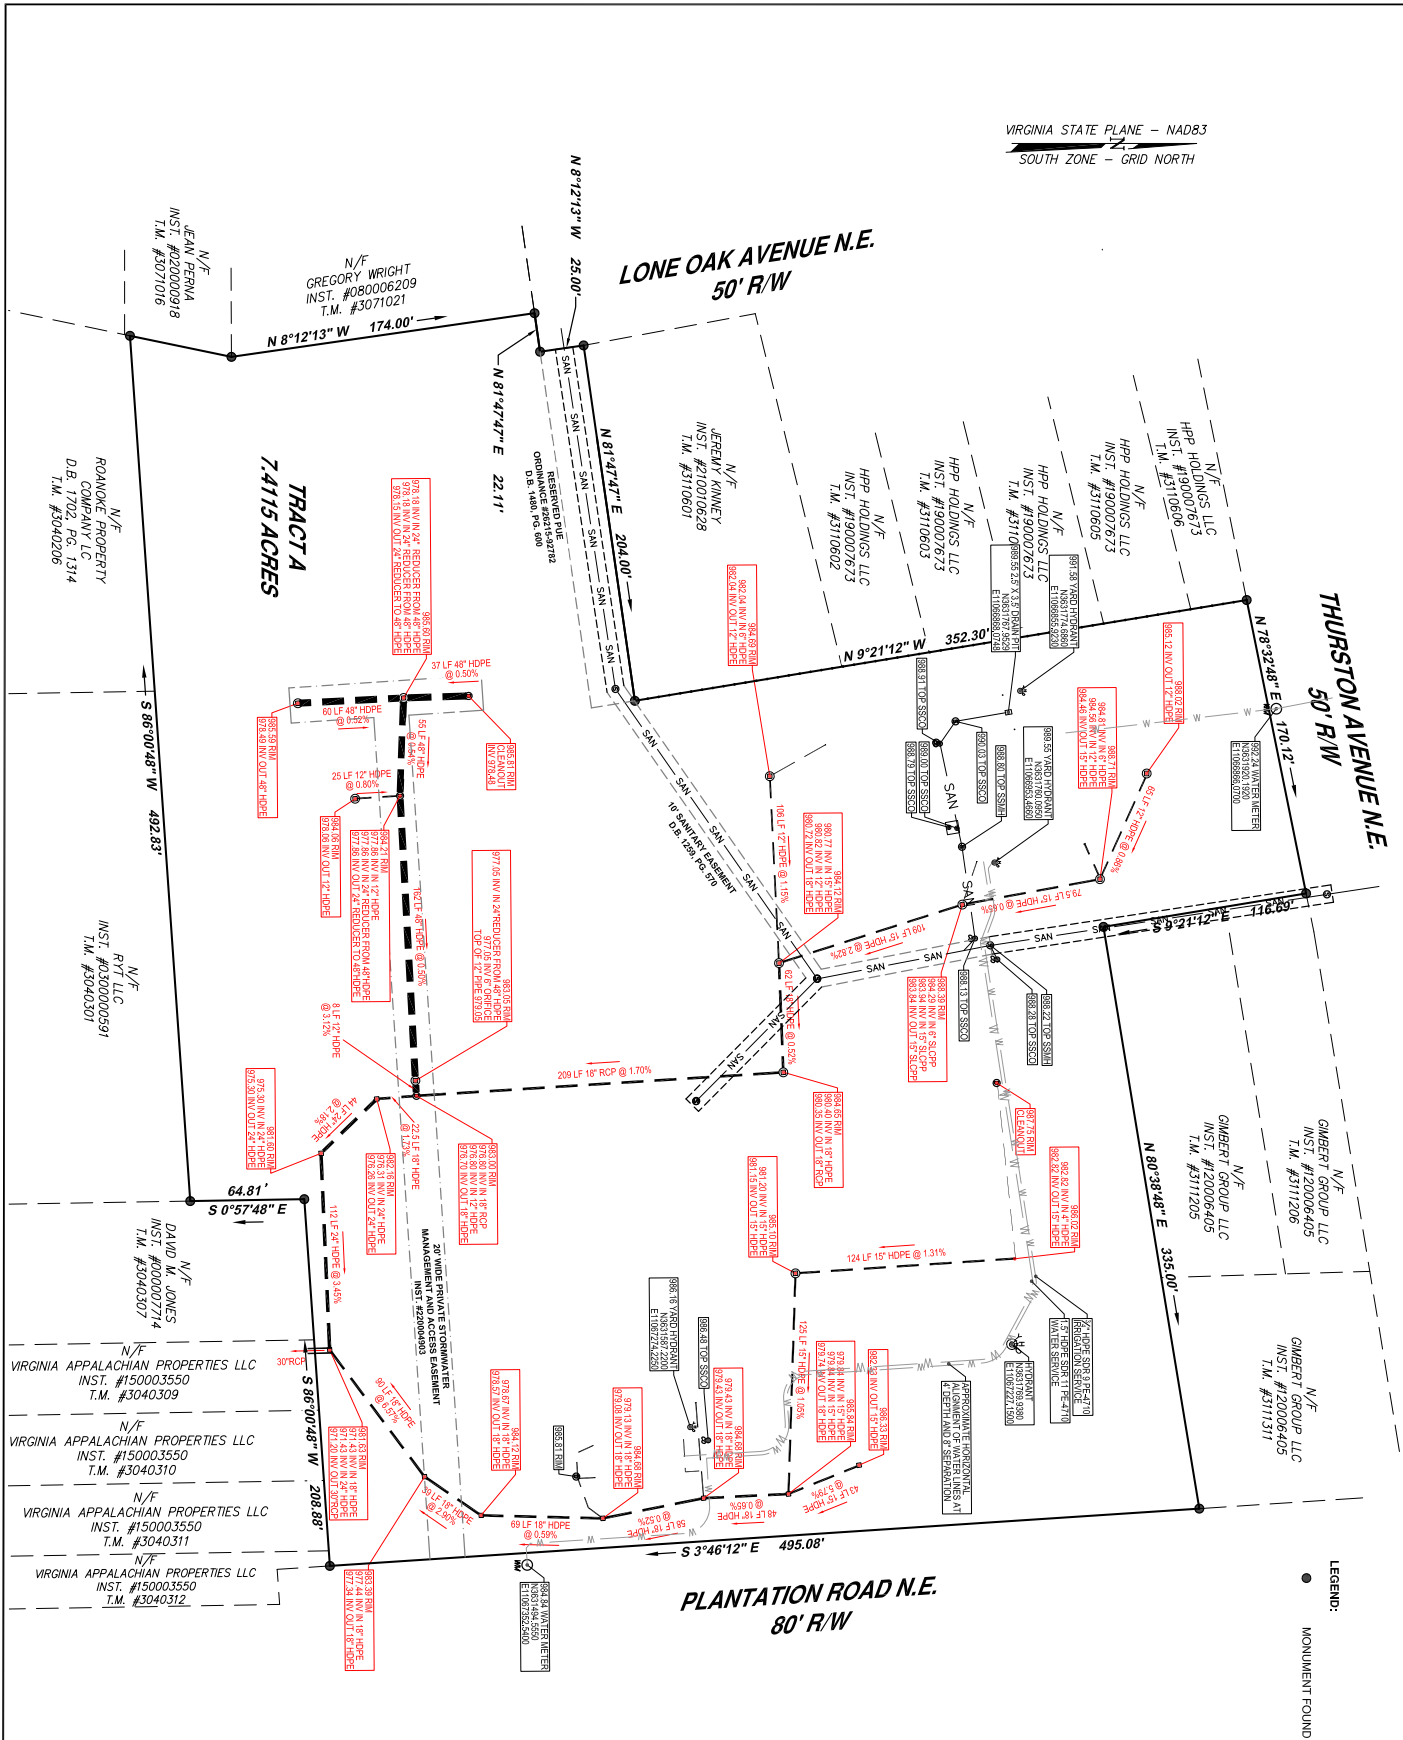

REVISIONS	
09-21-23	
CALCS BY:	SCB
DRAWN BY:	JAZ
CHECKED BY:	SCB
SCALE:	1" = 50'
DATE:	DEC. 14, 2022
PROJECT NUMBER:	21-0226:05
SHEET NO.:	

UTILITY AS-BUILT SURVEY FOR
TERMINAL LEASING INC.
SHOWING TRACT A - 7.4115 ACRES
INSTRUMENT #220004903
SITUATED ALONG PLANTATION ROAD,
THURSTON AVE. AND LONE OAK AVE.
CITY OF ROANOKE, VIRGINIA

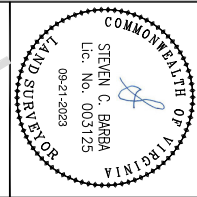

parker
DESIGN GROUP
PLANNERS • LANDSCAPE ARCHITECTS
2122 Carolina Ave. SW
Roanoke, VA 24014
Ph: 540-387-1133
1915-B W. Cary Street
Richmond, VA 23220
Phone: 804-358-2947
www.parkerdg.com