



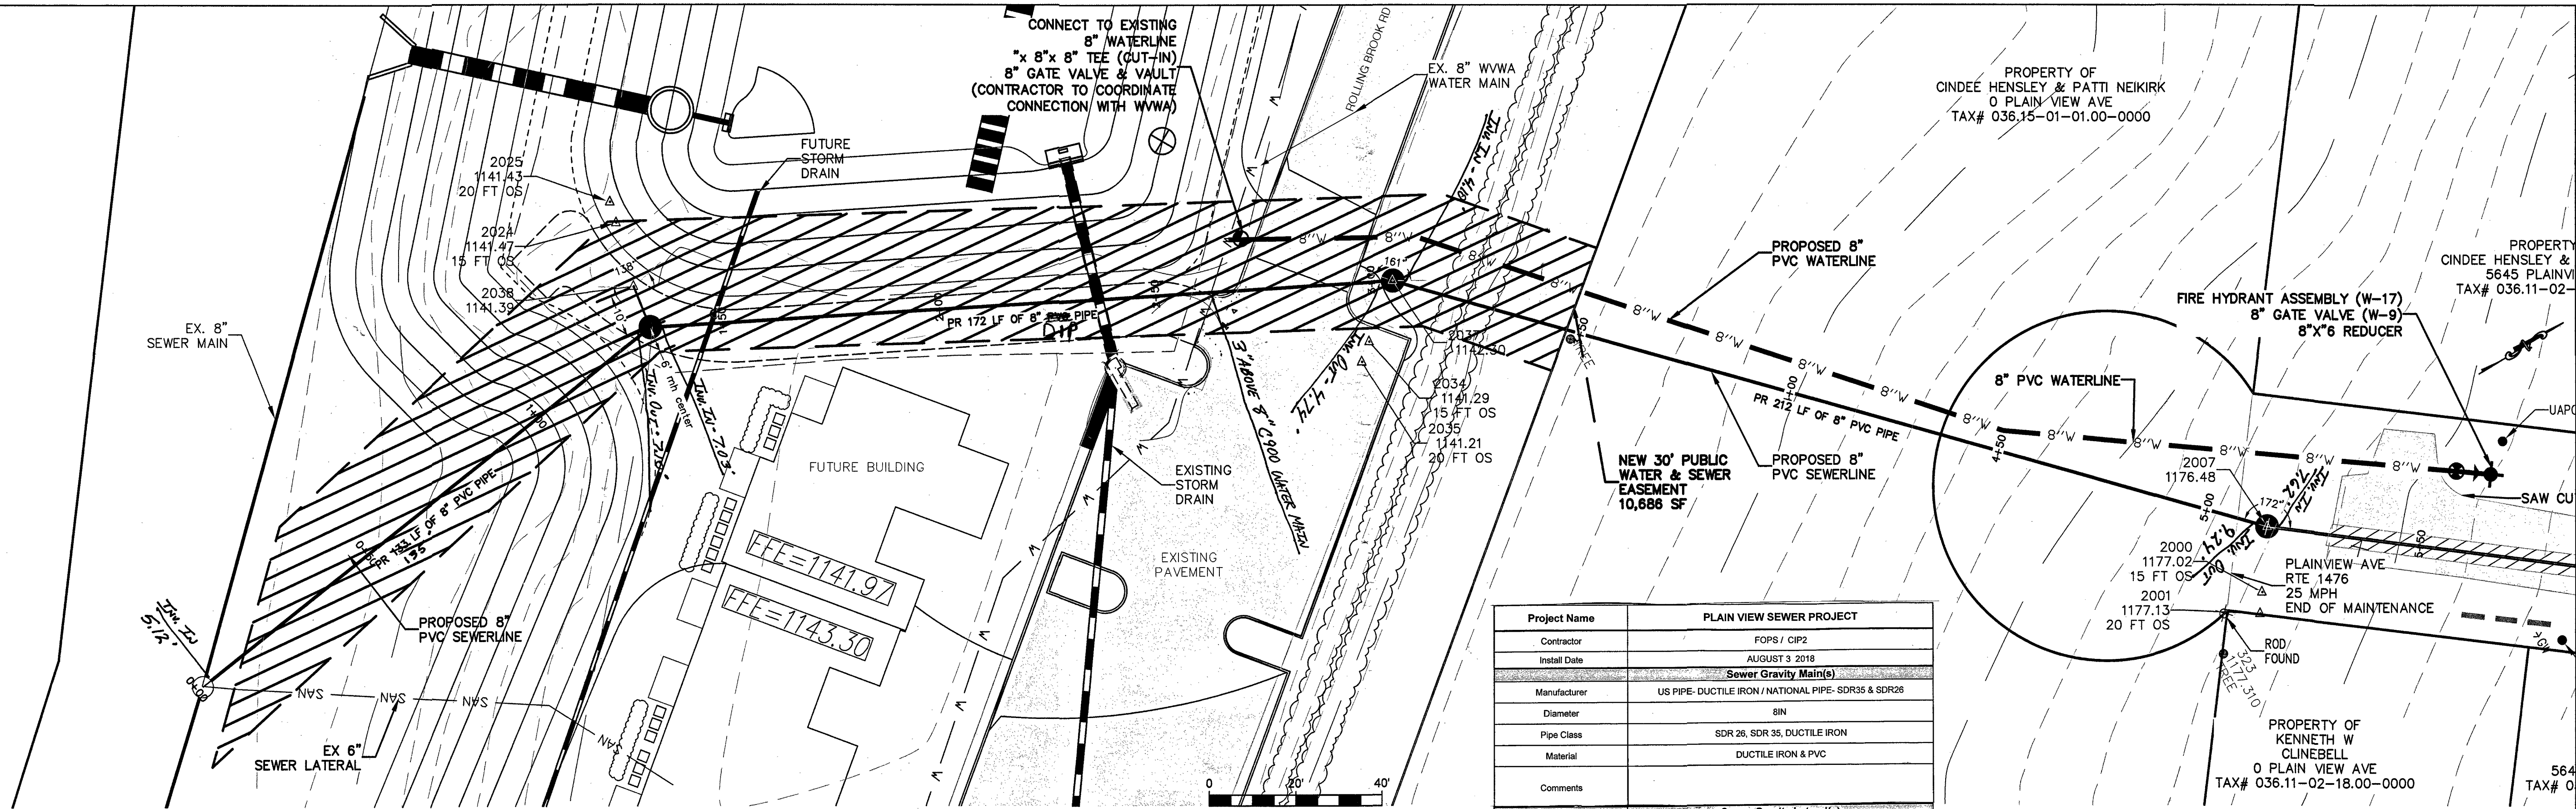

Project Name	PLAINVIEW SEWER PROJECT
Contractor	FOPS / CIP2
Install Date	AUGUST 3 2018
Sewer Gravity Main(s)	
Manufacturer	US PIPE- DUCTILE IRON / NATIONAL PIPE- SDR35 & SDR26
Diameter	6IN
Pipe Class	SDR 26, SDR 35, DUCTILE IRON
Material	DUCTILE IRON & PVC
Comments	
Sewer Gravity Lateral(s)	
Manufacturer	NATIONAL PIPE
Diameter	6IN
Pipe Class	SDR 35
Material	PVC
Comments	
Sewer Manhole(s)	
Manufacturer	CSI
Material	CONCRETE
Ring & Cover Manuf.	EAST JORDAN
Cover Type	STANDARD

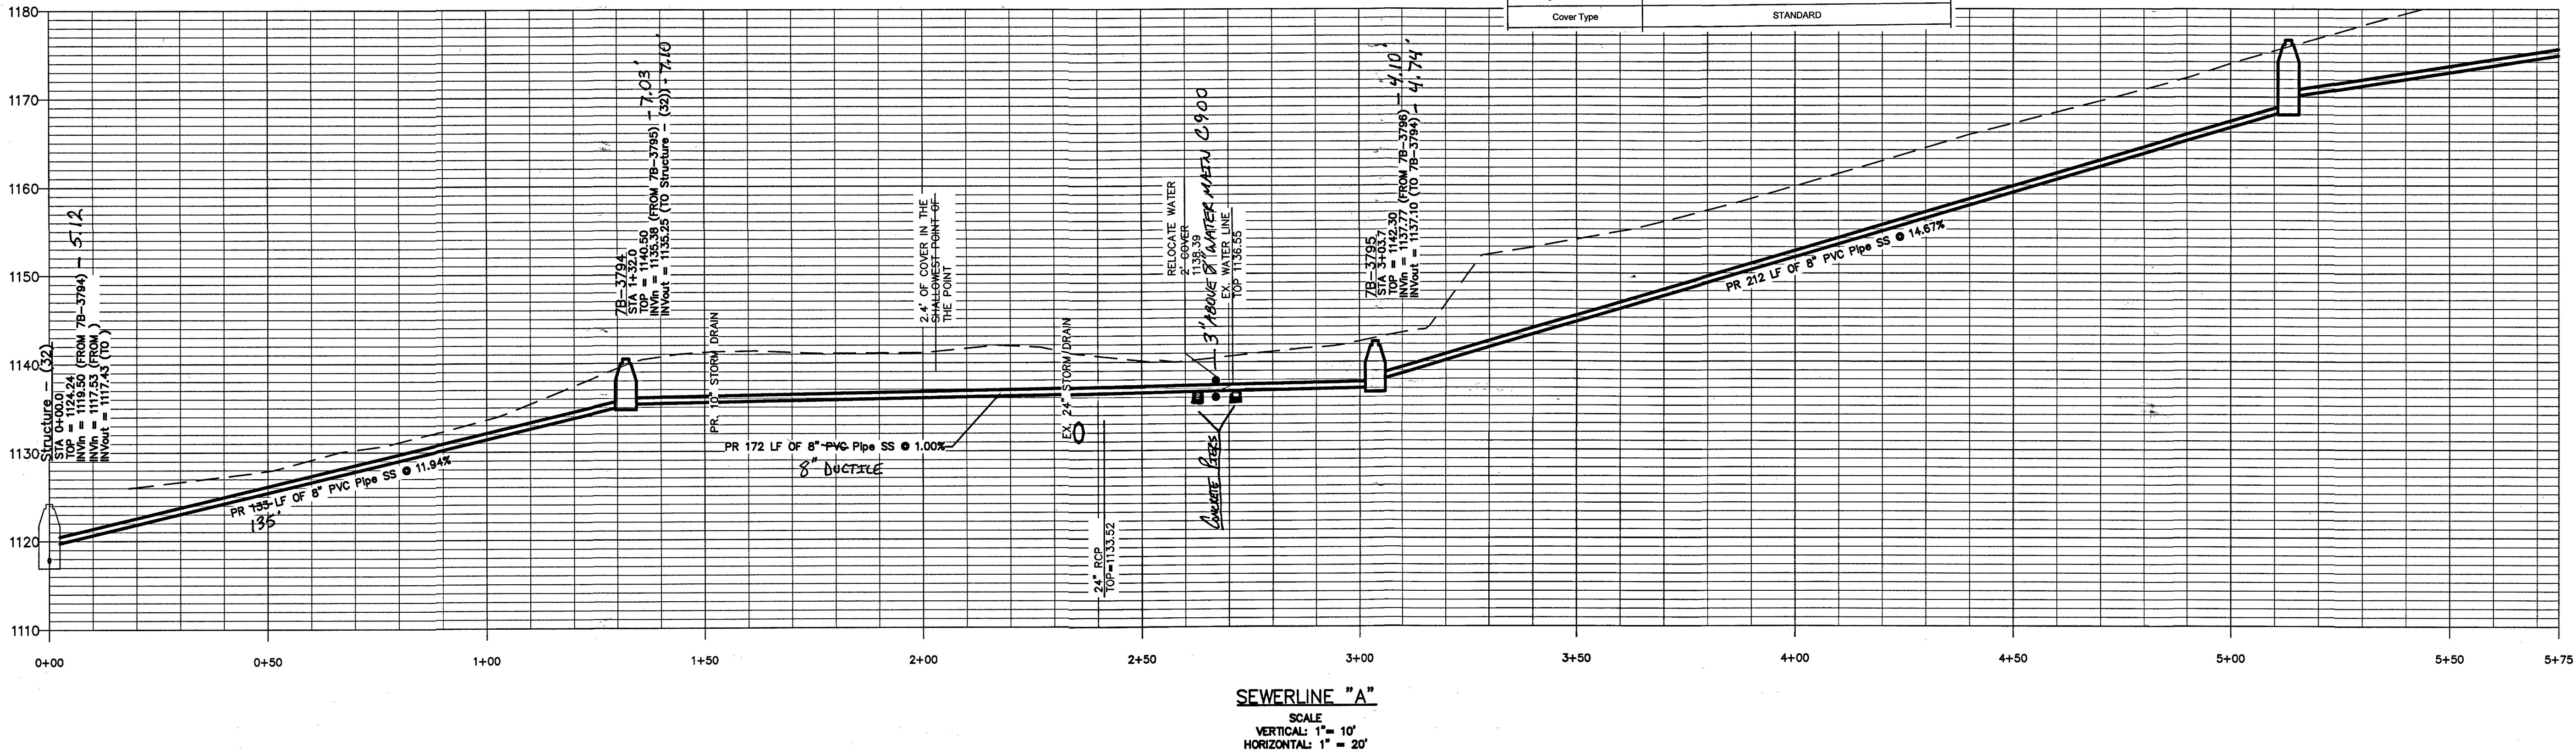

WESTERN VIRGINIA
WATER AUTHORITY

ENGINEERING SERVICES
601 S JEFFERSON ST, SUITE 300
ROANOKE, VA 24011
540-853-5700

PLAINVIEW SEWER

PLAN & PROFILE

Rev	Description	Date	By
1	PLAINVIEW CIP2		
2	THIR BENSLEY 8-3-18		
3	ABSTRACT		

Designed: AAS
Drawn: AAS
Checked: TEC
Approved:
Date: 3/14/18
Project:
1
Sheet 1 of 2