






These documents are the property of Parker Design Group (PDG) and may not be reproduced or used without the express permission of PDG. Any reuse of these documents without authorization of PDG will be at the sole risk of the individual or entity utilizing said documents.

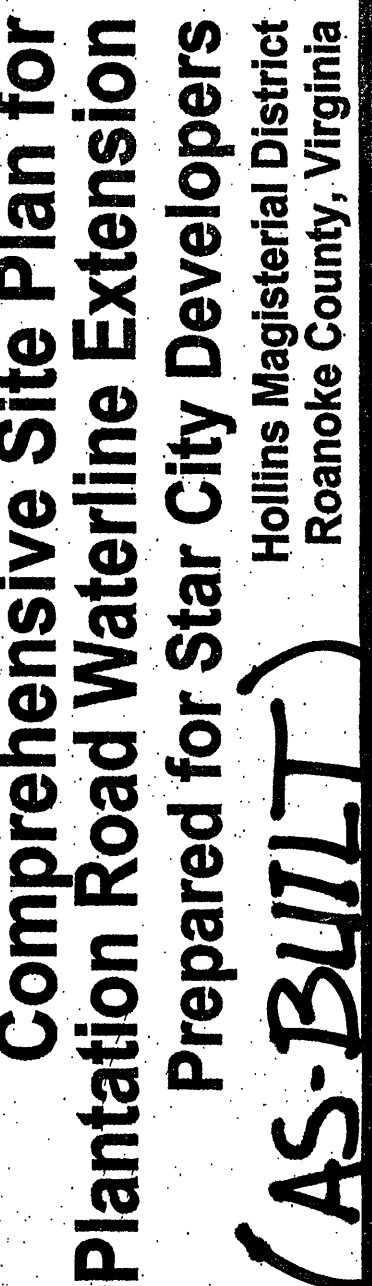

SHEET TITLE:
**Overall Plan
& Profile**

C02
2 OF 4
PROJECT NUMBER:
06-0402-06

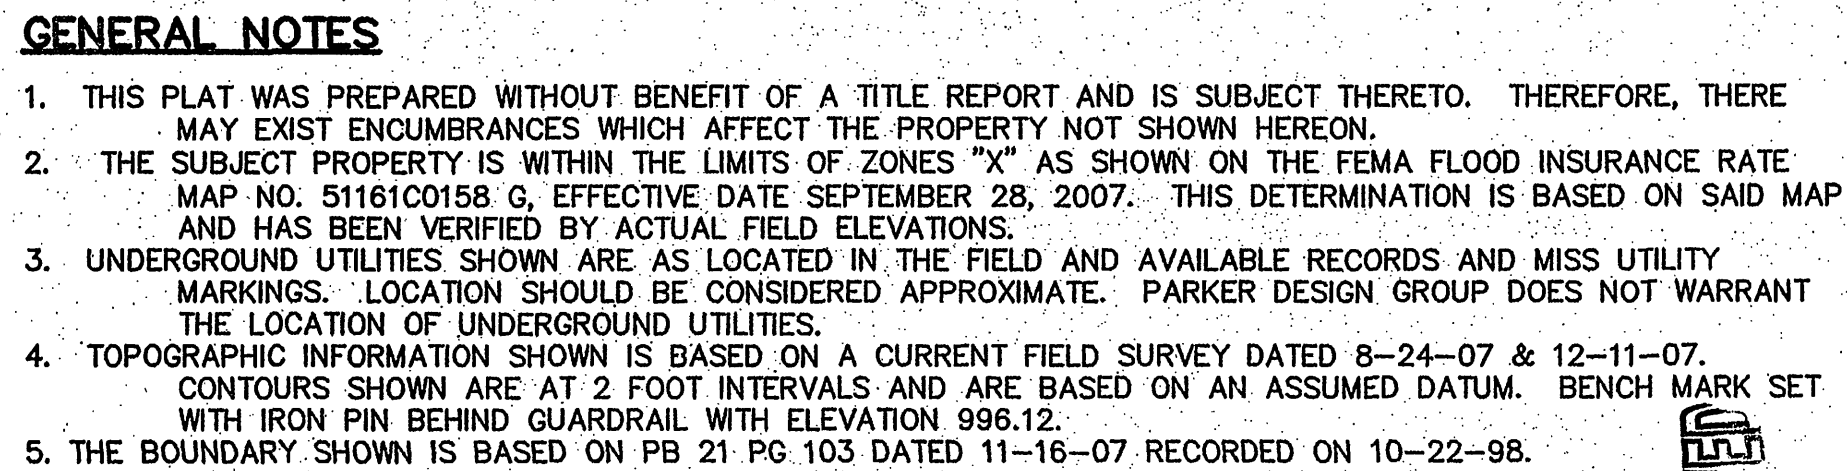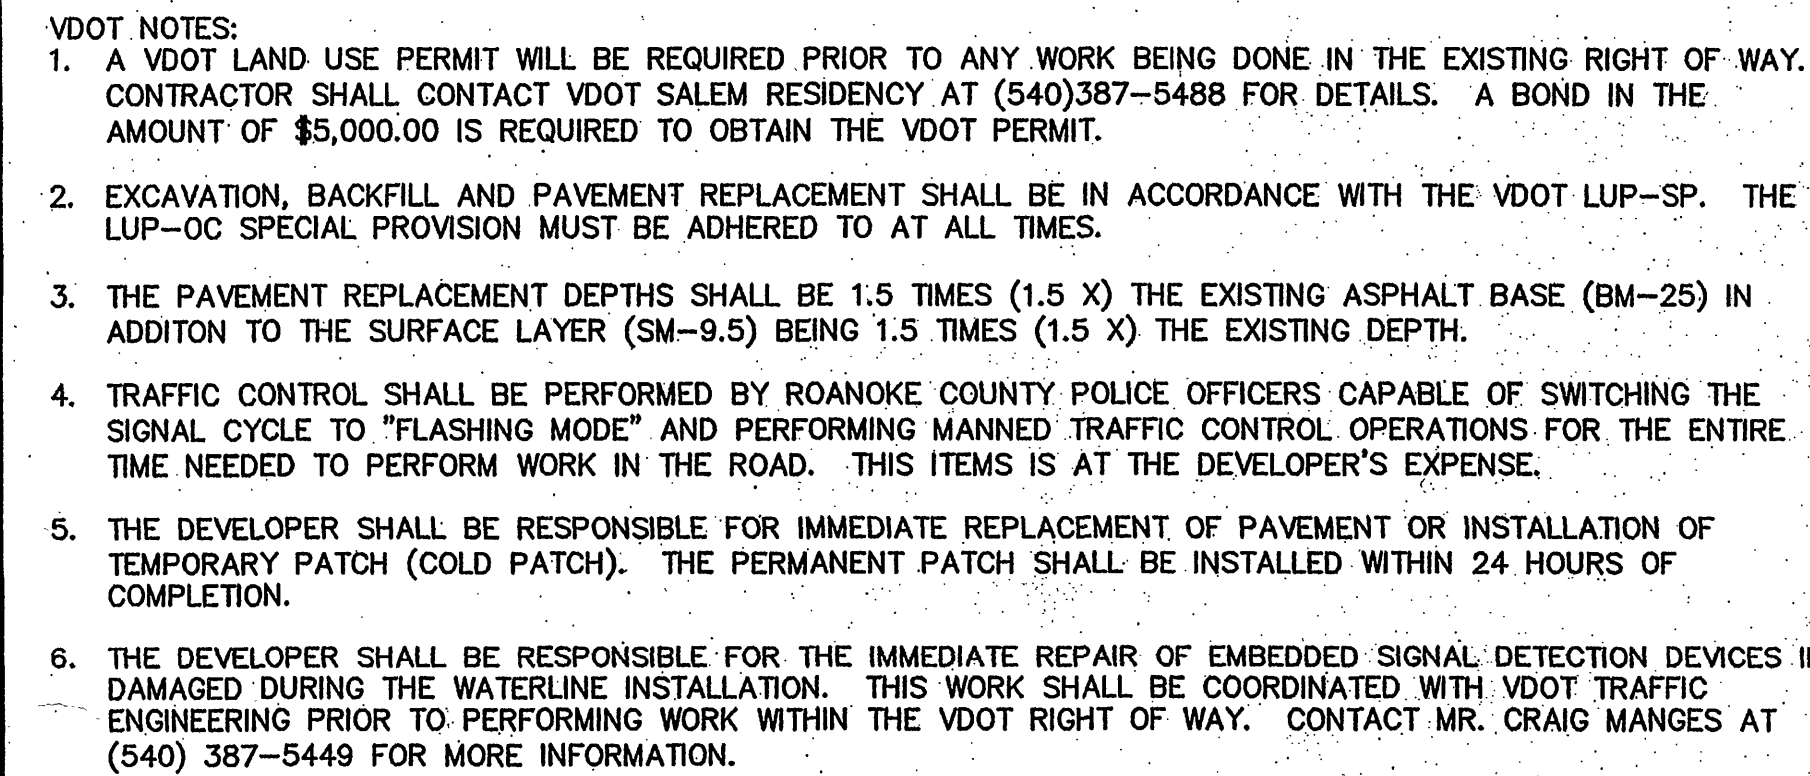

1. ALL CONNECTIONS TO EXISTING WATER MAINS SHALL BE COORDINATED WITH THE WESTERN VIRGINIA WATER AUTHORITY (WVWA).
2. WATER SERVICE LINES SHALL COMPLY WITH AWWA C151 LATEST EDITION.
3. MINIMUM CLEAR COVER OVER ALL WATER AND SEWER PIPE SHALL BE THREE (3) FEET.
4. ALL UTILITY CONSTRUCTION AND TESTING METHODS SHALL BE IN ACCORDANCE WITH MOST CURRENT WVWA STANDARDS.
5. EXISTING EASEMENTS FOR WATER LINE IS 20' BASED ON PLAT FROM RECORDS PREPARED BY JACK G. BESS DATED AUGUST 18, 1998 RECORDED IN PLAT BOOK 21 PG 103.
6. ALL WORK IN THE VDOT RIGHT OF WAY MUST BE APPROVED BY VDOT. ONCE APPROVED, A LAND USE PERMIT MUST BE OBTAINED PRIOR TO CONSTRUCTION. ALL APPLICABLE REGULATIONS MUST BE ADHERED TO WHILE WORKING IN THE VDOT RIGHT OF WAY.
7. CONTRACTOR SHALL UNCOVER EXISTING 12" STUB PIPE AND CONNECT TO EXISTING LINE WITH PROPOSED 12" 45° HORIZONTAL BEND AND THRUST BLOCK AND EXTEND LINE. CONTRACTOR SHALL VERIFY DEPTH OF EXISTING 12" LINE PRIOR TO CONSTRUCTION.
8. THE CONTRACTOR SHALL TAKE PRECAUTIONS WHEN INSTALLING THE WATERLINE NEAR THE TRAFFIC SIGNAL POLE AND FOUNDATION. PRIOR TO CONSTRUCTION, THE CONTRACTOR SHALL CONTACT THE REGIONAL TRAFFIC CONTROL CENTER FOR UNDERGROUND MARKINGS OF ALL TRAFFIC SIGNAL INFRASTRUCTURE AT (540) 389-5449 AND MR. CRAIG MANGES AT (540) 387-5449.
9. AFTER TESTING AND BEFORE FINAL INSPECTION, THE CONTRACTOR SHALL FLUSH AND DISINFECT IN ACCORDANCE WITH AWWA SPECIFICATION C651, LATEST REVISION.
10. CONTRACTOR MUST NOTIFY "4950 PLANTATION ROAD ASSOCIATES, LLC" PRIOR TO ENTERING SITE.

PROVIDE THE FOLLOWING:

- | | |
|----|---|
| CE | CONSTRUCTION ENTRANCE MEETING VA ESCH STD. & SPEC. 3.02 |
| SF | SILT FENCE MEETING VA ESCH STD. & SPEC. 3.05 |
| TS | TEMPORARY SEEDING MEETING VA ESCH STD. & SPEC. 3.31 |
| PS | PERMANENT SEEDING MEETING VA ESCH STD. & SPEC. 3.32 |

As-Built 3.2.10 K. Winslow

מחיר: 120 ₪