


BASE BID

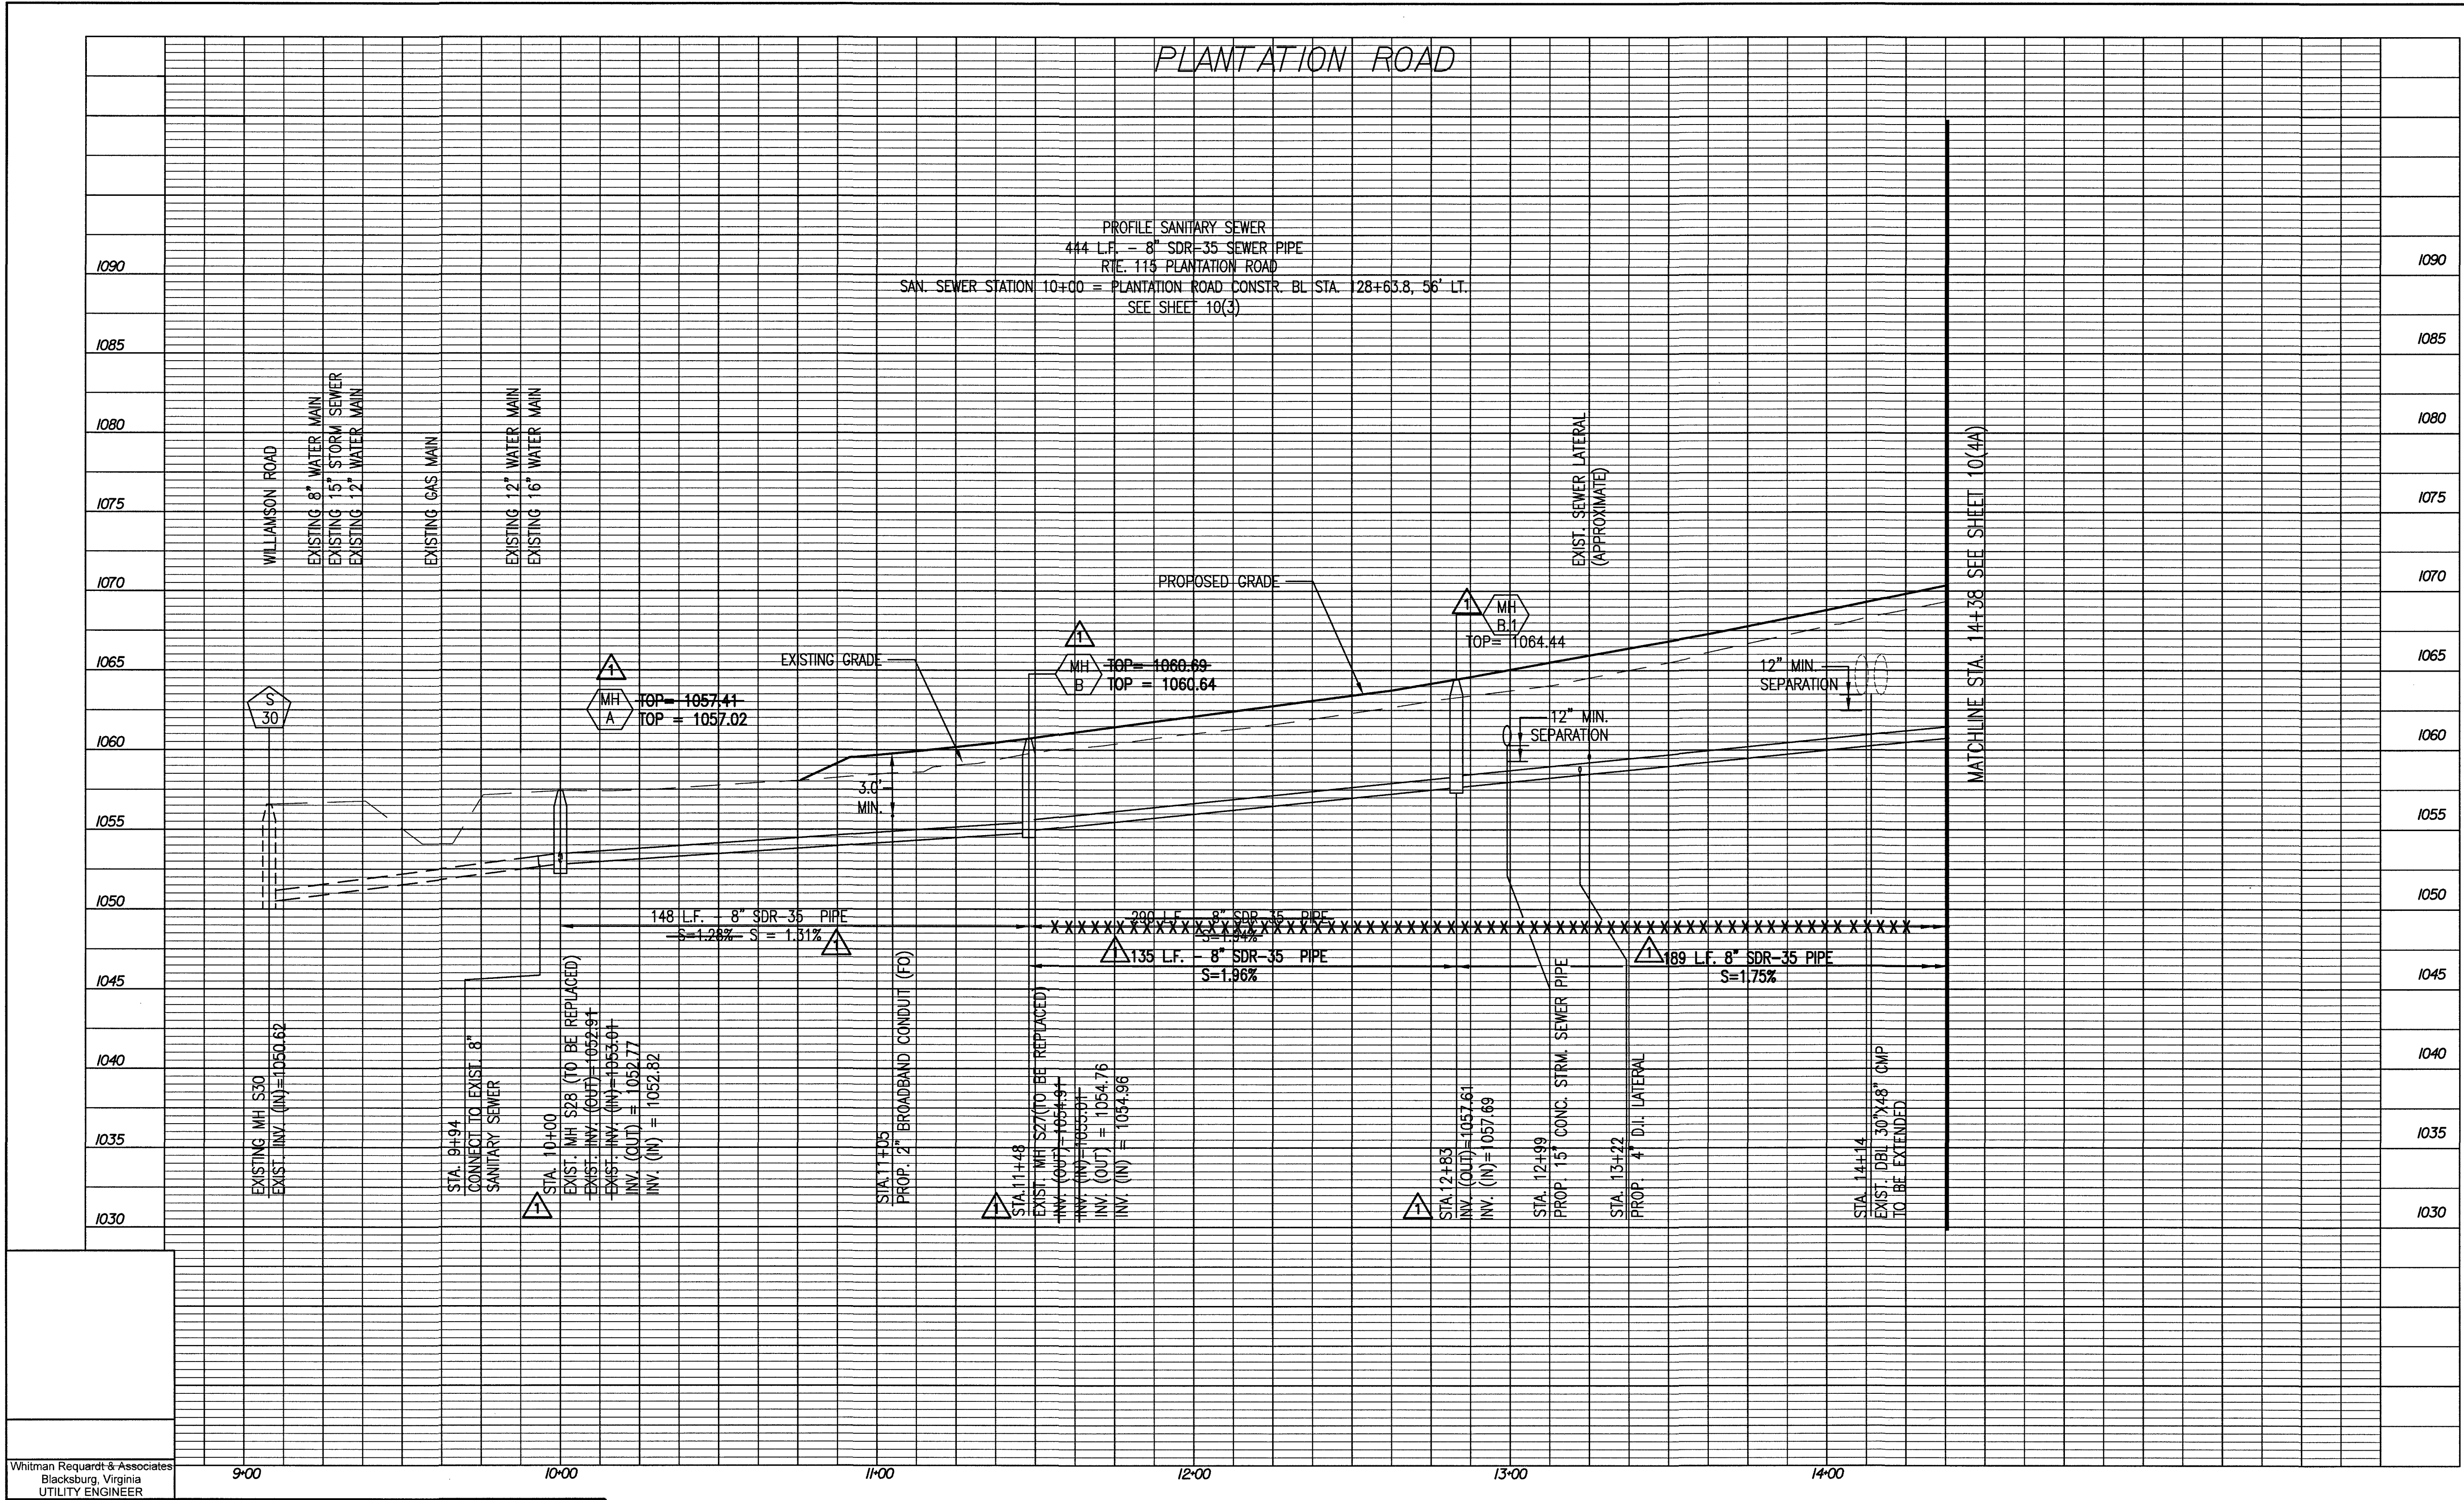


Whitman Requardt & Associates
Blacksburg, Virginia
UTILITY ENGINEER



COUNTY OF ROANOKE
5204 BERNARD DRIVE
ROANOKE, VA 24018

VDOT PROJECT NUMBERS:
0115-080-R95, P101, C501 &
EN12-080-823, P101, R201, C501
VDOT UPC NUMBERS: 98220 & 103607

RECORD DRAWING - MAY 2018
"RECORD DRAWINGS" PREPARED BASED ON MARKUPS
PROVIDED BY THE CONTRACTOR

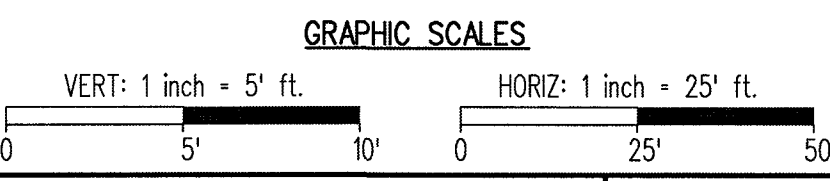

Rev	Date	Description
1	5/30/2018	RECORD DRAWING

PLANTATION ROAD, BICYCLE, PEDESTRIAN, AND
STREETSCAPE IMPROVEMENTS PROJECT

UTILITY PROFILE
10(3A)