




BASE BID

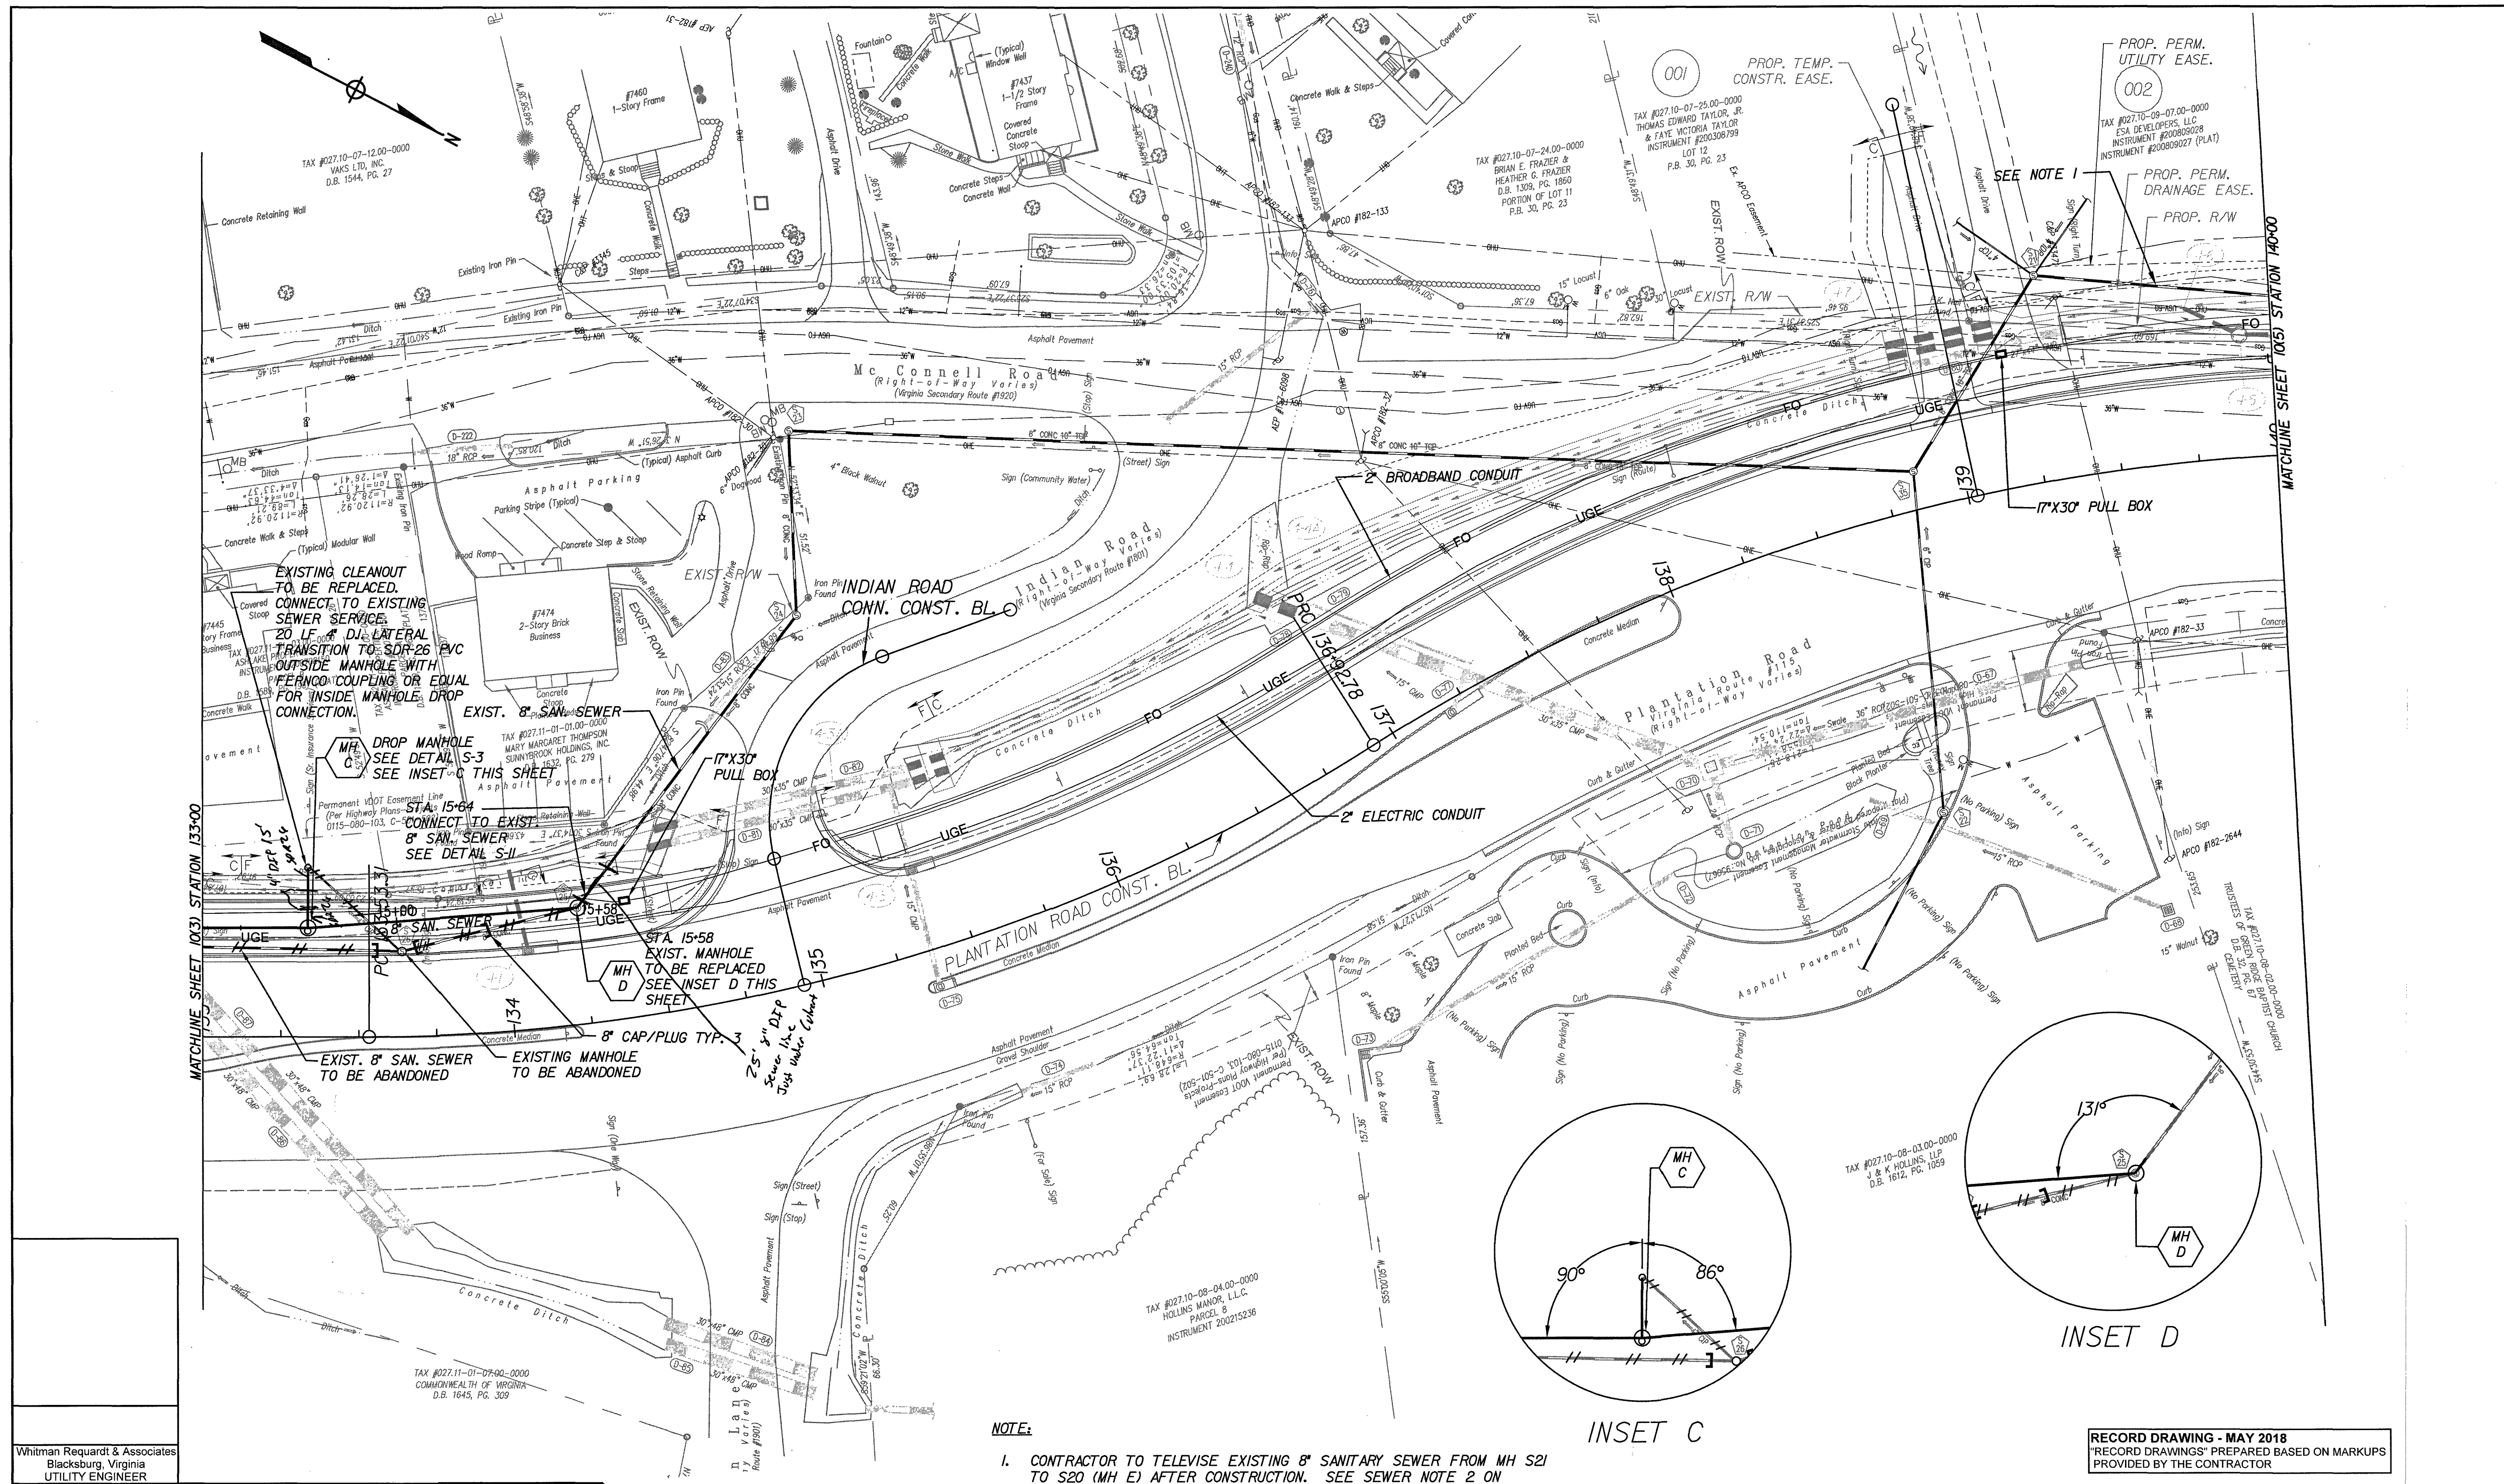

- NOTE:
1. CONTRACTOR TO TELEVIEW EXISTING 8" SANITARY SEWER FROM MH S21 TO S20 (MH E) AFTER CONSTRUCTION. SEE SEWER NOTE 2 ON SHEET 10(1A) FOR ADDITIONAL REQUIREMENTS.

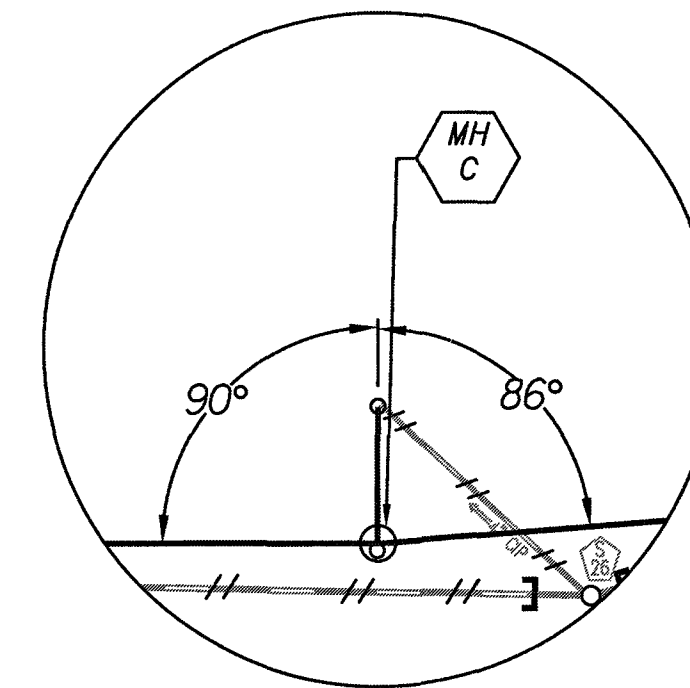

INSET C

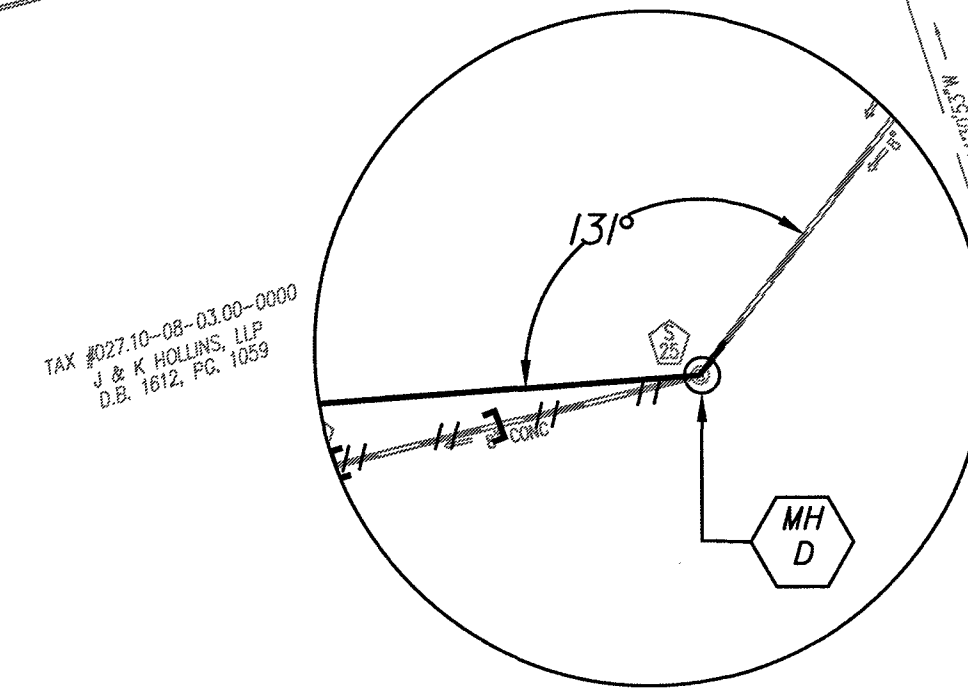

INSET D

RECORD DRAWING - MAY 2018
"RECORD DRAWINGS" PREPARED BASED ON MARKUPS
PROVIDED BY THE CONTRACTOR

Whitman Reardon & Associates
Blacksburg, Virginia
UTILITY ENGINEER



Whitman, Reardon & Associates, LLP
1700 Kraft Drive, Suite 1200, Blacksburg, Virginia 24060

COUNTY OF ROANOKE

5204 BERNARD DRIVE
ROANOKE, VA 24018

VDOT PROJECT NUMBERS:
0115-080-R95, P101, C501 &
EN12-080-823, P101, R201, C501

VDOT UPC NUMBERS: 98220 & 103607

PLANTATION ROAD, BICYCLE, PEDESTRIAN, AND
STREETSCAPE IMPROVEMENTS PROJECT

UTILITY PLAN

Sheet
10(4)