


BASE BID

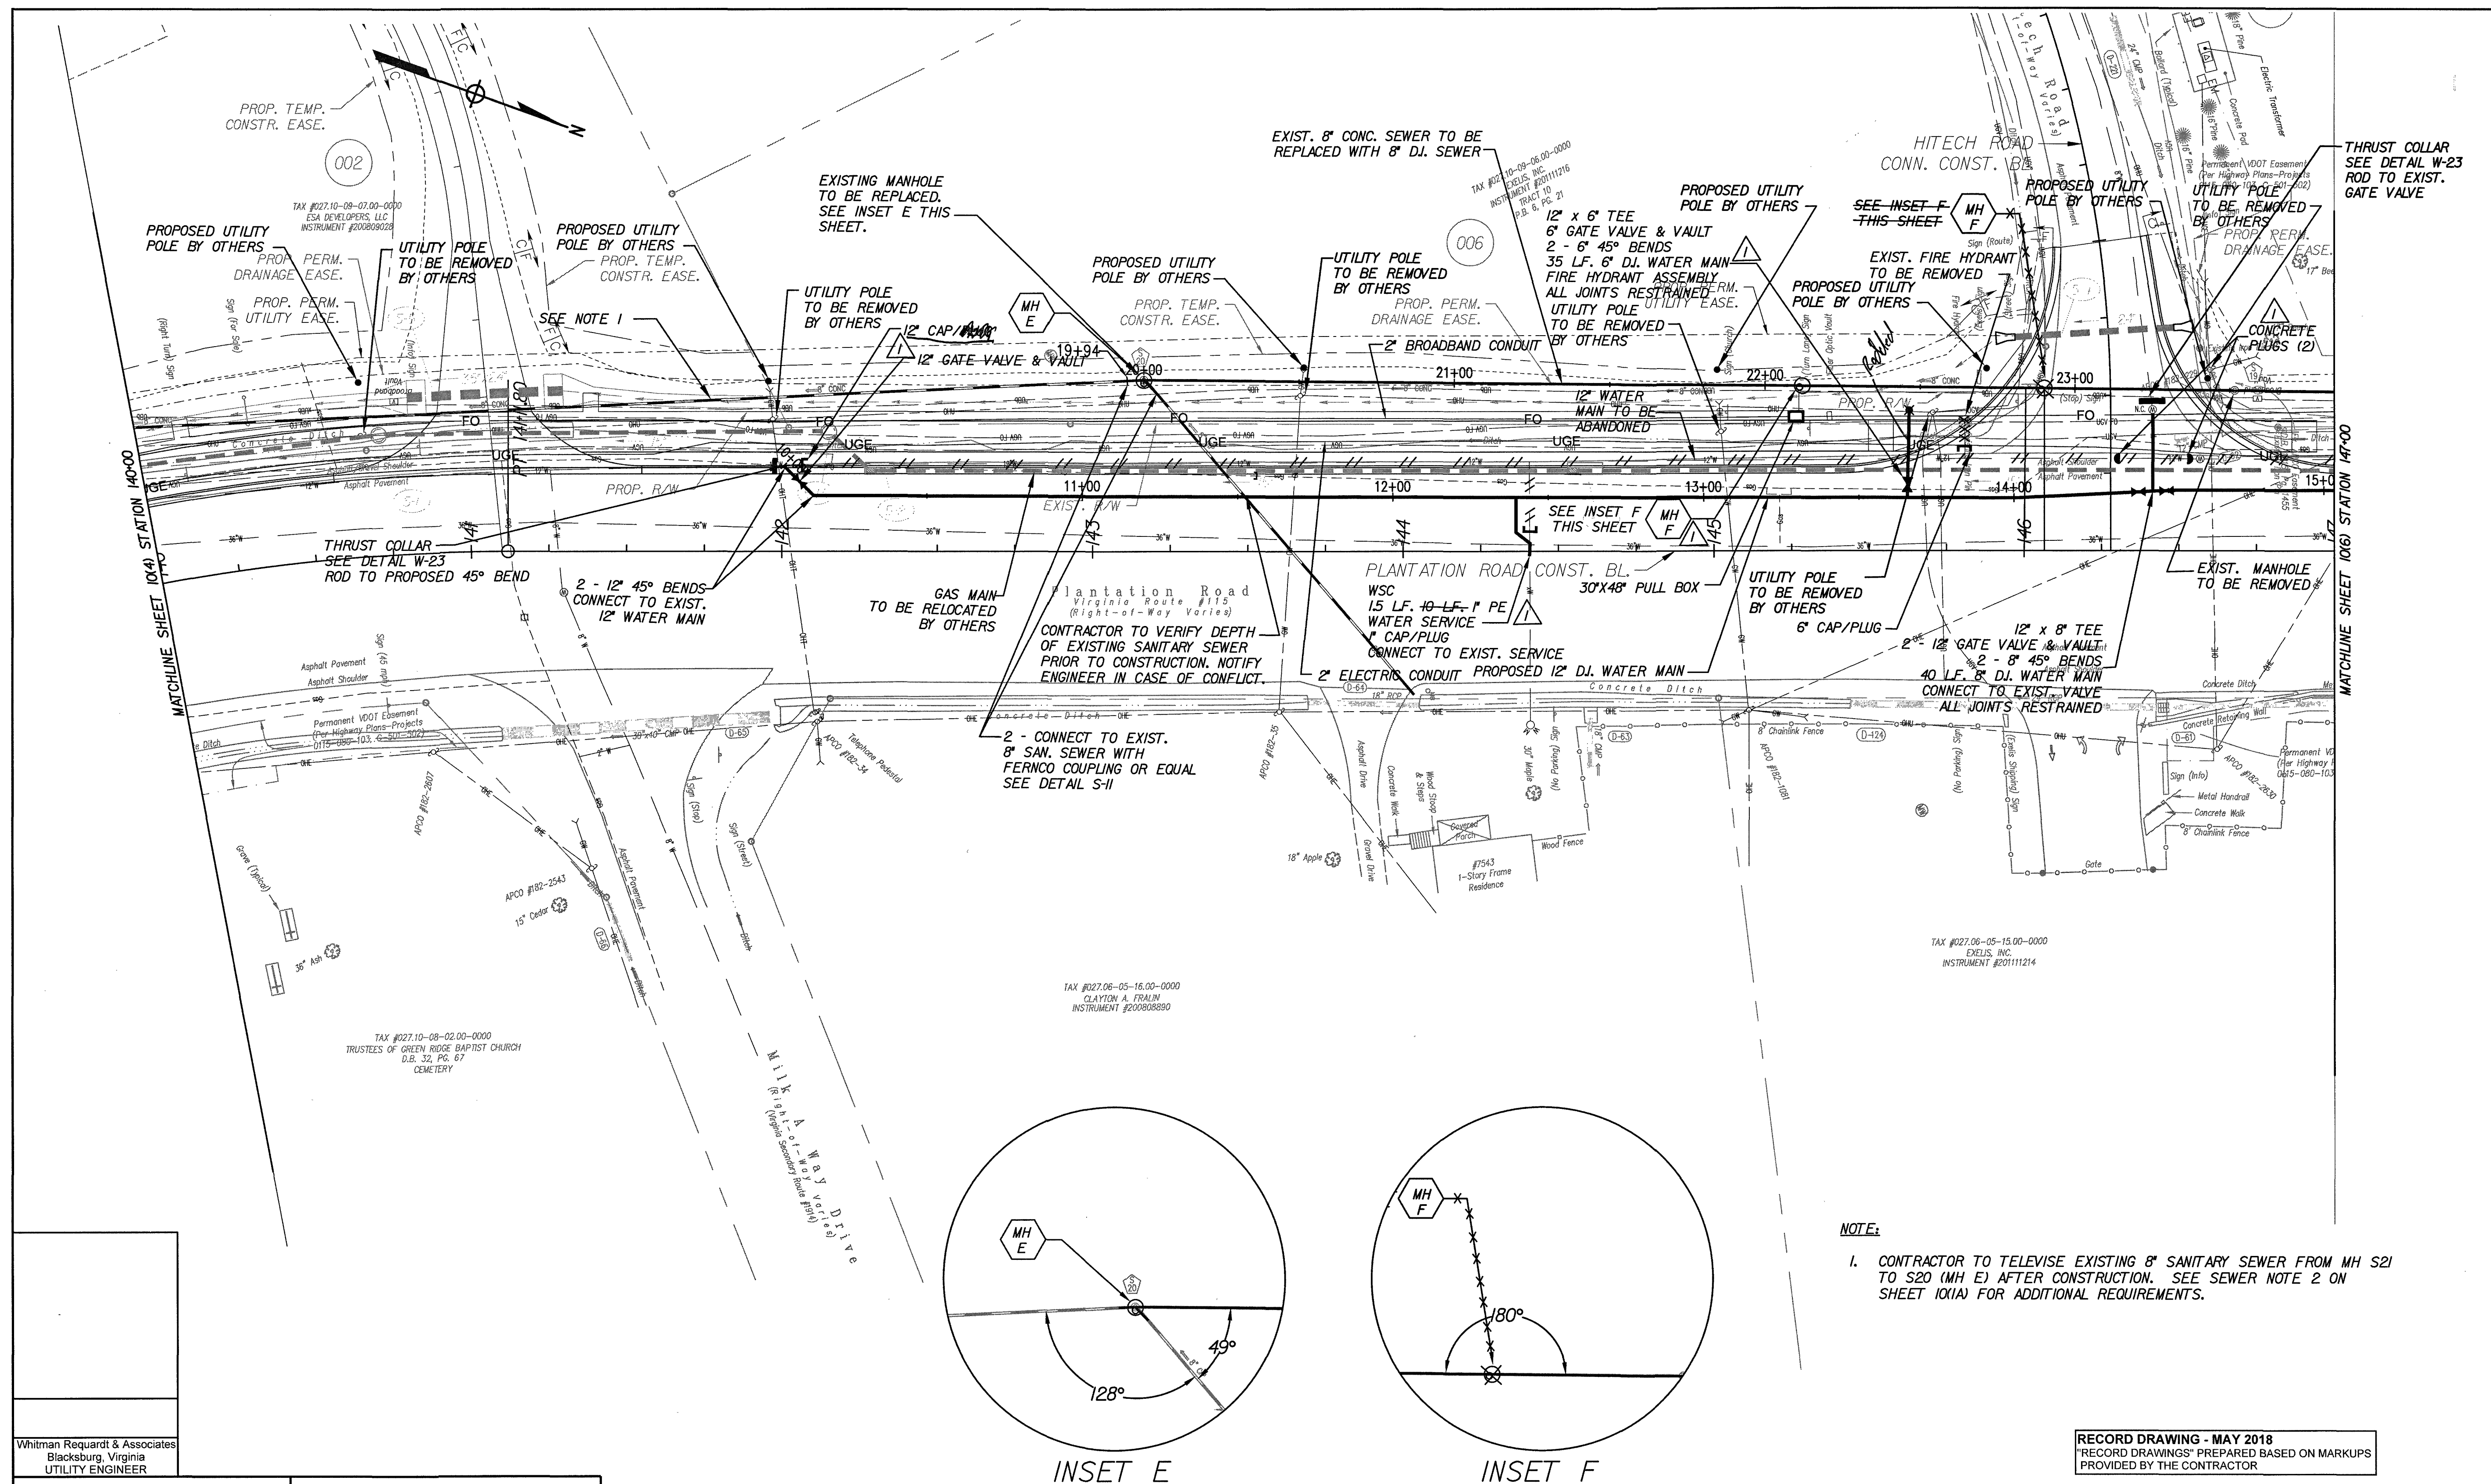

NOTE:

1. CONTRACTOR TO TELEWISE EXISTING 8" SANITARY SEWER FROM MH S21 TO S20 (MH E) AFTER CONSTRUCTION. SEE SEWER NOTE 2 ON SHEET 10(1A) FOR ADDITIONAL REQUIREMENTS.

RECORD DRAWING - MAY 2018
"RECORD DRAWINGS" PREPARED BASED ON MARKUPS
PROVIDED BY THE CONTRACTOR

1	5/30/2018	RECORD DRAWING
Rev	Date	Description

Drawing	Sheet
UTILITY PLAN	10(5)



Whitman, Requardt & Associates, LLP
1700 Kraft Drive, Suite 1200, Blacksburg, Virginia 24060

COUNTY OF ROANOKE
5204 BERNARD DRIVE
ROANOKE, VA 24018

VDOT PROJECT NUMBERS:
0115-080-R95, P101, C501 &
EN12-080-823, P101, R201, C501

VDOT UPC NUMBERS: 98220 & 10360

PLANTATION ROAD, BICYCLE, PEDESTRIAN, AND STREETSCAPE IMPROVEMENTS PROJECT