


BASE BID



Whitman Requardt & Associates
Blacksburg, Virginia
UTILITY ENGINEER

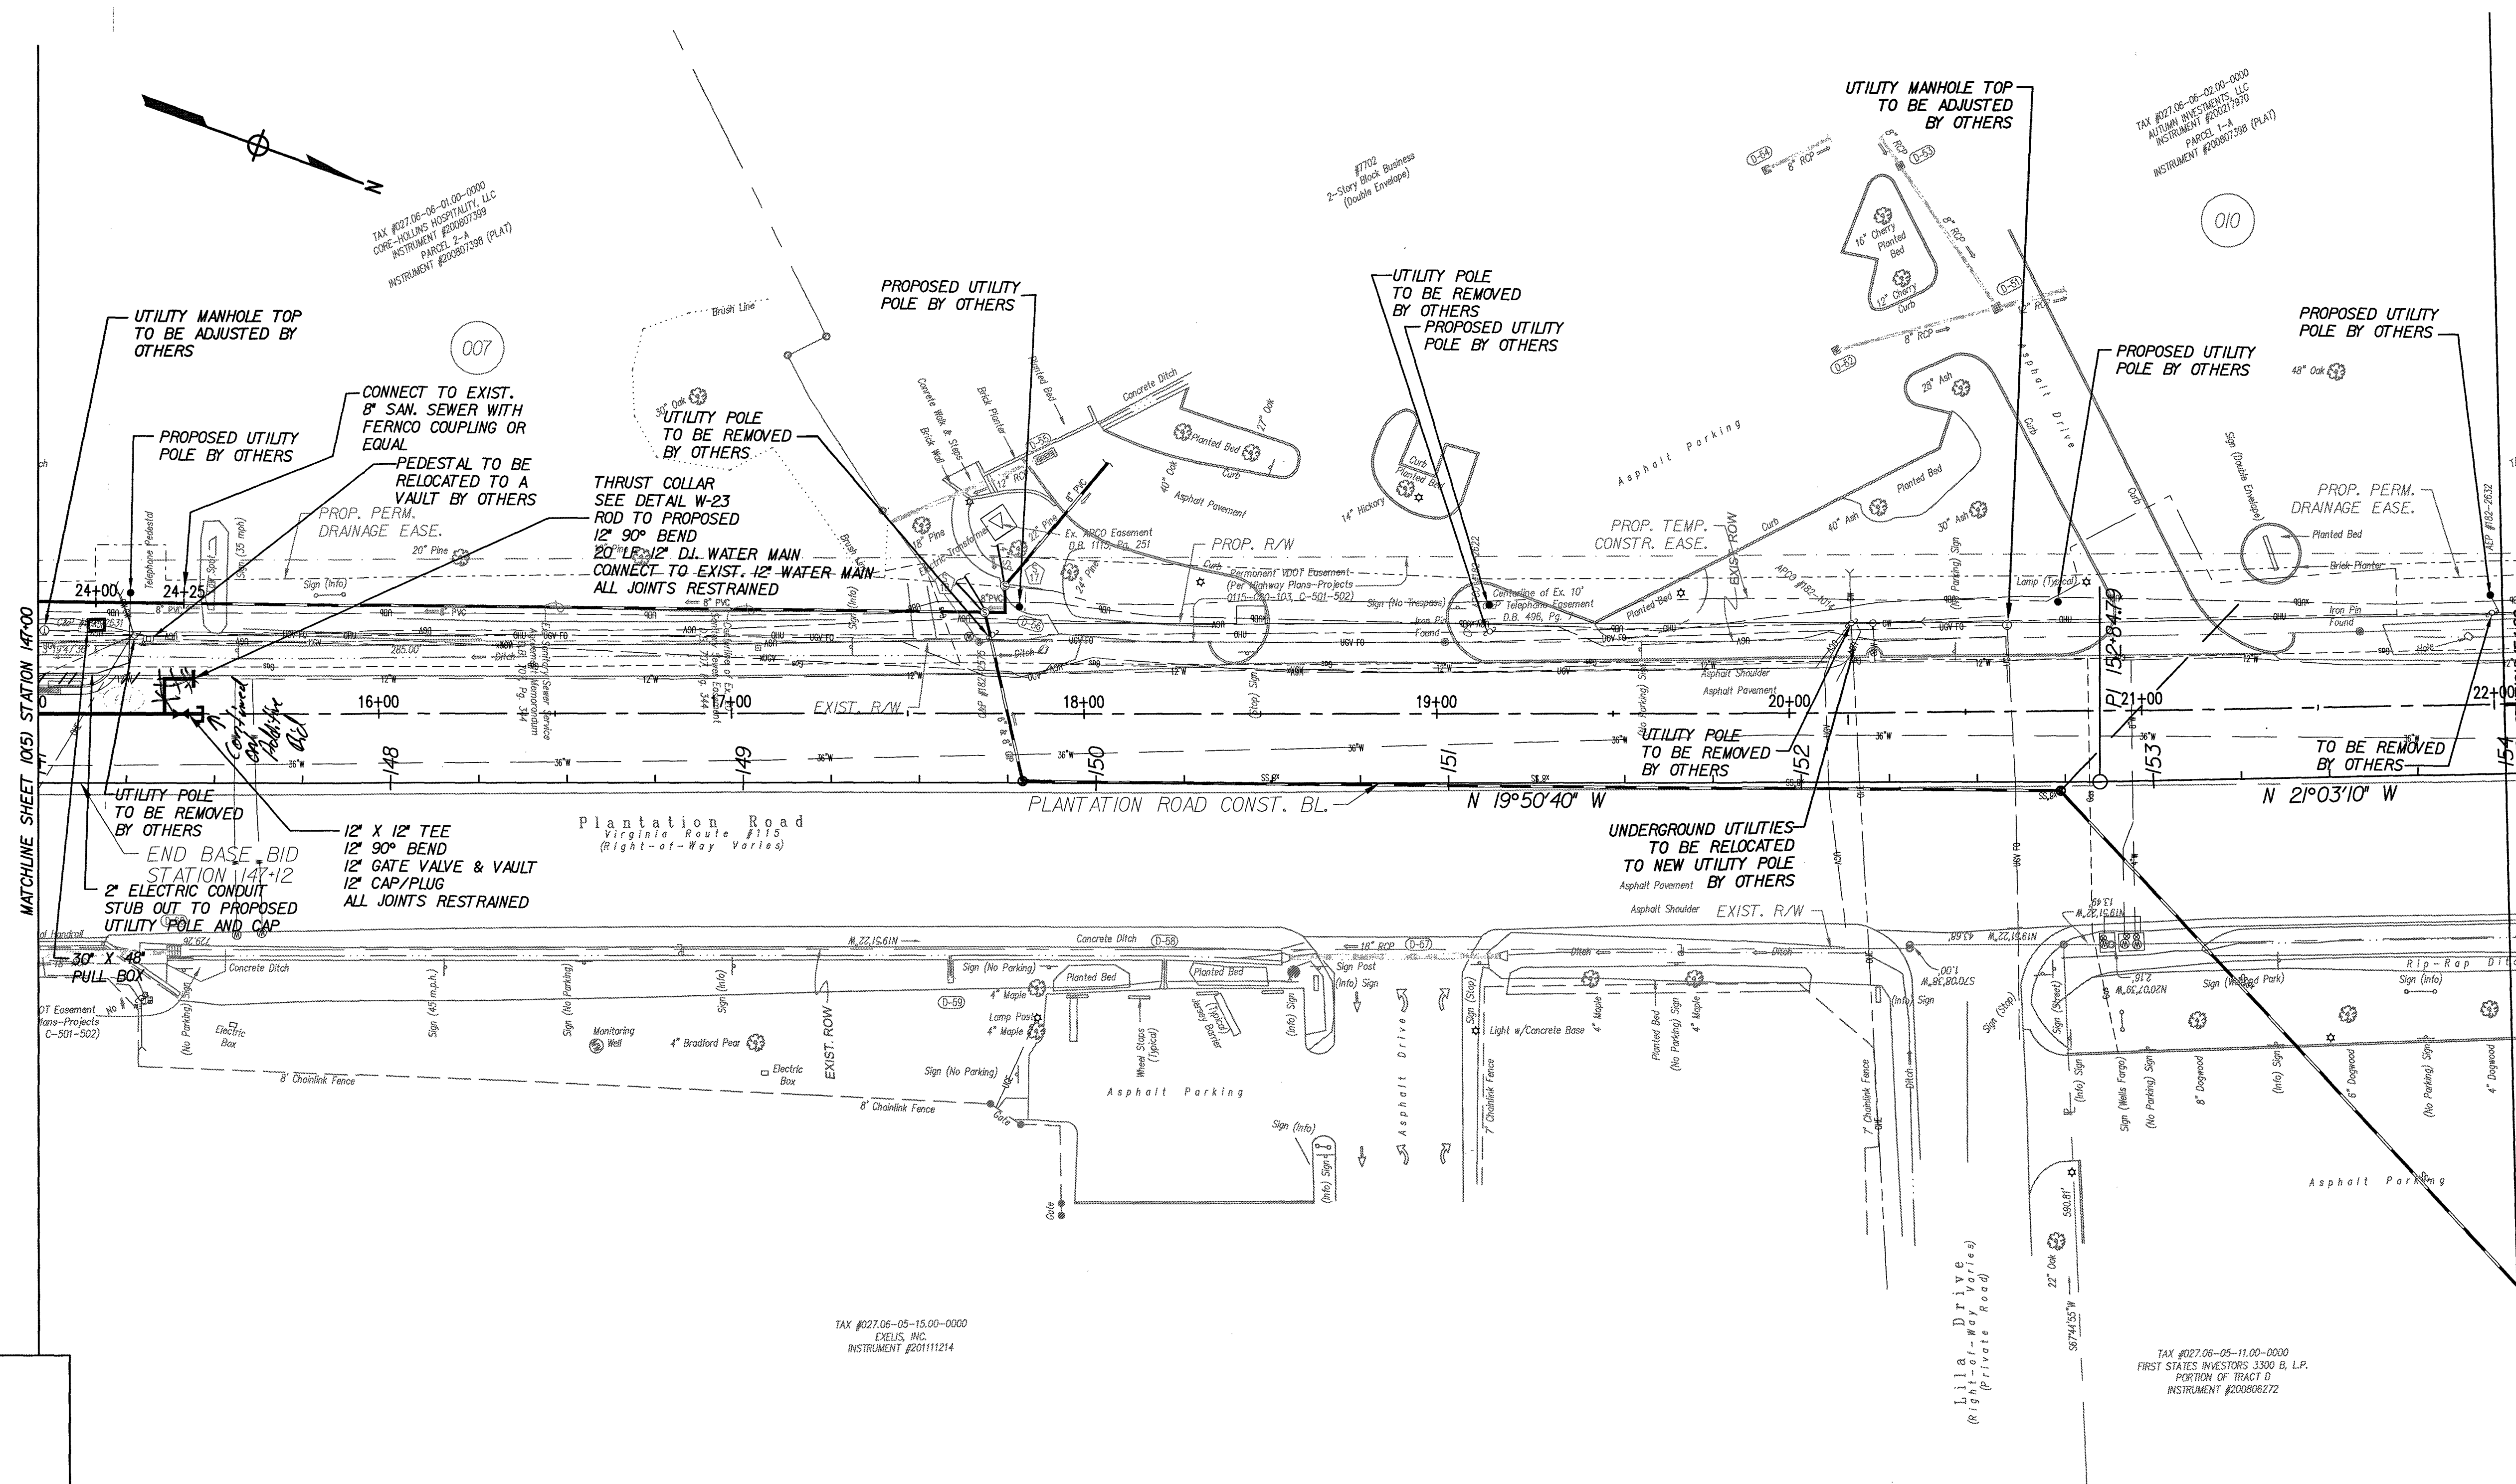

Whitman, Requardt & Associates, LLP
1700 Kraft Drive, Suite 1200, Blacksburg, Virginia 24060

COUNTY OF ROANOKE

5204 BERNARD DRIVE
ROANOKE, VA 24018

VDOT PROJECT NUMBERS:
0115-080-R95, P101, C501 &
EN12-080-823, P101, R201, C501

VDOT UPC NUMBERS: 98220 & 103607

PLANTATION ROAD, BICYCLE, PEDESTRIAN, AND STREETSCAPE IMPROVEMENTS PROJECT

RECORD DRAWING - MAY 2018
"RECORD DRAWINGS" PREPARED BASED ON MARKUPS
PROVIDED BY THE CONTRACTOR

50'	Rev	Date Description

UTILITY PLAN

Sheet
10(6)

SCALE



0 25' 50'