


BASE BID



Whitman Requardt & Associates
Blacksburg, Virginia
UTILITY ENGINEER

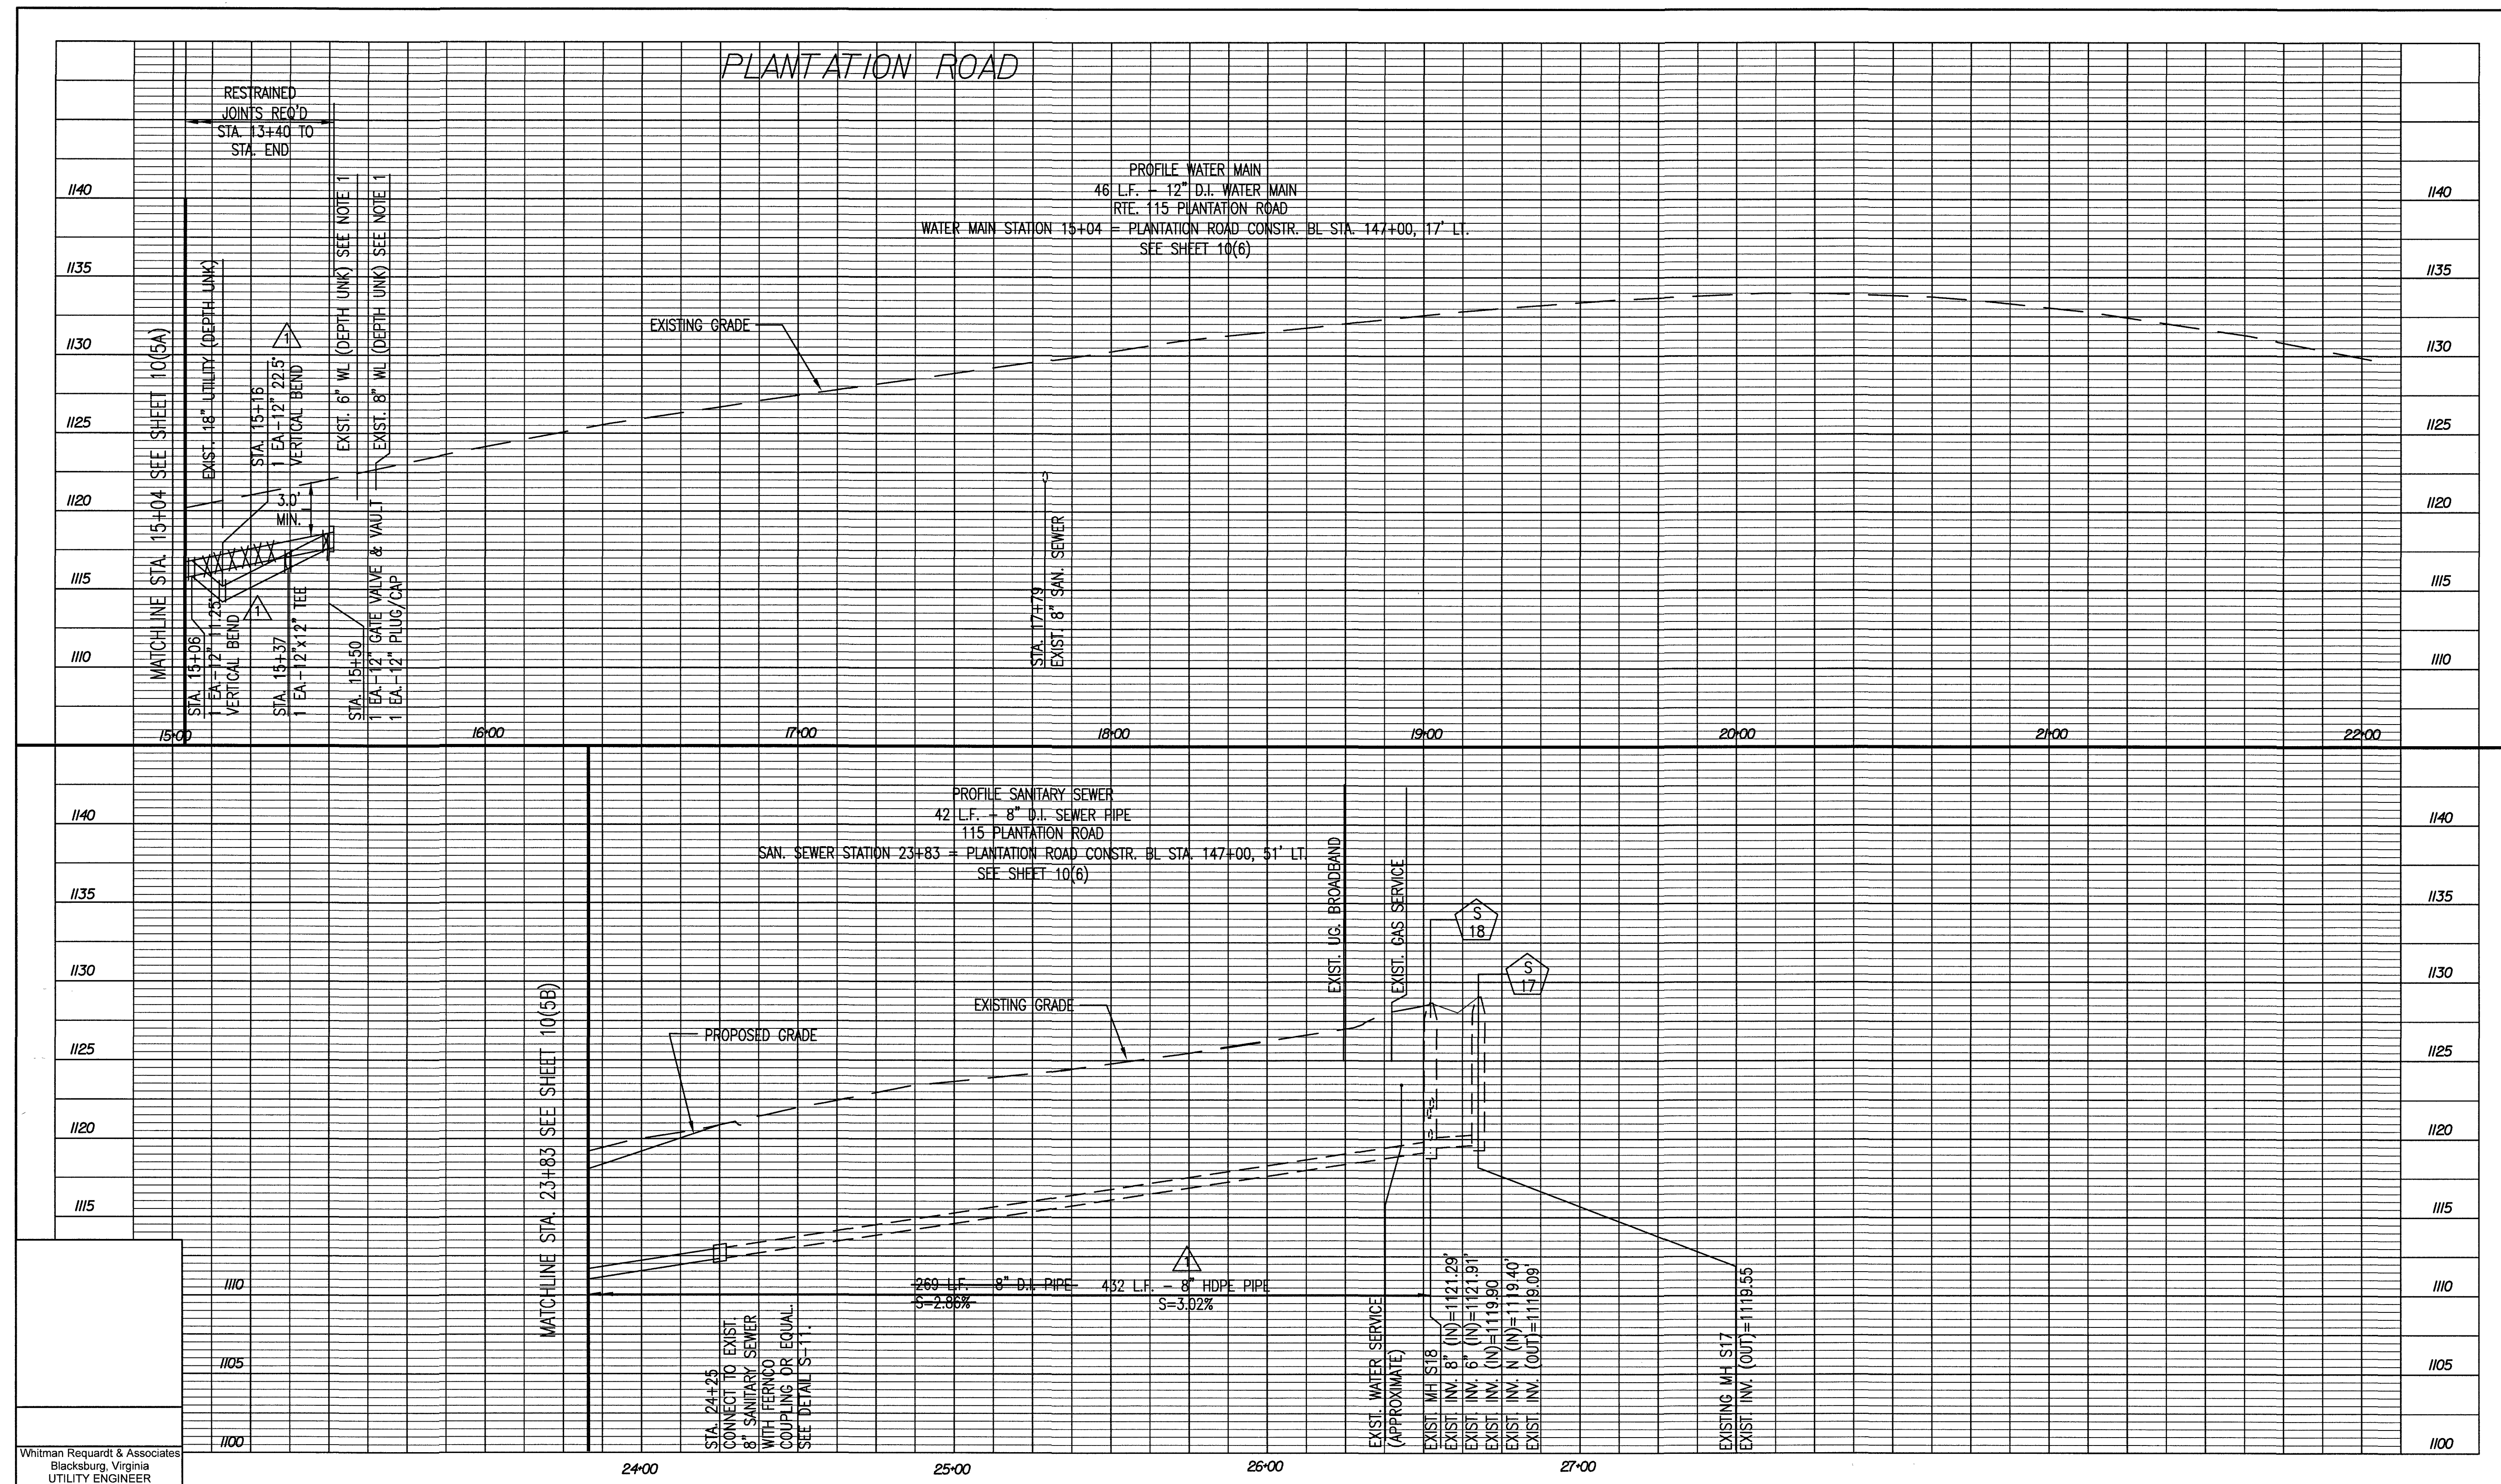

RECORD DRAWING - MAY 2018
"RECORD DRAWINGS" PREPARED BASED ON MARKUPS
PROVIDED BY THE CONTRACTOR

COUNTY OF ROANOKE

5204 BERNARD DRIVE
ROANOKE, VA 24018


NOTE:

I. CONTRACTOR TO PROVIDE TEMPORARY WATER SERVICE TO ALLOW FOR CONSTRUCTION OF 12" D.J. WATER MAIN.

VDOT PROJECT NUMBERS:
0115-080-R95, P101, C501 &
EN12-080-823, P101, R201, C501

VDOT UPC NUMBERS: 98220 & 103607

PLANTATION ROAD, BICYCLE, PEDESTRIAN, AND STREETSCAPE IMPROVEMENTS PROJECT

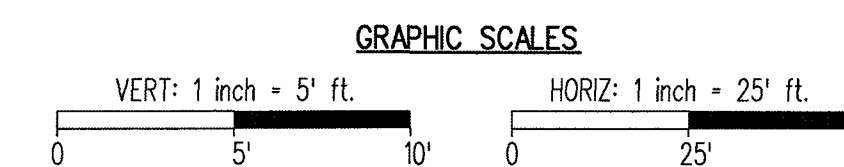

1	5/30/2018	RECORD DRAWING
Rev	Date	Description

UTILITY PROFILE

Sheet
10(6A)