


ADDITIVE BID



Whitman Reardon & Associates
Blacksburg, Virginia
UTILITY ENGINEER

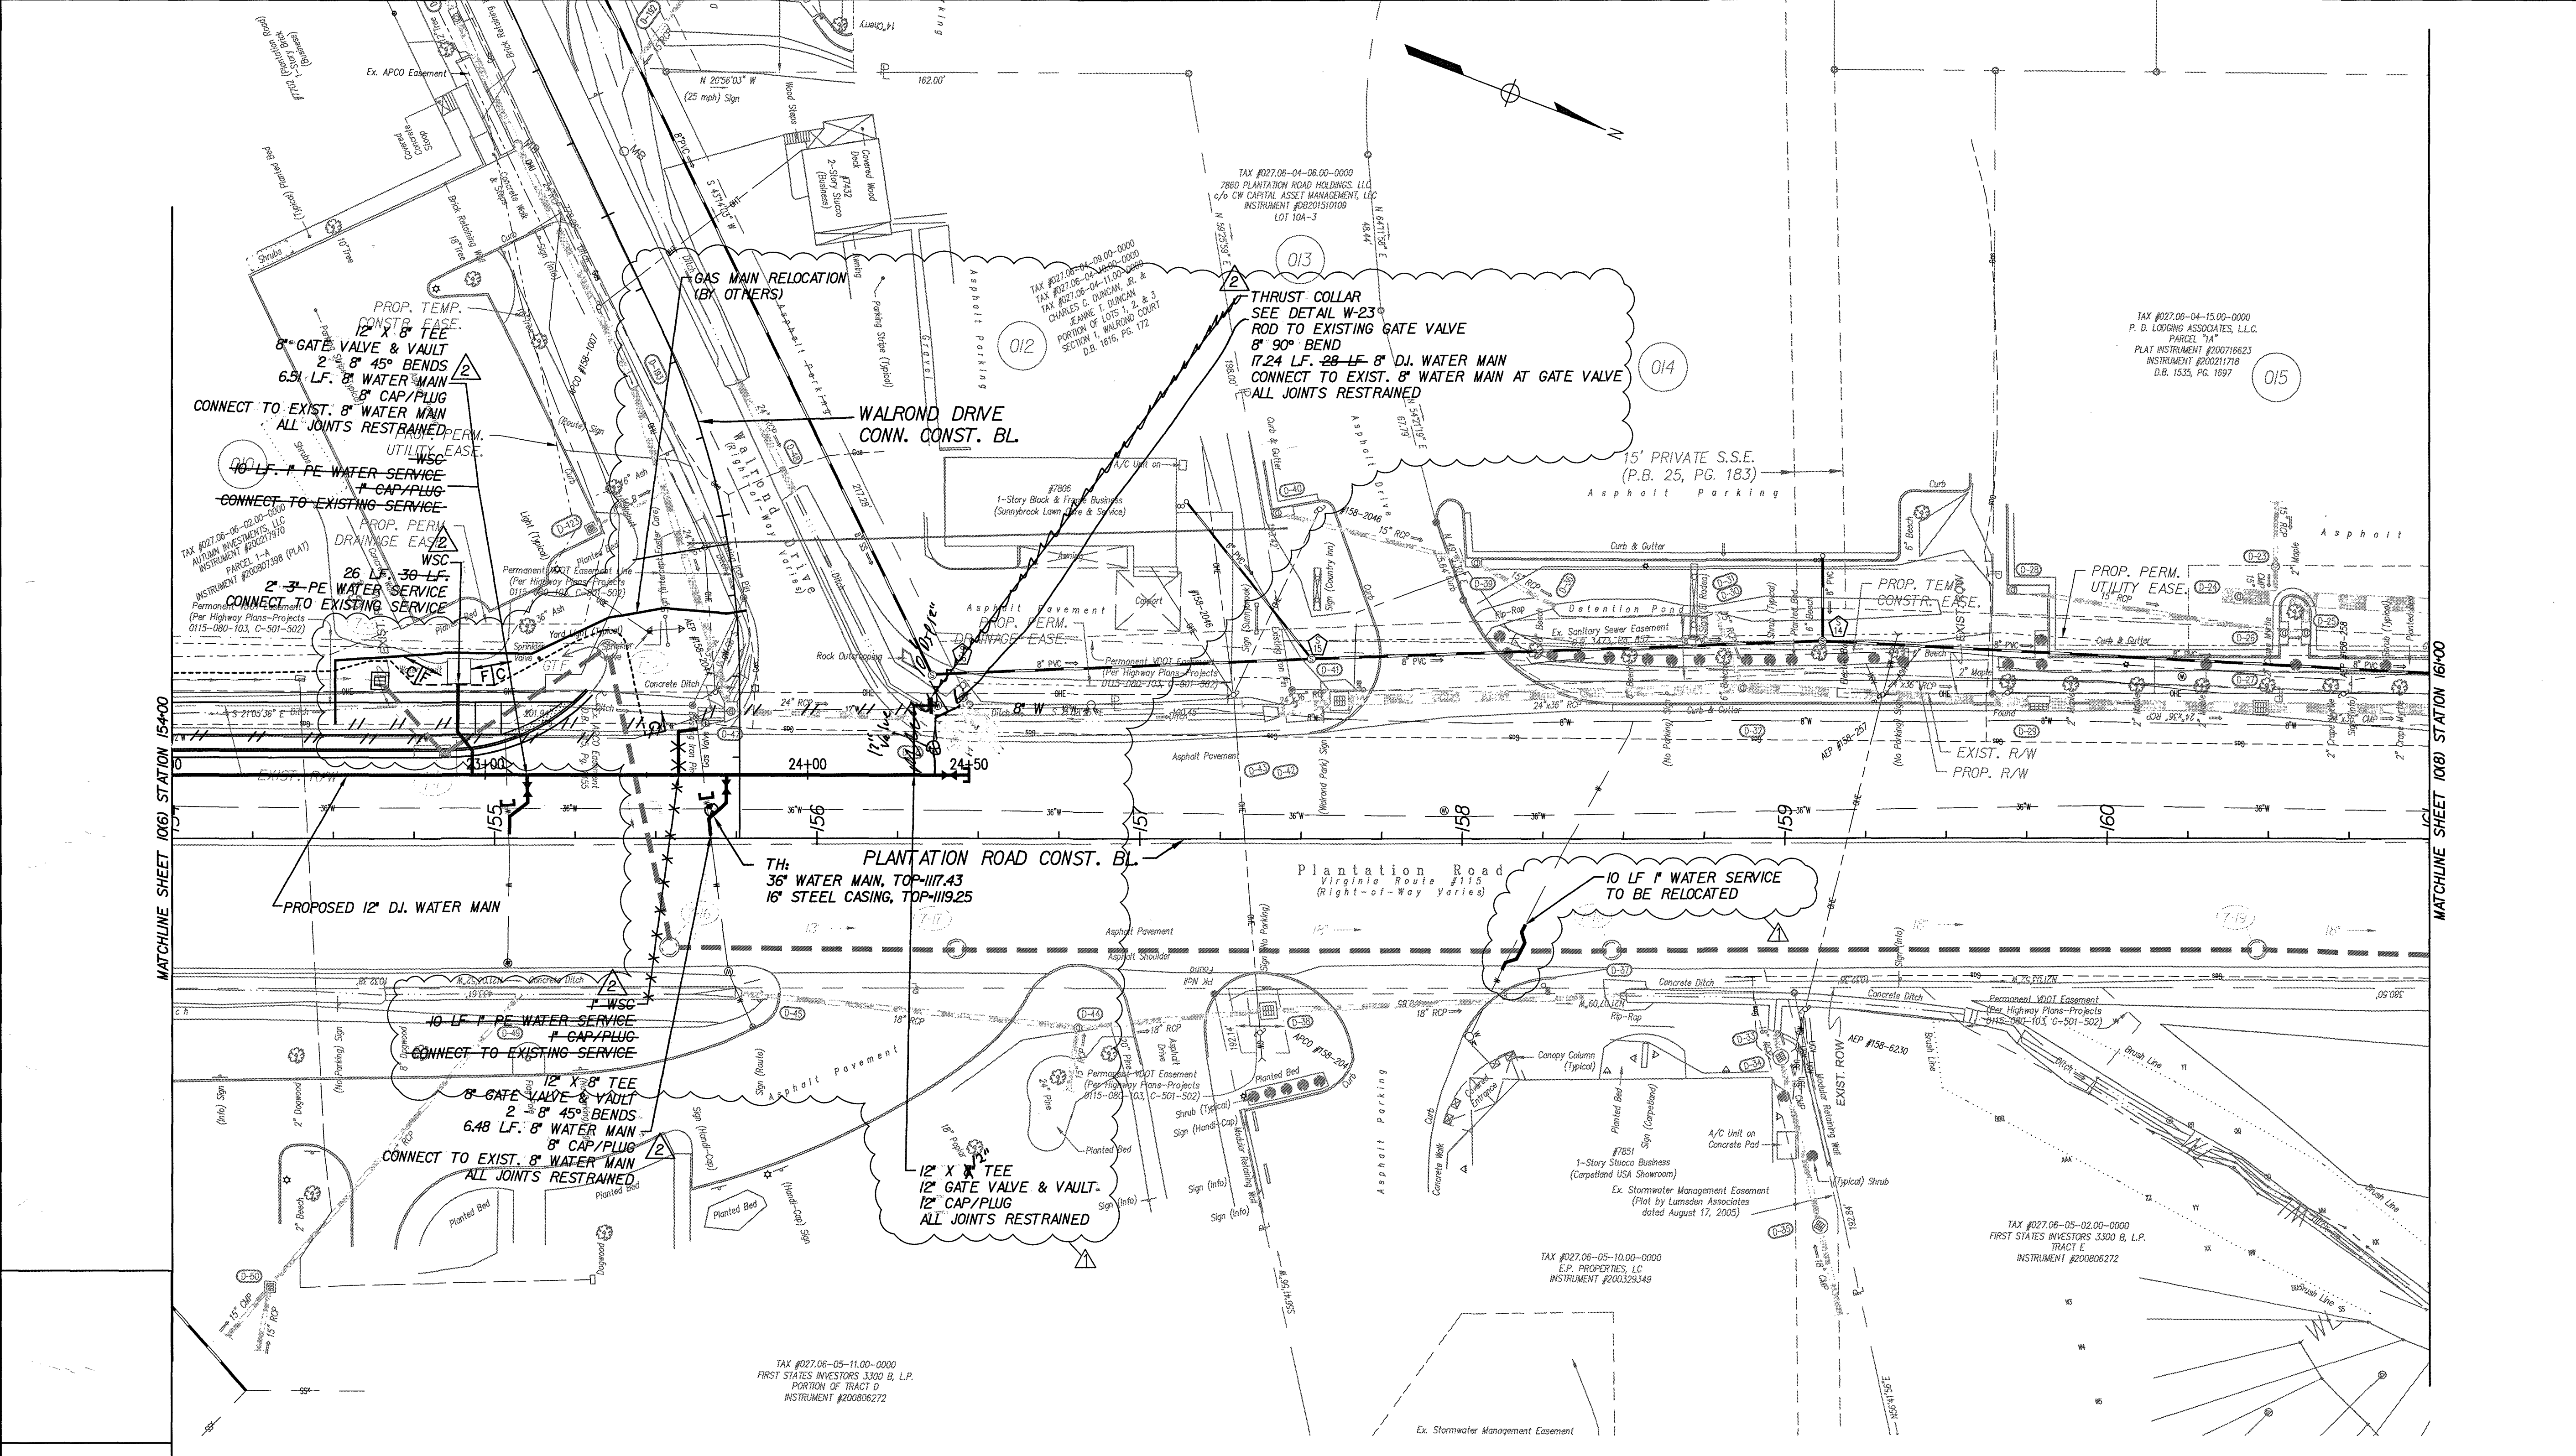

COUNTY OF ROANOKE
5204 BERNARD DRIVE
ROANOKE, VA 24018

VDOT PROJECT NUMBERS:
0115-080-R95, P101, C501 &
EN12-080-823, P101, R201, C501
VDOT UPC NUMBERS: 98220 & 103607

PLANTATION ROAD, BICYCLE, PEDESTRIAN, AND
STREETSCAPE IMPROVEMENTS PROJECT

RECORD DRAWING - MAY 2018
"RECORD DRAWINGS" PREPARED BASED ON MARKUPS
PROVIDED BY THE CONTRACTOR

Rev	Date	Description
2	5/30/2018	RECORD DRAWING
1	7/26/17	STORM SEWER & UTILITY REVISION

Drawing
UTILITY PLAN

Sheet
10(7-1)