

MATCH LINE "C" SEE SHEET 4 of 4

MERIDIAN OF VIRGINIA STATE  
PLANE COORDINATE SYSTEM  
SOUTH ZONE NAD 83

LEGEND	
	PROPERTY LINE
	EASEMENT BEING VACATED P.B. 20 PG. 181 D.B. 1572 PG. 1289
	FENCE
	POWER POLE
	NEW WATER LINE EASEMENT

AS-BUILT LOCATION  
18" WATERLINE

EXISTING VAR. WIDTH WATERLINE &  
10' TEMP. CONST. EASEMENTS (D.B. 1572,  
PG. 1289) BEING VACATED



PROPERTY OF  
**TRUSTEES OF ROANOKE COLLEGE**  
TAX PARCEL 35.04-03-32  
D.B. 1317, PG. 87  
"HANGING ROCK GOLF COURSE"

NEW 25' WATERLINE  
EASEMENT

NEW 10' TEMPORARY  
CONSTRUCTION EASEMENT

AS-BUILT LOCATION  
18" WATERLINE

PROPERTY OF  
**J. SPENCER FRANTZ, ET ALS**  
TAX PARCEL 35.00-01-31  
D.B. 1314, PG. 1604

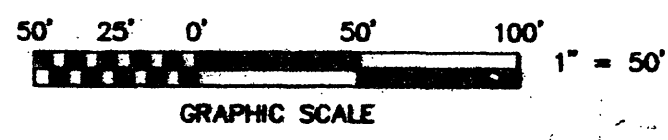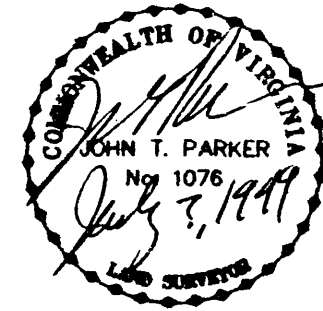

EASEMENT PLAT FOR  
**COUNTY OF ROANOKE**  
SHOWING A NEW 25' WATERLINE EASEMENT AND A  
NEW 10' TEMPORARY CONSTRUCTION EASEMENT  
BEING CONVEYED BY

**TRUSTEES OF ROANOKE COLLEGE**

CATAWBA MAGISTERIAL DISTRICT  
ROANOKE COUNTY, VIRGINIA

**T. P. PARKER & SON**  
ENGINEERS - SURVEYORS - PLANNERS

TAX NO.: 35.04-03-32  
DRAWN: JMS  
CALC.:

SCALE: 1" = 50'  
DATE: JULY 7, 1999  
W.O.: 99-0334

SHEET 3 of 4  
P.B. 22 PG. 99

CLOSED BY JMS