


— EL.=1222.05' EL.=1230.88'— EL.=1228.87' ---EL.=1226.91**'** /-EL.=1224.92**'** \_ EL.=1230.91' \_\_ EL.=12**3**9.35 /— EL.=12**3**5.39' --- EL.=1237.24' — EL.=1237.23' /-- EL.=1231.92**'** ∕— EL.=123\$.84**'** — EL.=123**3**.85**'** ∕— EL.=12\$5.89**'** EL.=1227.56-- EL.=1231.48 UNIT 7 TYPE "A" UNIT 8 TYPE "B" UNIT 9 TYPE "B" UNIT 10 TYPE "A" **←EL.=1224.10** NOT YET COMPLETED NOT YET COMPLETED ---EL.=1231 42 EL.=1209.17-EL. 1227.57 EL.=1214.12 · EL.=1224.12 -EL.=1224.14 EL.=1225.89' -EL.=1220.11 ∠EL.=1210.44 \ EL.=1225.88 EL.=1229.72 EL.=1225.73 — EL.=1222.11' --EL.=1214.53 - EL.=1220.16 **ROOF UNITS 7 - 10** 

FRONT


EL.=1226.95'\

**ROOF UNITS 1 - 6** 

**FRONT** 

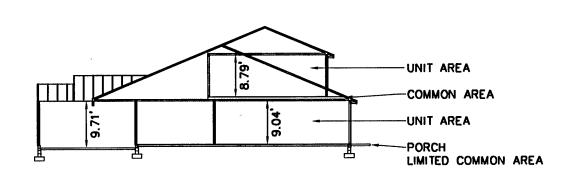

### TYPICAL SECTION UNIT TYPE 'B'

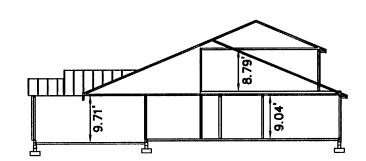

**TYPICAL SECTION** UNIT TYPE 'A'

### **NOTES**

- 1. INCLUDED AS PART OF EACH UNIT IS THE DRY WALL COVERING ENCLOSING SUCH UNIT. ALL INTERIOR DIMENSIONS SHOWN ON THIS PLAT ARE MEASURED TO THE INSIDE FACE OF STUDS OR TO THE INSIDE FACE OF CONCRETE FOUNDATION WALLS.
- 2. ALL VERTICAL DIMENSIONS ARE MEASURED FROM SUB-FLOOR TO BOTTOM OF JOISTS.
- UNIT DIMENSIONS SHOWN ARE TYPICAL AND ARE BASED UPON THE MEDIAN OF FIELD MEASUREMENTS OF ALL UNITS. SUBSTANTIALLY ALL DIMENSIONS FALL WITHIN A TOLERANCE OF 0.08 FEET OF THOSE
- UNIT FLOOR AREAS ARE BASED ON THE BUILDING PLANS AND ARE WITHIN 2% OF THE ACTUAL FLOOR AREAS.

FIRS	FIRST FLOOR		
SUB FLO	SUB FLOOR ELEVATIONS		
UNIT #	ELEVATION		
1	1215.67		
2	1215.00		
3	1213.00		
4	1213.00		
5	1211.00		
6	1211.00		
7	1210.97		
8	1212.97		
9	1212.99		
10	1214.99		

١	SECOND FLOOR		
١	SUB FLOO	OR ELEVATIONS	
١	UNIT #	ELEVATION	
١	1	1225.52	
1	2	1224.85	
ł	3	1222.85	
ı	4	1222.85	
ĺ	5	1220.85	
١	6	1220.85	
١	7	1220.89	
ı	8	1222.90	
	9	1222.93	
	10	1224.92	

	<del> </del>
GARAGE FLOOR	
SUB FLO	OR ELEVATIONS
UNIT #	ELEVATION
1	1215.09
2	1214.42
3	1212.42
4	1212.42
5	1210.42
6	1210.42
7	1210.16
8	1212.23
9	1212.25
10	1214.30

SECO	SECOND FLOOR	
CEILING	CEILING ELEVATIONS	
UNIT #	ELEVATION	
1	1234.31	
2	1233.64	
3	1231.64	
4	1231.64	
5	1229.64	
6	1229.64	
7	1229.01	
8	1230.98	
9	1231.01	
10	1233.04	

FIRST FLOOR		
CEILING	CEILING ELEVATIONS	
UNIT #	ELEVATION	
1	1224.71	
2	1224.04	
3	1222.04	
4	1222.04	
5	1220.04	
6	1220.04	
7	1220.06	
8	1222.07	
9	1222.10	
10	1224.09	
<del></del>		

PLAT OF PHASE IV UNITS 7 & 10 "GLEN IVY"

## A CONDOMINIUM

PROPERTY OF

# RADFORD & COMPANY

SITUATED ALONG GLEN HEATHER DRIVE AND GRANDIN ROAD EXTENSION, S.W. ROANOKE, VIRGINIA

SCALE: 1" = 20' DATE: 5 SEPTEMBER 1996

LUMSDEN ASSOCIATES, P.C. ENGINEERS - SURVEYORS - PLANNERS ROANOKE, VIRGINIA

THOUSE DE LANGE	
B. LEE Z. HENDERSON, JR.	
B. Muffend Jr. No. 17591	
ONAL ENGINEE	

	LEGEND
VERTICAL DATUM	U.S.G.S. MEAN SEA LEVEL 1929
	DENOTES LIMITED COMMON AREA
	DENOTES GENERAL COMMON AREA
1,650 S.F.	AREA OF UNIT (SQUARE FEET)
<b>†</b>	ORIENTATION FOR PLAN VIEW
HT.=8.70'	DISTANCE FLOOR TO CEILING
	LIMITS OF COMMON AREA BELOW SECOND FLOOR

#### ENGINEER'S CERTIFICATE

I, B. LEE HENDERSON, JR., A REGISTERED ENGINEER IN THE COMMONWEALTH OF VIRGINIA, HEREBY CERTIFY THAT THIS PLAN, EXHIBIT "A", ACCURATELY SHOWS THE UNITS DELINEATED AND COMPLIES WITH THE PROVISIONS OF SECTION 55-79.58 PARAGRAPH (B) OF CONDOMINIUM ACT. I FURTHER CERTIFY THAT UNLESS NOTED OTHERWISE ALL UNITS DEPICTED HEREON HAVE BEEN SUBSTANTIALLY COMPLETED.

GIVEN UNDER MY HAND THIS \_5 TH DAY OF SEPTEMBER\_, 1996.

B. LEE HENDERSON, JR., P.E.