


Note:-
Red lines on this map
show easement indicated
on map filed Oct. 23, 1922

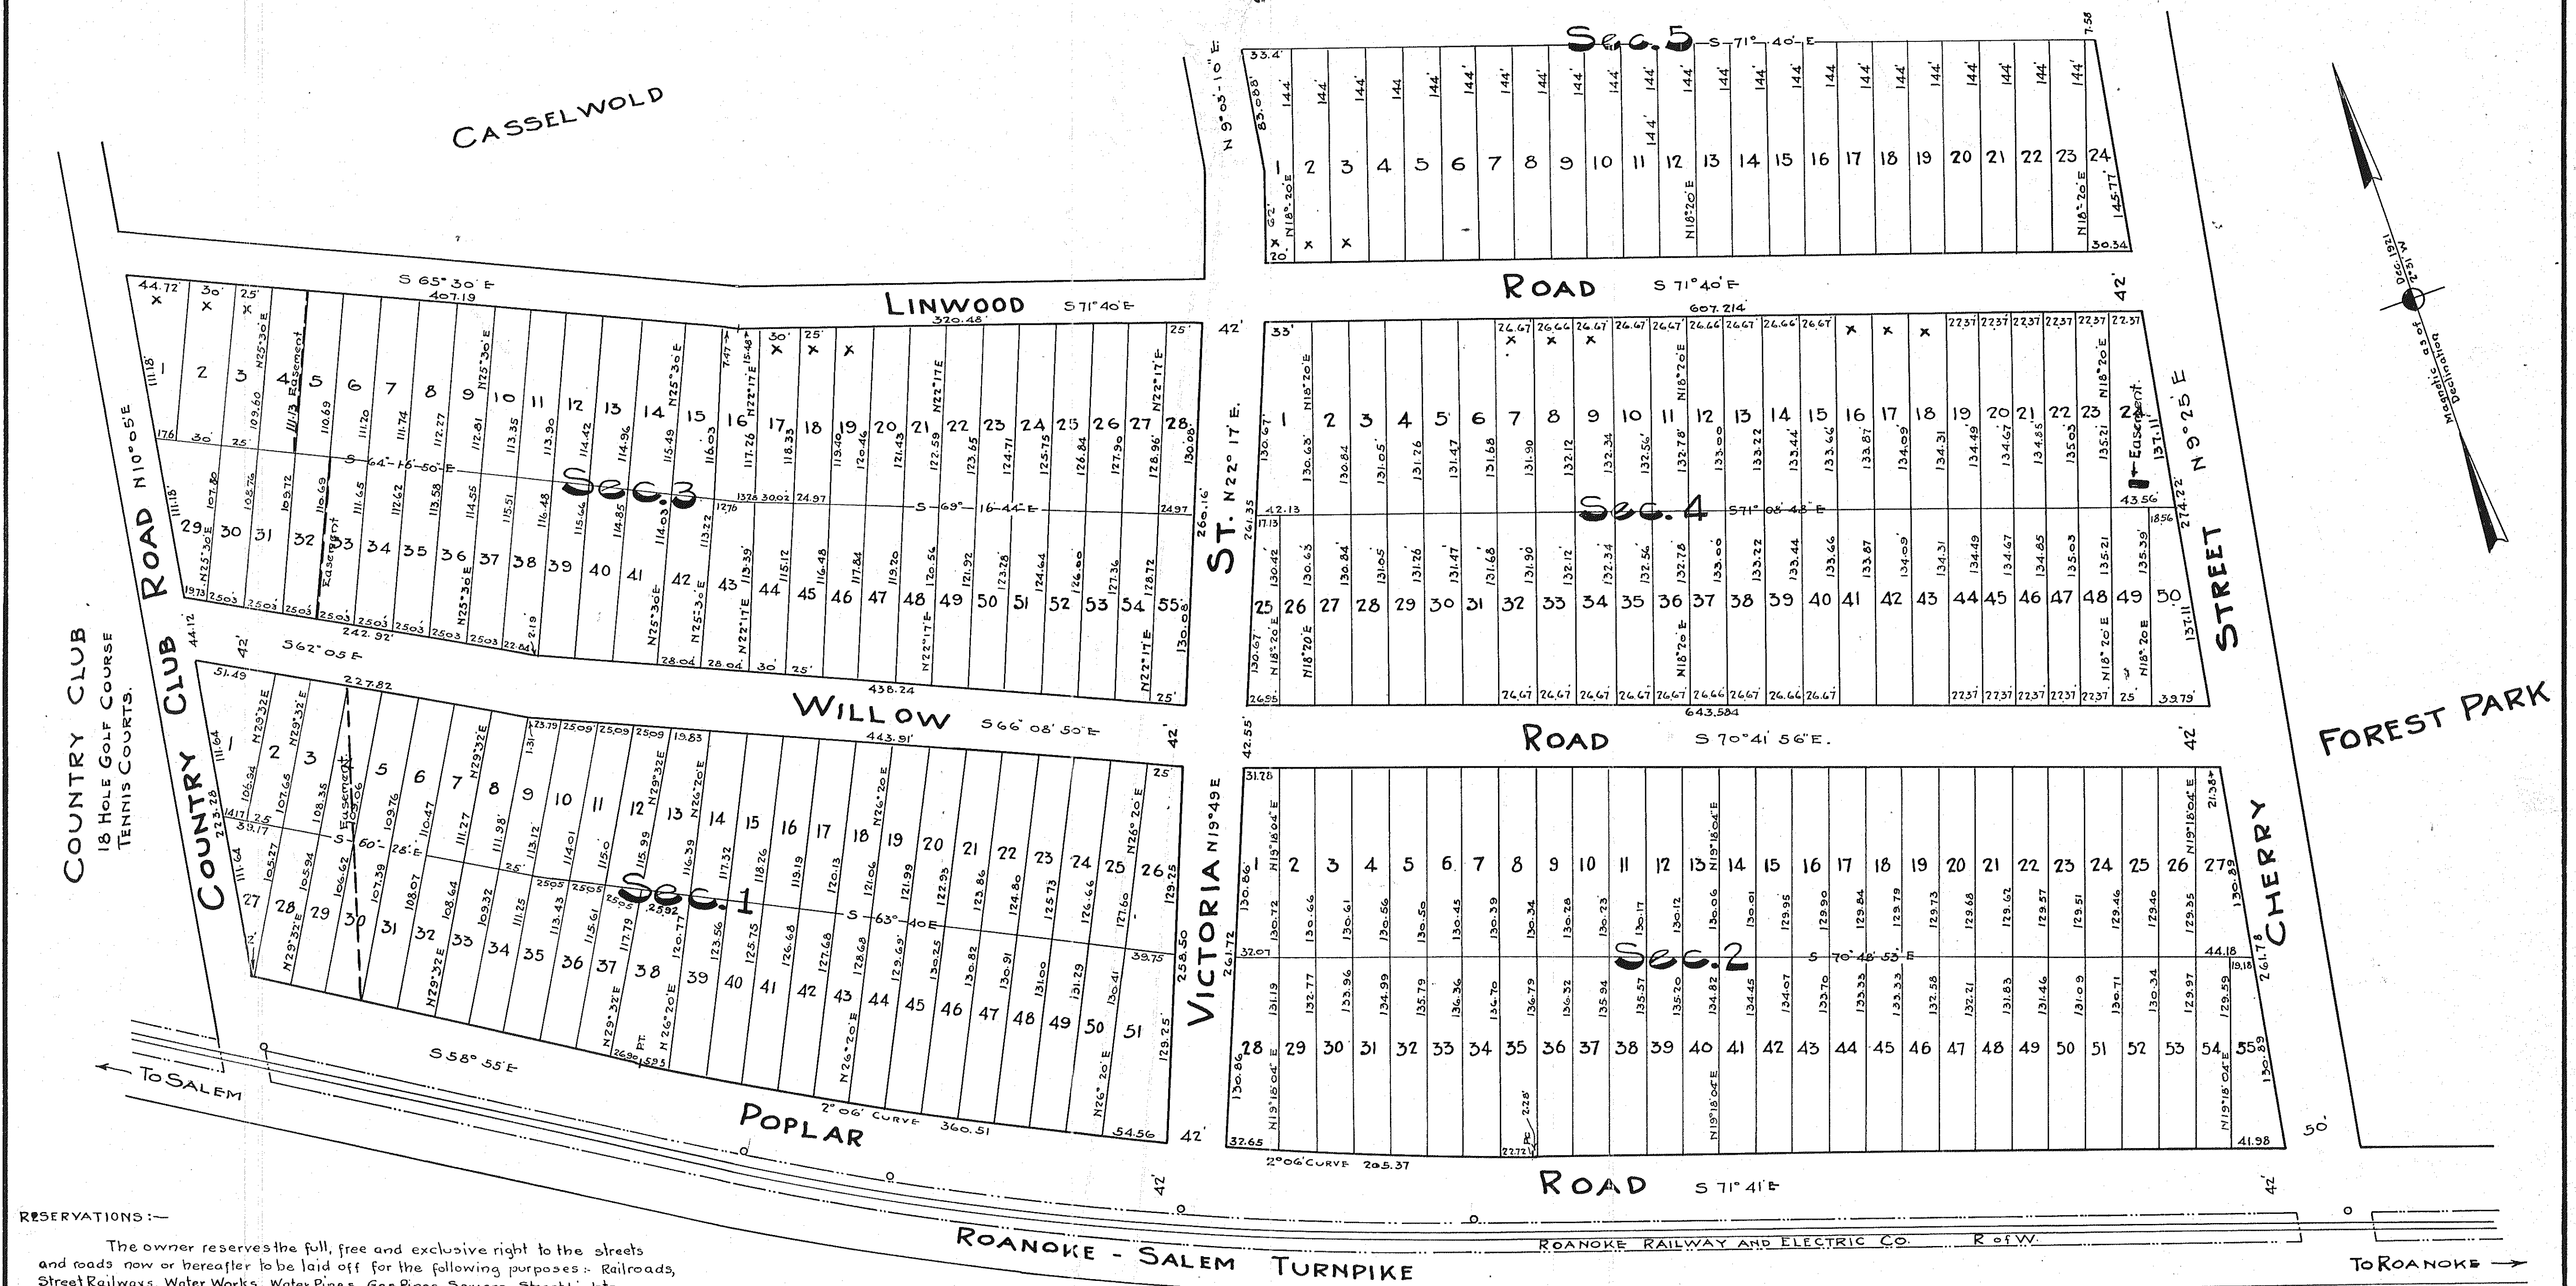

RESERVATIONS:-

The owner reserves the full, free and exclusive right to the streets and roads now or hereafter to be laid off for the following purposes: Railroads, Street Railways, Water Works, Water Pipes, Gas Pipes, Sewers, Street Lights, Electric Works, Poles, Wires, Conduits, Telegraph, Telephone Wires, Poles and Conduits. He also reserves the right to modify this plan by changing size and shape of Blocks and Lots, width, grade, direction and location of Streets and Roads, and of abolishing or closing streets and roads, provided no such streets or roads shall be abolished where same abut or pass through Blocks in which one or more lots have been previously sold without the consent in writing by the owners of such lots. The Streets and Roads laid out on this plan are not dedicated to the public but are expressly reserved by the owner to be used and enjoyed subject to the conditions above stated, by those owning and occupying lots shown hereon. The use of same by the public shall not be treated or construed as a dedication thereof to public uses.

PRELIMINARY MAP No.3
ALL LOTS 25' FRONTAGE EXCEPT
OTHERWISE NOTED.

Plan of Lots
in
GROVE PARK
ROANOKE COUNTY
VIRGINIA.

SCALE: 1"=60'
CORRECTED TO OCT. 5, 1922
OCT. 21, 1922

The above Sub-division of Land in Roanoke County, Virginia, owned by E.D. Heins and known as Grove Park, as appears in this plat is with the free consent and in accordance with the desire of the undersigned owner.

Sworn to and acknowledged before me this 5th day of December 1922

Lona M. Porter
Notary Public

My commission expires May 4th 1924.

In the Clerk's Office of the Circuit Court for the County of Roanoke, Va. this 15th day of Dec. 1922, this map was presented, and with the certificate of acknowledgment thereto, annexed, admitted to record at 2 o'clock P.M.
Test: Chas. D. Smith, Clerk.

PREPARED BY
GEO. W. HUTCHINSON
CONSULTING ENGINEER
ROANOKE, VA.
C-654
JILLYON, C.E. ASSOCIATE.

This tracing made May 30th 1928 from original Blue Print on file in the office of the Clerk of the Circuit Court of Roanoke County at Salem, Virginia.
Made by *J.R. Hillman*
Checked by *J.R. Hillman*