




CLAY AND NEEL, INC.
Professional Engineer
Civil Engineering License No. 10073
P.O. Box 10073
Raleigh, NC 27602
Phone: (919) 872-0001
Fax: (919) 872-0770
Web: www.clayandneel.com

The drawing, design, and specifications are prepared by the engineer and are not to be construed as a contract. The engineer is not responsible for the construction of the project. The engineer is not responsible for the construction of the project.

RECORD SET - 09/30/2022
POINT PLEASANT SUBDIVISION
DEVELOPMENT PLAN

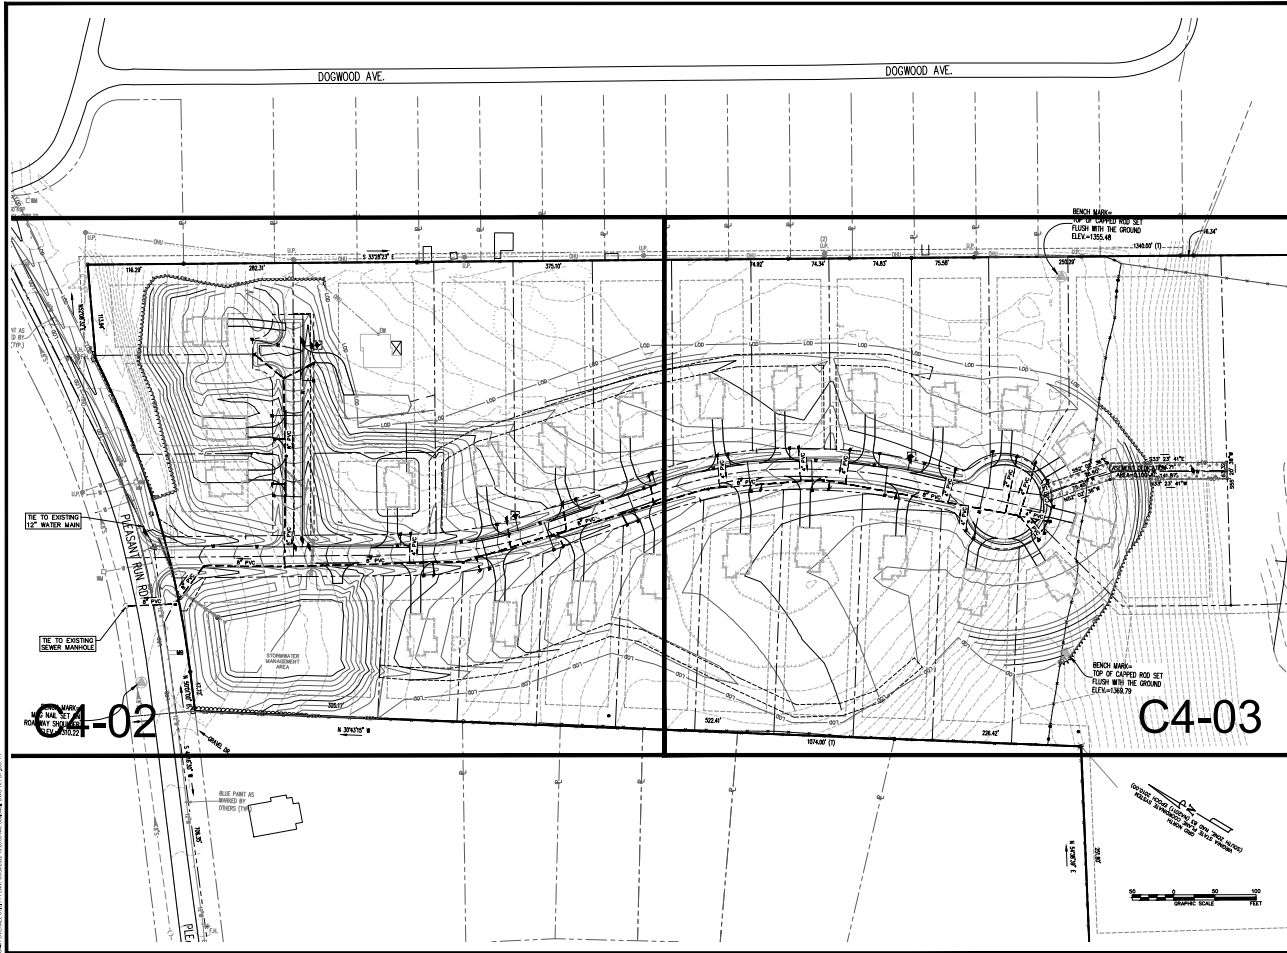

NO.	COMMENTS	DATE
1	REVISIONS	
2		
3		
4		
5		
6		
7		
8		
9		
10		

PROJECT TEAM
1. JENNIFER L. GRIFFIN, P.E.
2. JAMES L. GRIFFIN, P.E.
3. JAMES L. GRIFFIN, P.E.
4. JAMES L. GRIFFIN, P.E.
5. JAMES L. GRIFFIN, P.E.
6. JAMES L. GRIFFIN, P.E.
7. JAMES L. GRIFFIN, P.E.
8. JAMES L. GRIFFIN, P.E.
9. JAMES L. GRIFFIN, P.E.
10. JAMES L. GRIFFIN, P.E.
ISSUE DATE
04/09/20
ISSUE NO.
2997
SHEET TITLE
OVERALL UTILITY PLAN
SHEET NUMBER
C4-01