


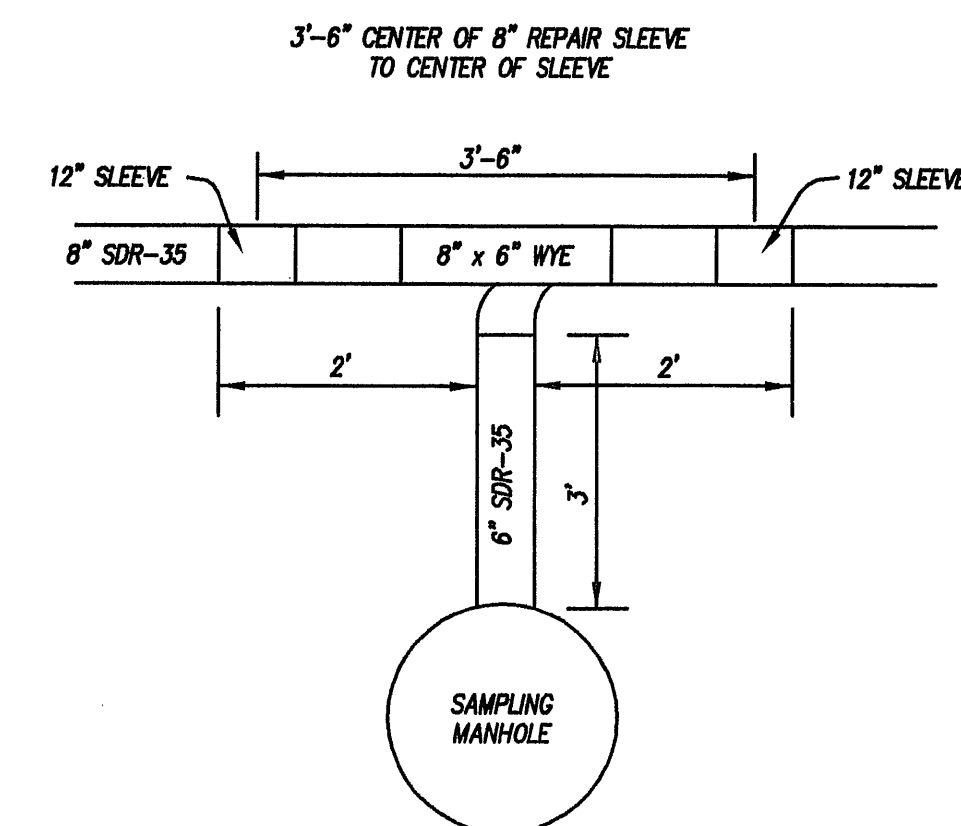

LEGEND		
ITEM	EXISTING	PROPOSED
Pavement	=====	=====
Curb and Gutter	=====	=====
Curb	=====	=====
Concrete	=====	=====
Sanitary Sewer Manhole	⊙	●
Sanitary Sewer Line	---SS---	---6" SS---
Waterline	---W---	---12" W---
Hydrant	⊕	
Gate Valve	⊙	⊙
Utility Pole	⌵	
Overhead Electric Line	---OHT---	
Overhead Telephone Line	---OHT---	
Contours	--- -1020 ---	---1020---

- | REVISIONS | | |
|-----------|----------|--|
| NO. | DATE | DESCRIPTION |
| 1 | 12/20/05 | TE DOWN TO SHUTTING MAHMOUD AND
STARTING MAHMOUD TESTAL |
| 2 | | |
| 3 | | |
| 4 | | |
| 5 | | |

SHEET 4 OF 8

DIMENSIONAL LAYOUT

As-Built

**PORSCHE SHOWROOM
WALKER AUTOMOTIVE COMPLEX
PREPARED FOR
JAMES R. WALKER OF ROANOKE, LLC
CAVE SPRING MAGISTERIAL DISTRICT
ROANOKE COUNTY, VIRGINIA**