


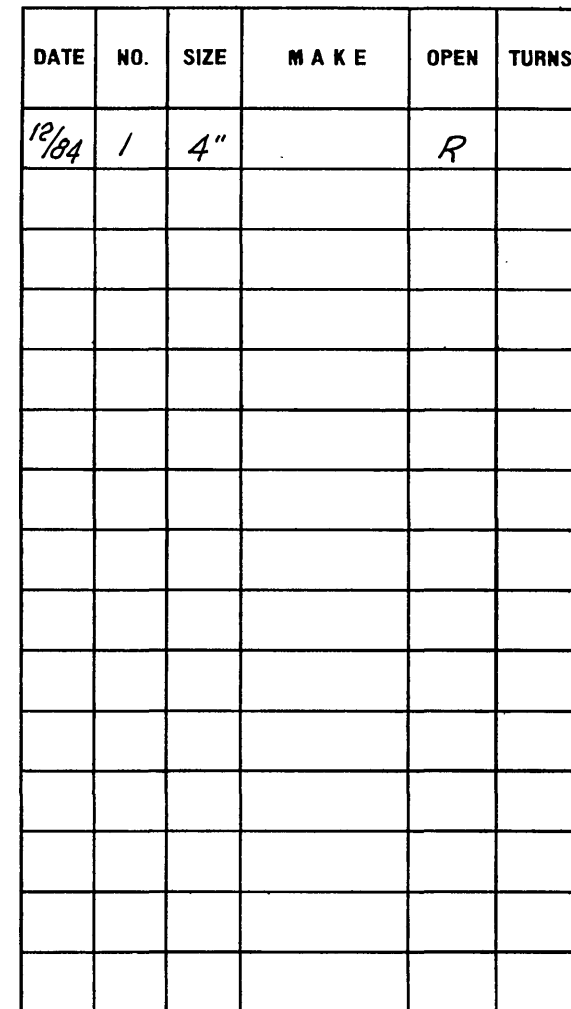

HILLENDALE DRIVE &
THELMA STREET. N.W.

DATE **4-8-85** PAGE NO.