


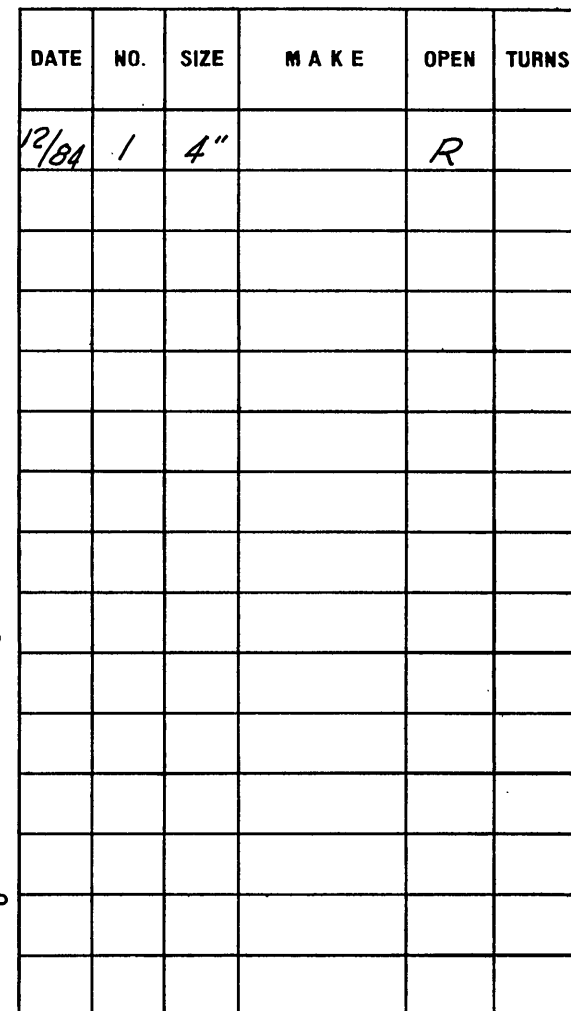

CITY OF ROANOKE—WATER DEP'T	
VALVE DIAGRAM	
PORTLAND AVENUE	
SEC. MAP	641 N.W.
DATE 4-8-85	PAGE NO.