## EXPANSION PLAN

FOR

# PRESTON OAKS BAPTIST CHURCH

DPGD OHKS
NOTONED
INFONET

NOTICE:

All Landowners, Developers and Contractors

FAILURE TO COMPLY WITH THE CONSTRUCTION PROCEDURE REQUIREMENTS LISTED BELOW MAY RESULT IN THE COSTLY REMOVAL OF STRUCTURES, TIME DELAYS, OR THE ISSUANCE OF A STOP WORK ORDER.

#### CONSTRUCTION PROCEDURE REQUIREMENTS

- 1. Right-of-Way Excavation Permit Prior to the commencement of any digging, alteration, or construction within the public right-of-way (streets, alleys, public easements), a right-of-way excavation permit shall be applied for and obtained by the contractor from the City of Roanoke.
- 2. Land Disturbance Permit An approved erosion and sediment control plan for any borrow/fill sites associated with the project must be submitted prior to the issuance of a land disturbance permit.
- 3. Plans and Permits A copy of the plans as approved by the City (signed by the proper City officials) and all permits issued by the City shall be available at the construction site at all times of ongoing construction.
- 4. Location of Utilities The contractor shall verify the location of all existing utilities prior to the commencement of any construction.
- 5. Construction Entrance The contractor shall install an adequate construction entrance for all construction related egress from the site. Size and composition of construction entrance shall be as shown on the plans.
- 6. Streets to Remain Clean It shall be the responsibility of the contractor to insure that the public street adjacent to the construction entrance remains free of mud, dirt, dust, and/or any type of construction materials or litter at all times.
- 7. Barricades/Ditches The contractor shall maintain the integrity of all excavated ditches and shall furnish and ensure that all barricades proper and necessary for the safety of the public are in place.
- 8. Sewer and Pavement Replacement Construction of sanitary sewers and the replacement of pavement shall be in accordance with approved standards and specifications of the City of Roanoke and the Western Virginia Water Authority.
- 9. Approved Plans/Construction Changes Any change or variation from construction design as shown on the officially approved plans shall be approved by the erosion and sediment control agent prior to said changes or variation in construction being made.
- 10. Final Acceptance/City: The owner or developer shall furnish the City of Roanoke's Planning Building and Development Department with a final correct set of as—built plans prior to final acceptance by the City.


SITUATED AT

102 PRESTON AVENUE, NE THE CITY OF ROANOKE, VIRGINIA

DATE: April 20, 2010

PREPARED FOR

# PRESTON OAKS BAPTIST CHURCH TRUSTEES

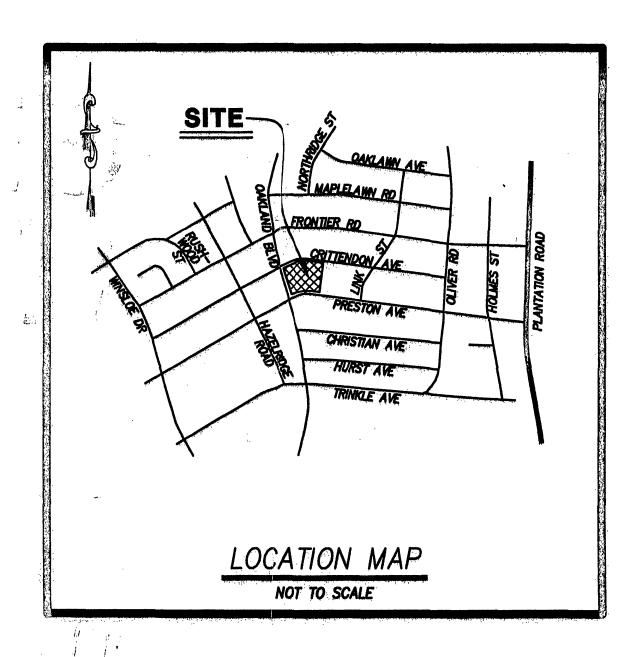

## --INDEX OF DRAWINGS--

### SHEET No.

### DESCRIPTION

The company of the co

1. . . . LUMSDEN ASSOCIATES COVER SHEET

2. . . . . . NOTES & DETAILS

3. . . . DIMENSIONAL LAYOUT

4 . . . . . GRADING PLAN


5. . . . . . PROFILES AND SWM DETAILS

6....LANDSCAPE PLAN

7. . . . . . EROSION & SEDIMENT CONTROL PLAN

8. . . . . EROSION & SEDIMENT CONTROL AND LIGHTING DETAILS


540, 420.1961 Johnny Reston Price Preston Plumbine

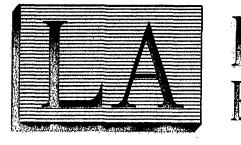

# LUMSDEN ASSOCIATES, P.C. ENGINEERS-SURVEYORS-PLANNERS

4664 BRAMBLETON AVENUE, SW P.O. BOX 20669 ROANOKE, VIRGINIA 24018

PHONE: (540) 774-4411 FAX: (540) 772-9445 E-MAIL: MAIL@LUMSDENPC.COM

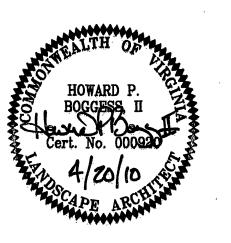

City of Roaneke
Planning Building and Development

DEVELOPMENT PLAN APPROVED

Agent, Planning Commission

Development Engineer

Agent Planning Commission

Development Engineer

Amy Administrator

Amy Administrator

Any changes to this approved plan must be coordinated with the Agent to the Planning Commission and revisions approved prior to construction

COMMISSION NO:
09-202
SHEET 1 OF 8

As-Built 3.2.11 K Winslow