


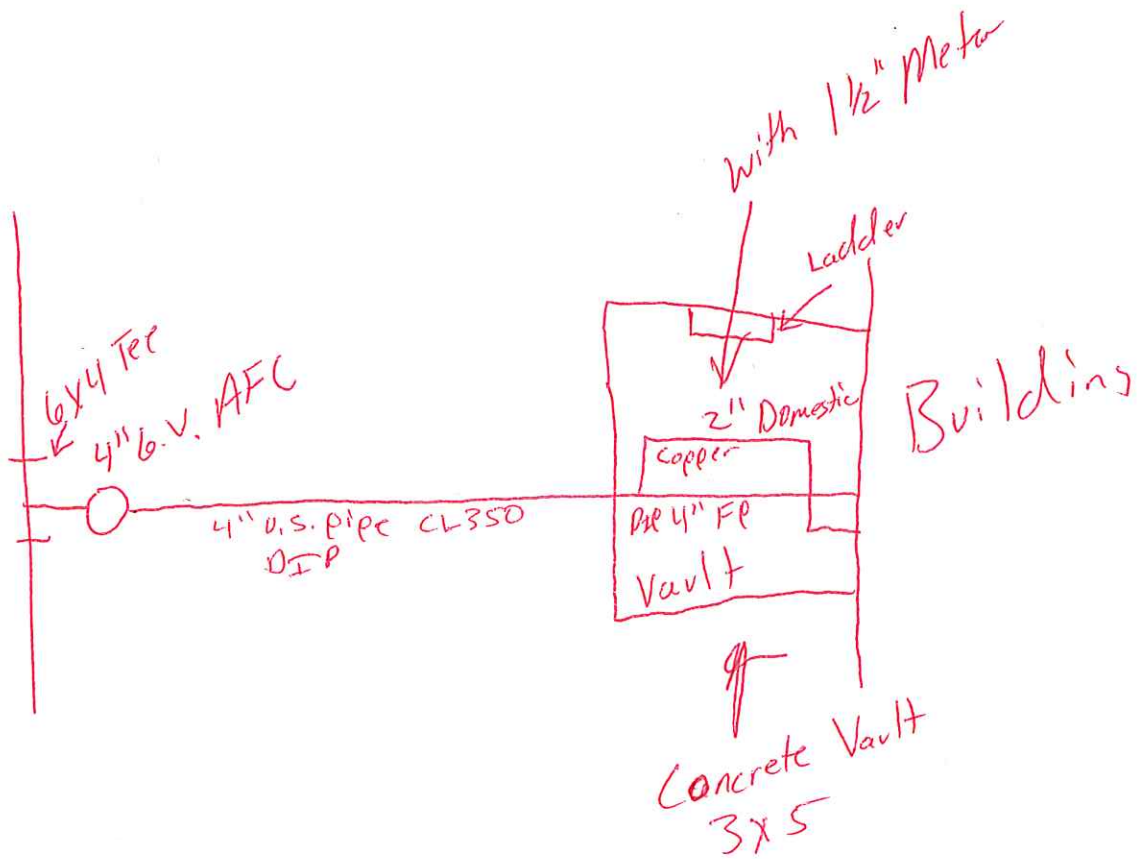

Brian Whitnack

12/11/19

As-built