



BALZER & ASSOCIATES
PLANNERS / ARCHITECTS
ENGINEERS / SURVEYORS

Roanoke / Richmond
New River Valley / Staunton
Harrisonburg / Lynchburg
www.balzer.cc

1208 Corporate Circle
Roanoke, VA 24018
540.772.9580

PROJECT TITLE:
PROJECT SHOOTING STAR
BOTETOURT, VA

B SEAL:



SUBMITTALS / REVISIONS:	
NO.	DATE DESCRIPTION
6/10/2021	1ST SUBMITTAL
9/1/2021	2ND SUBMITTAL
9/22/2021	3RD SUBMITTAL

PROJECT NO.: 04200081.00
DRAWN BY: KAM

SHEET TITLE:
LAYOUT & UTILITY PLAN B


These plans drawings are the property of the registered architect and may not be copied, reproduced or used without his written permission.

SHEET NO.:

C4.2

SHADING LEGEND:

	STANDARD DUTY ASPHALT
	HEAVY DUTY ASPHALT
	RIGHT OF WAY ASPHALT
	CONCRETE
	GRAVEL

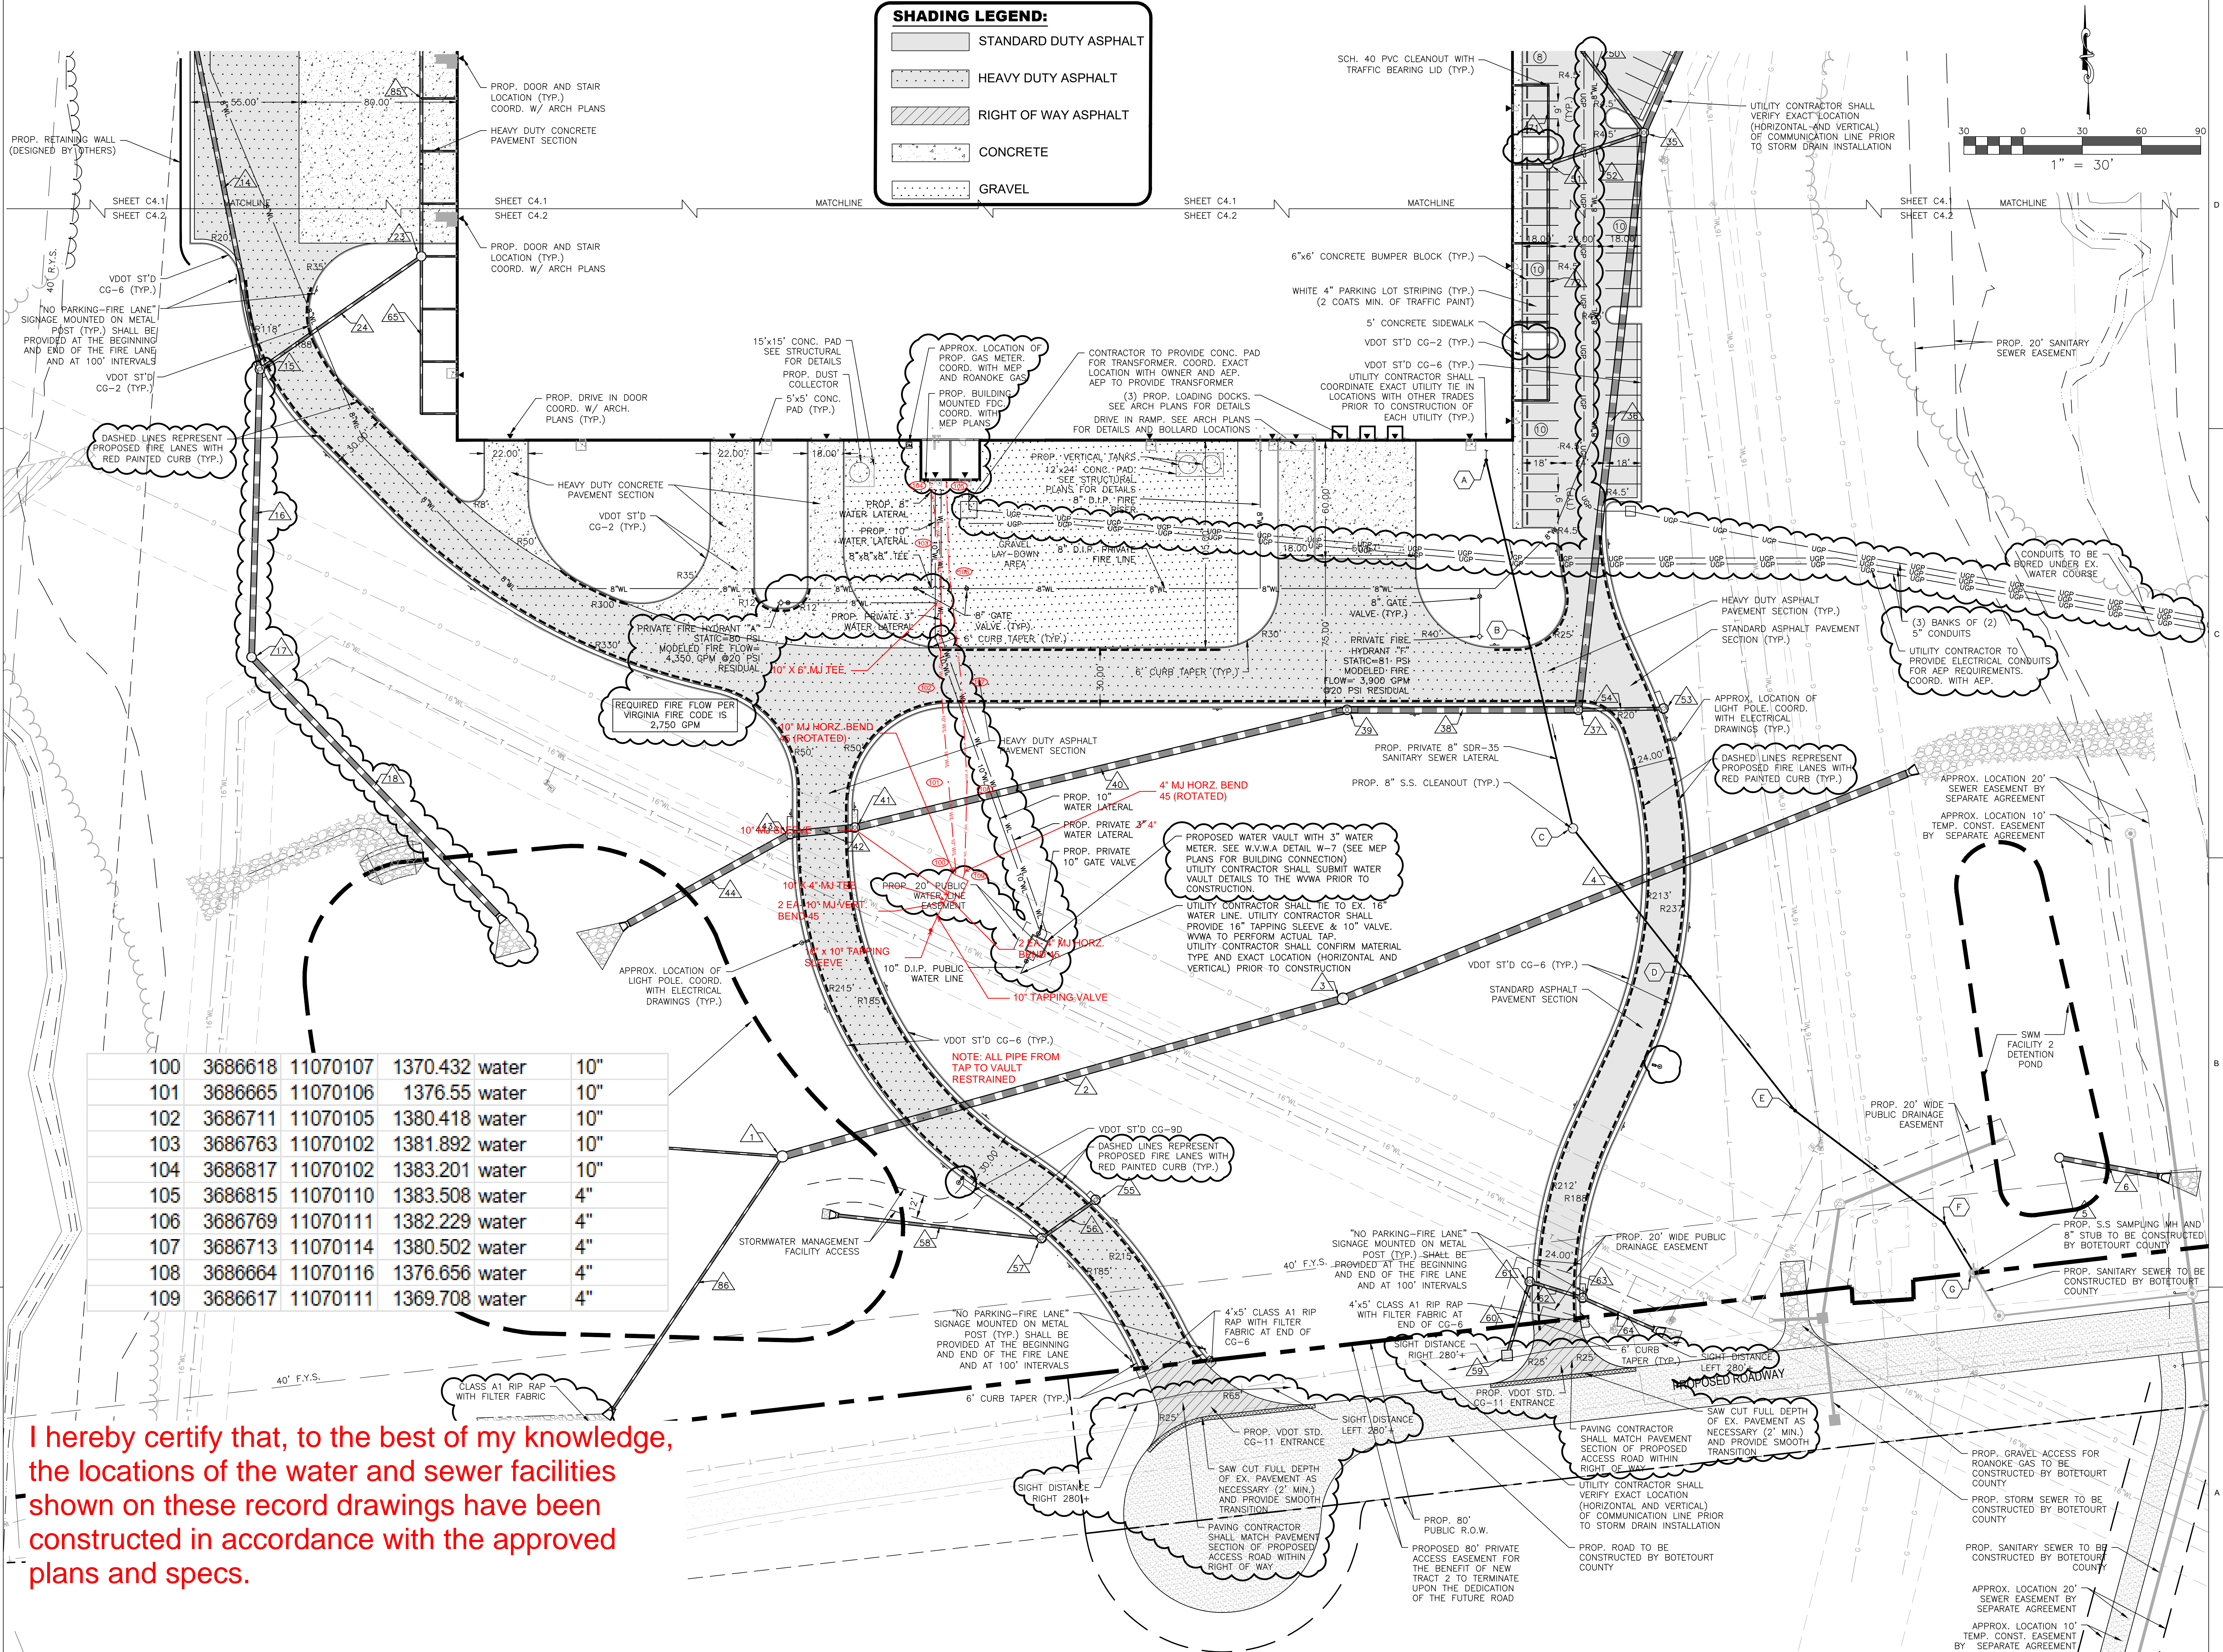

100	3686618	11070107	1370.432	water	10"
101	3686665	11070106	1376.55	water	10"
102	3686711	11070105	1380.418	water	10"
103	3686763	11070102	1381.892	water	10"
104	3686817	11070102	1383.201	water	10"
105	3686815	11070110	1383.508	water	4"
106	3686769	11070111	1382.229	water	4"
107	3686713	11070114	1380.502	water	4"
108	3686664	11070116	1376.656	water	4"
109	3686617	11070111	1369.708	water	4"

I hereby certify that, to the best of my knowledge, the locations of the water and sewer facilities shown on these record drawings have been constructed in accordance with the approved plans and specs.