


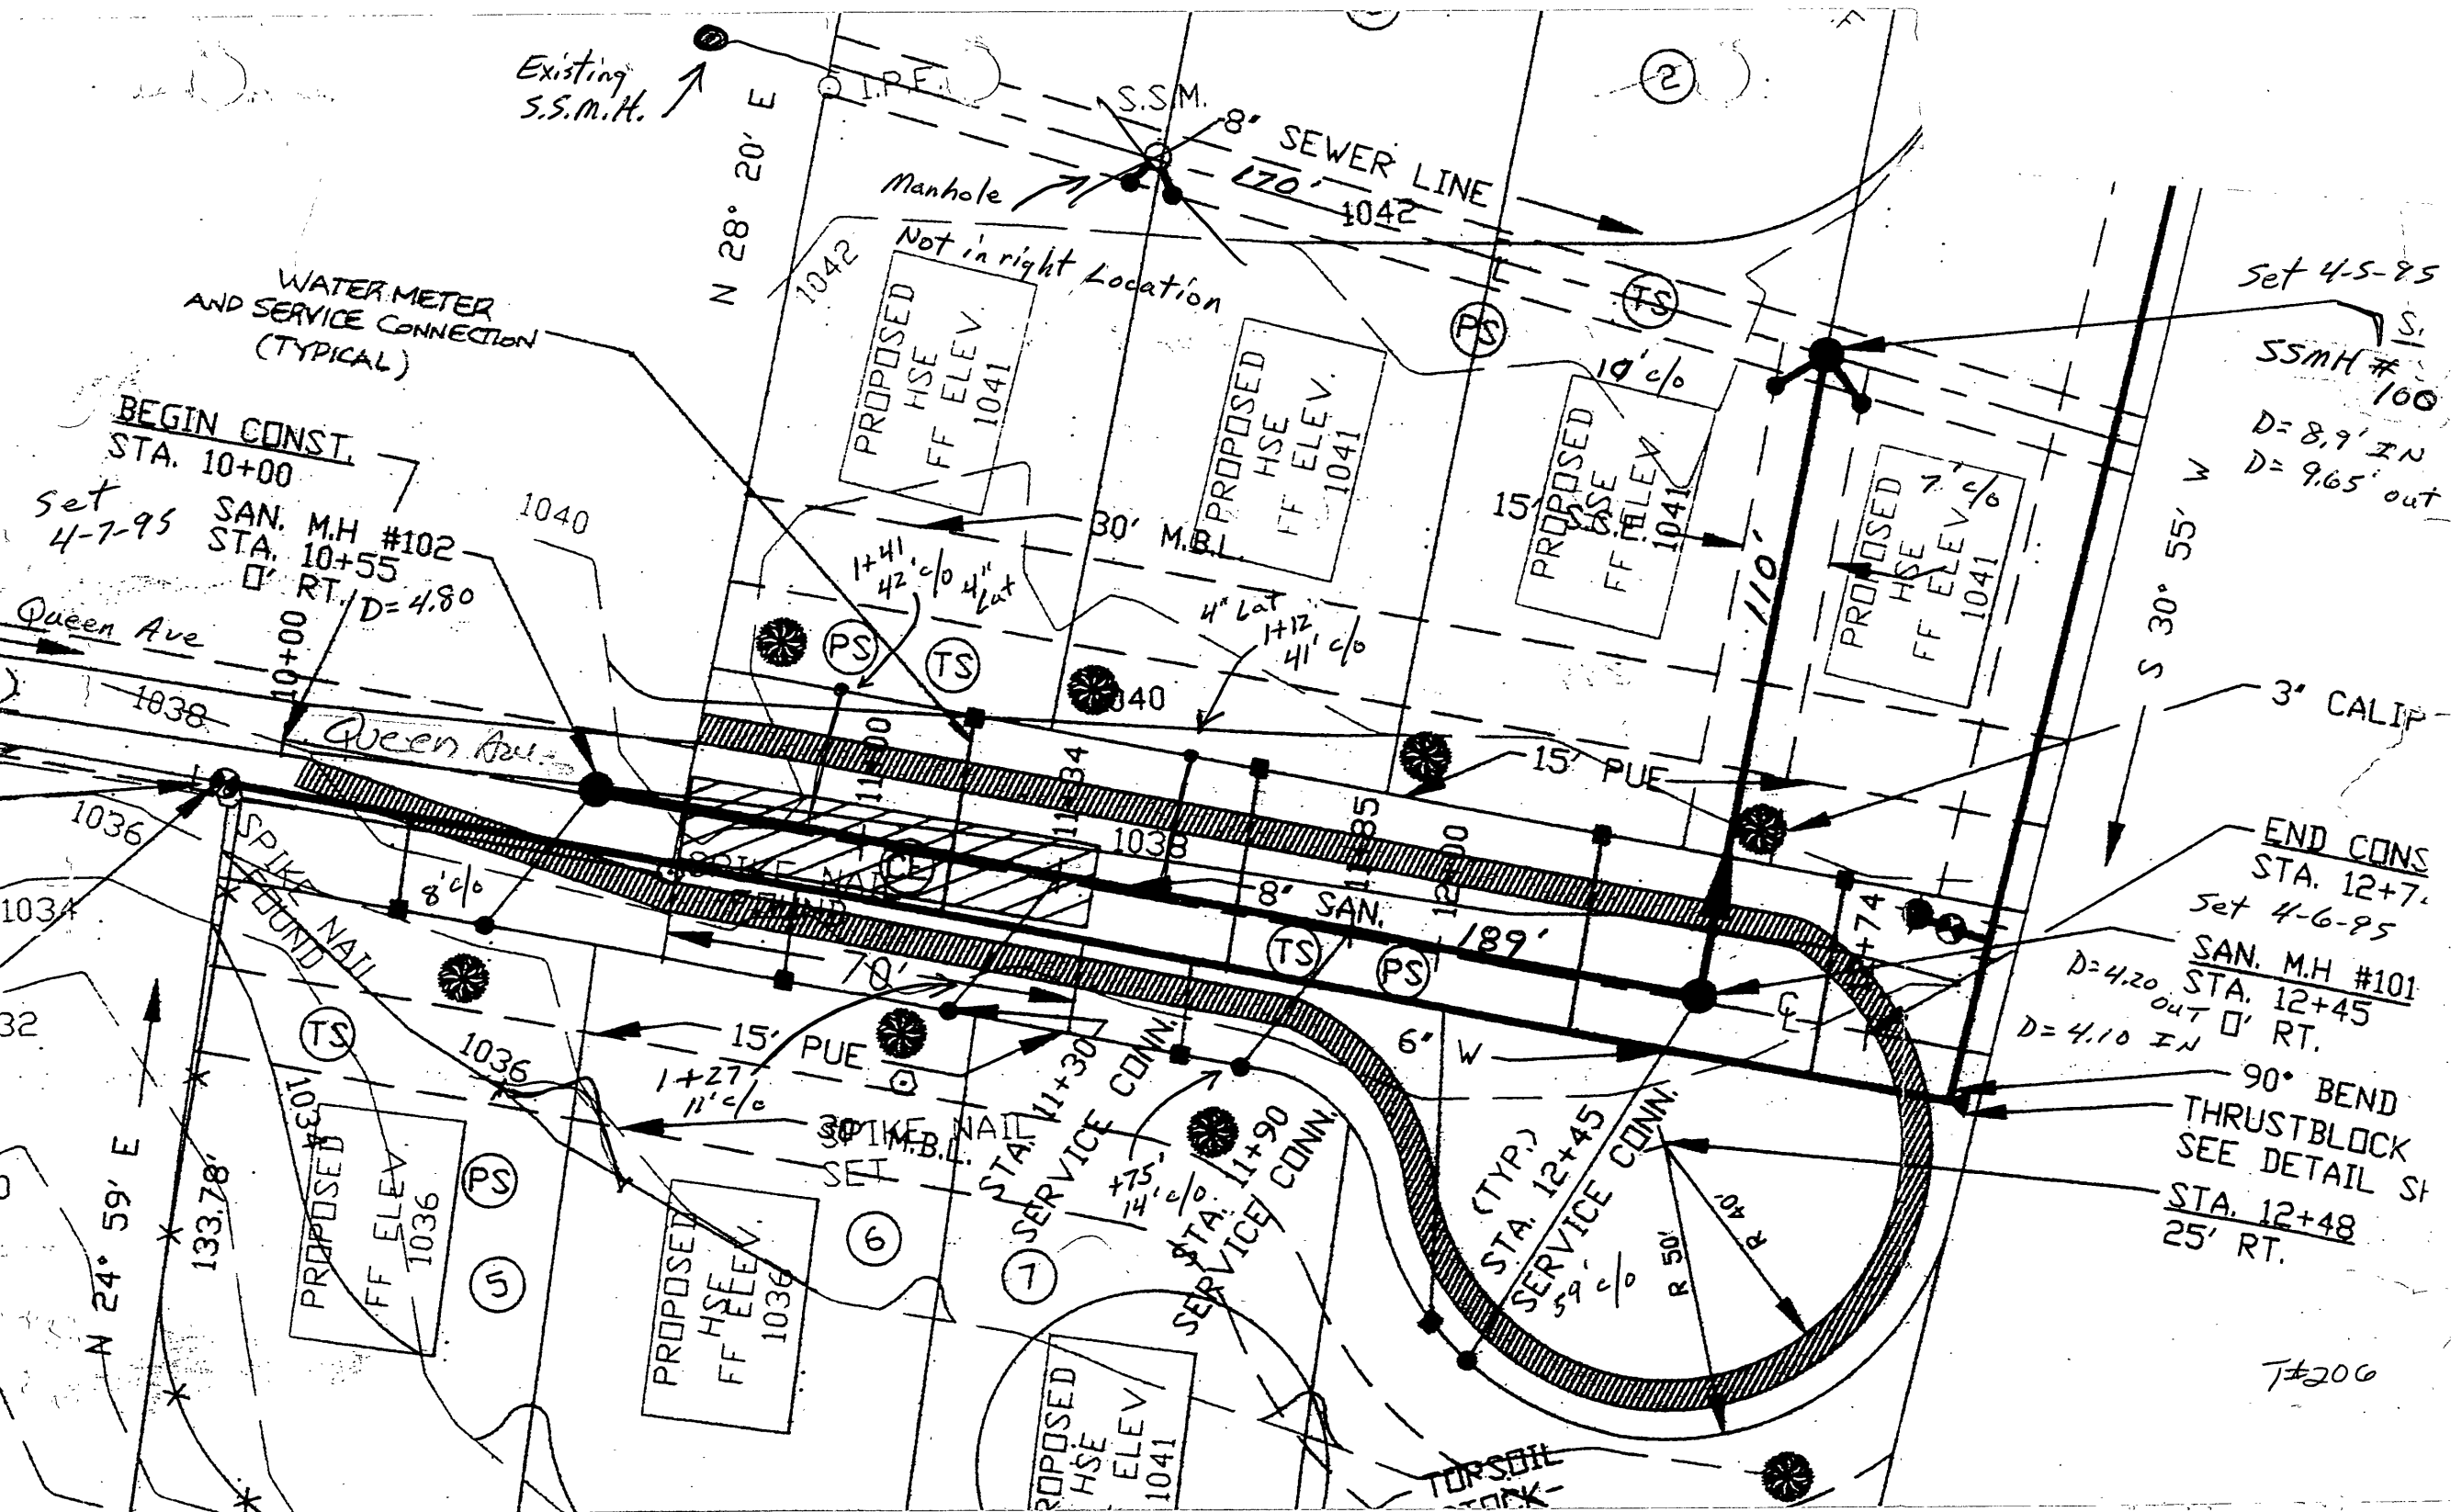

Contractor: Terry St. Clair : Sidney Jordan

Date Started: 4-4-95

Date Completed: 4-10-95

Air Tested Sewer Line 4-10-95 = O.K.

299'-8" sewer main (pvc)

8 - 4" sewer laterals.

3 new manholes

Plus All the sewer laterals has 4' stubs behind the c/p

St. Opening Permit #00123