


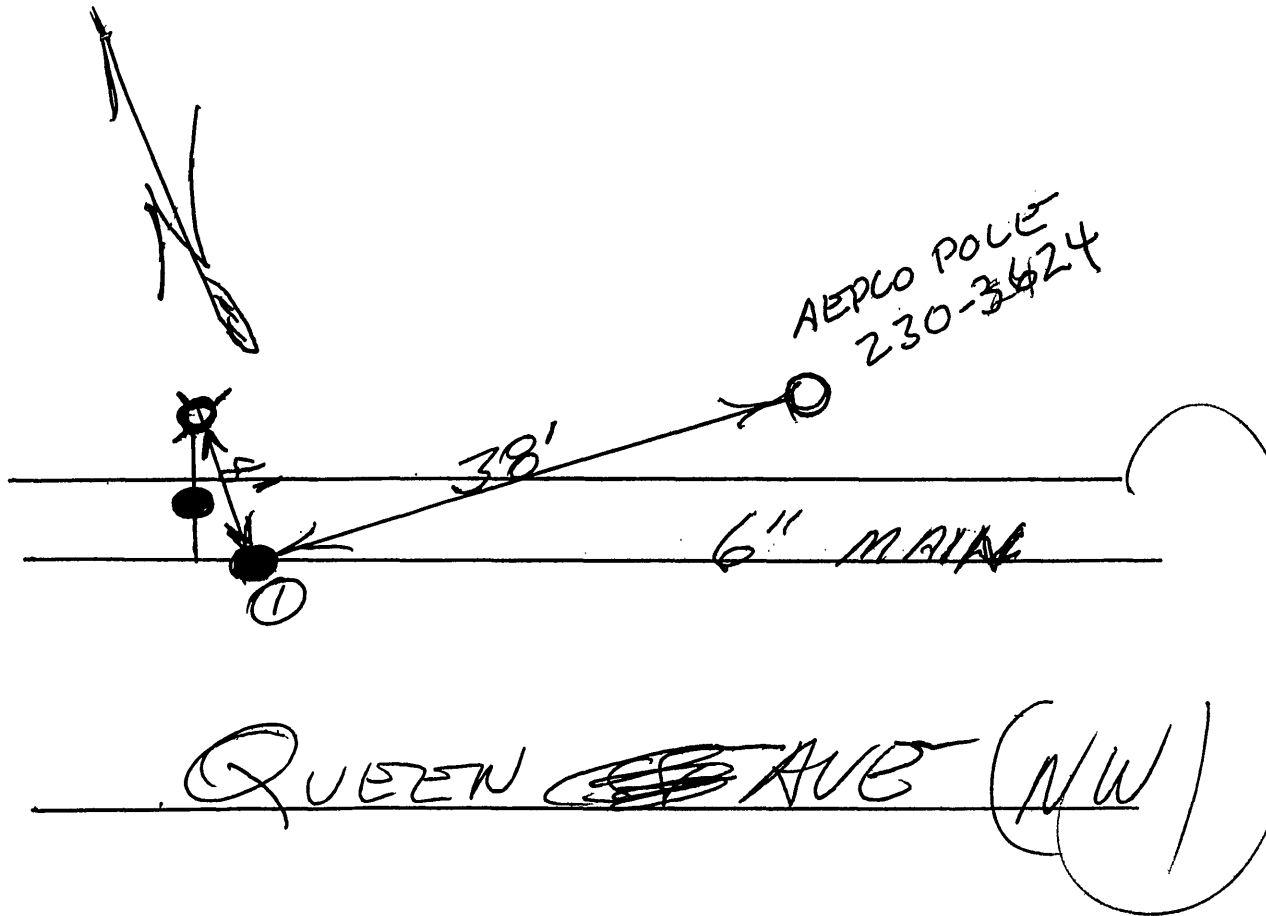

DATE	NO.	SIZE	MAKE	OPEN	TURNS
4-95	1	6	-	R	21

P. L. Measurements		
No.	Distance	Direction

CITY OF ROANOKE - WATER DEPT.	
VALVE DIAGRAM	
QUEEN AVE - NW	
700 - BLOCK	
Sec. Map	
Date	Page No.