



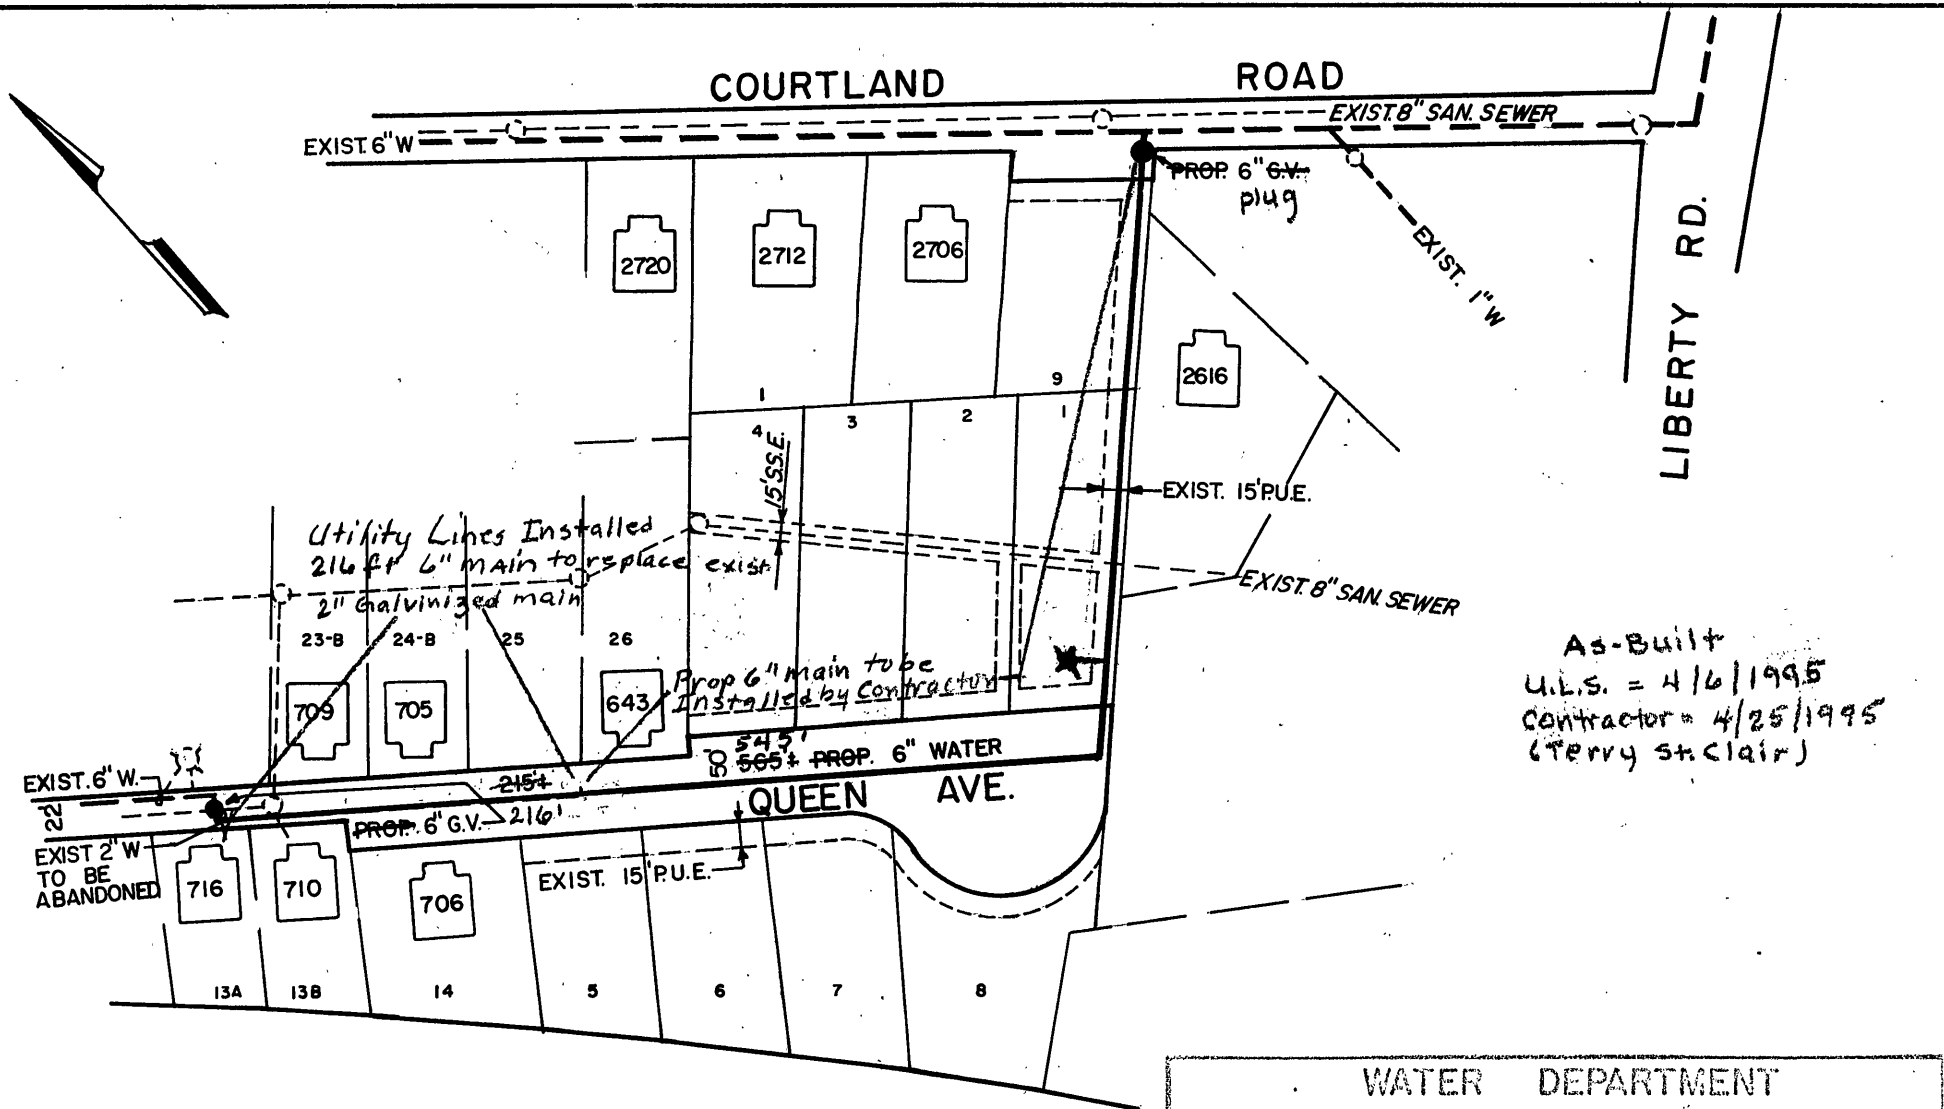

As-Built
 U.L.S. = 4/6/1995
 Contractor = 4/25/1995
 (Terry St. Clair)

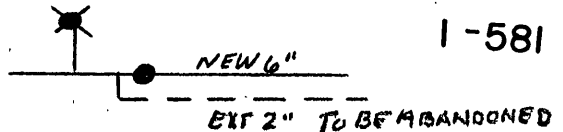

NOTE: - ALL EXIST. UTILITIES SHALL BE ASCERTAINED IN THE FIELD PRIOR TO CONSTRUCTION.

- REPLACE 215'± EXIST. 2" WATER WITH NEW 6" MAIN.
- 600'± 700'± BIKS - services to be tapped over to 6" main - 2" main to be abandoned

[Signature]
 MANAGER UTILITY LINE SERVICES

WATER DEPARTMENT	
ROANOKE	VIRGINIA
QUEEN AVENUE, N.W.	
SCALE: 1" = 100'	DIRECTOR UTILITIES & OPERATIONS DATE
DATE: 2/13/95	
DIST. MAP: 206	
PLAN NO.: 95-1	DIRECTOR OF PUBLIC WORKS DATE