

DATE: NOV. 9, 2003
 REVISIONS
 DEC. 10, 2003
 DEC. 31, 2003

HUGHES ASSOCIATES ARCHITECTS
 Architecture • Planning • Consulting


656 ELM AVENUE, S.W.
 P.O. BOX 1034
 ROANOKE, VIRGINIA 24005-1034

TEL (540) 342-4002
 FAX (540) 342-2080

**NEW FACILITY FOR
 FELLOWSHIP
 COMMUNITY CHURCH**
 ROANOKE COUNTY, VIRGINIA
 RED LANE EXTENSION

**OFF-SITE
 WATERLINE
 PLAN &
 PROFILE**


COMMONWEALTH OF VIRGINIA
 RICHARD B. THRASHER
 No. 007490
 3/5/04
 ARCHITECT
 COMMISSION No.
 02005
 SHEET
SP-9
 No. 12 of 146
 COPYRIGHT 2003
 HUGHES ASSOCIATES ARCHITECTS
 A PROFESSIONAL CORPORATION

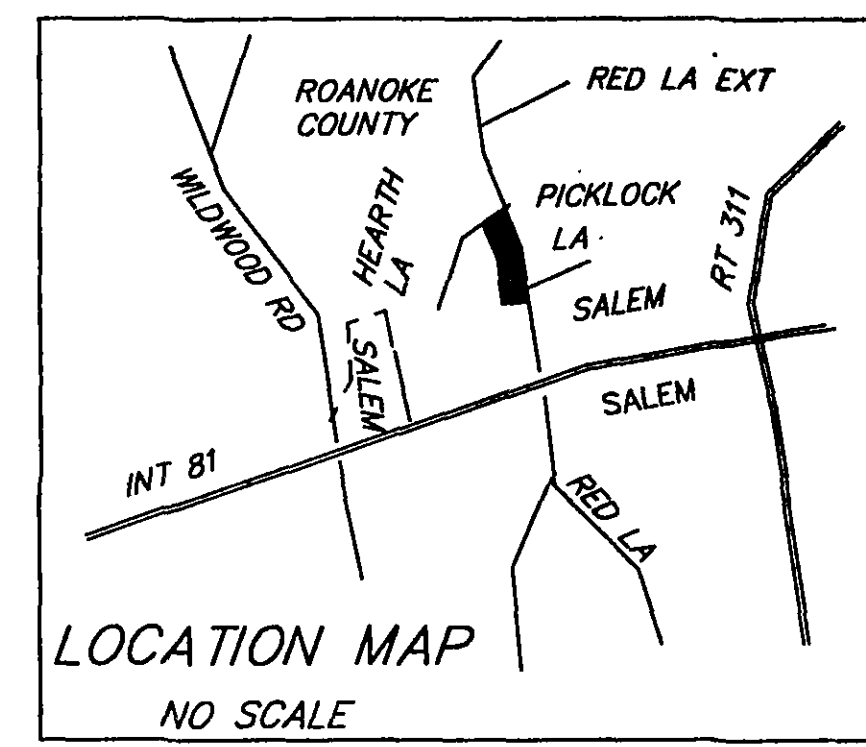

PROPERTY LINE DATA

LINE	BEARING	DISTANCE
1-2	S86°13'40"W	193.03'
2-3	N03°20'55"E	85.67'
3-4	N13°00'16"W	463.23'
4-5	N32°01'00"W	218.75'
5-6	N79°30'13"E	163.53'
6-7	S33°42'33"E	72.90'
7-8	S31°15'50"E	244.93'
8-9	CURVE C-1	
9-10	S03°46'20"E	148.58'
10-11	CURVE C-2	
10-11	S03°46'20"E	174.28'

CURVE C-1: L=311.88'
 CURVE C-2: R=25', L=39.27'

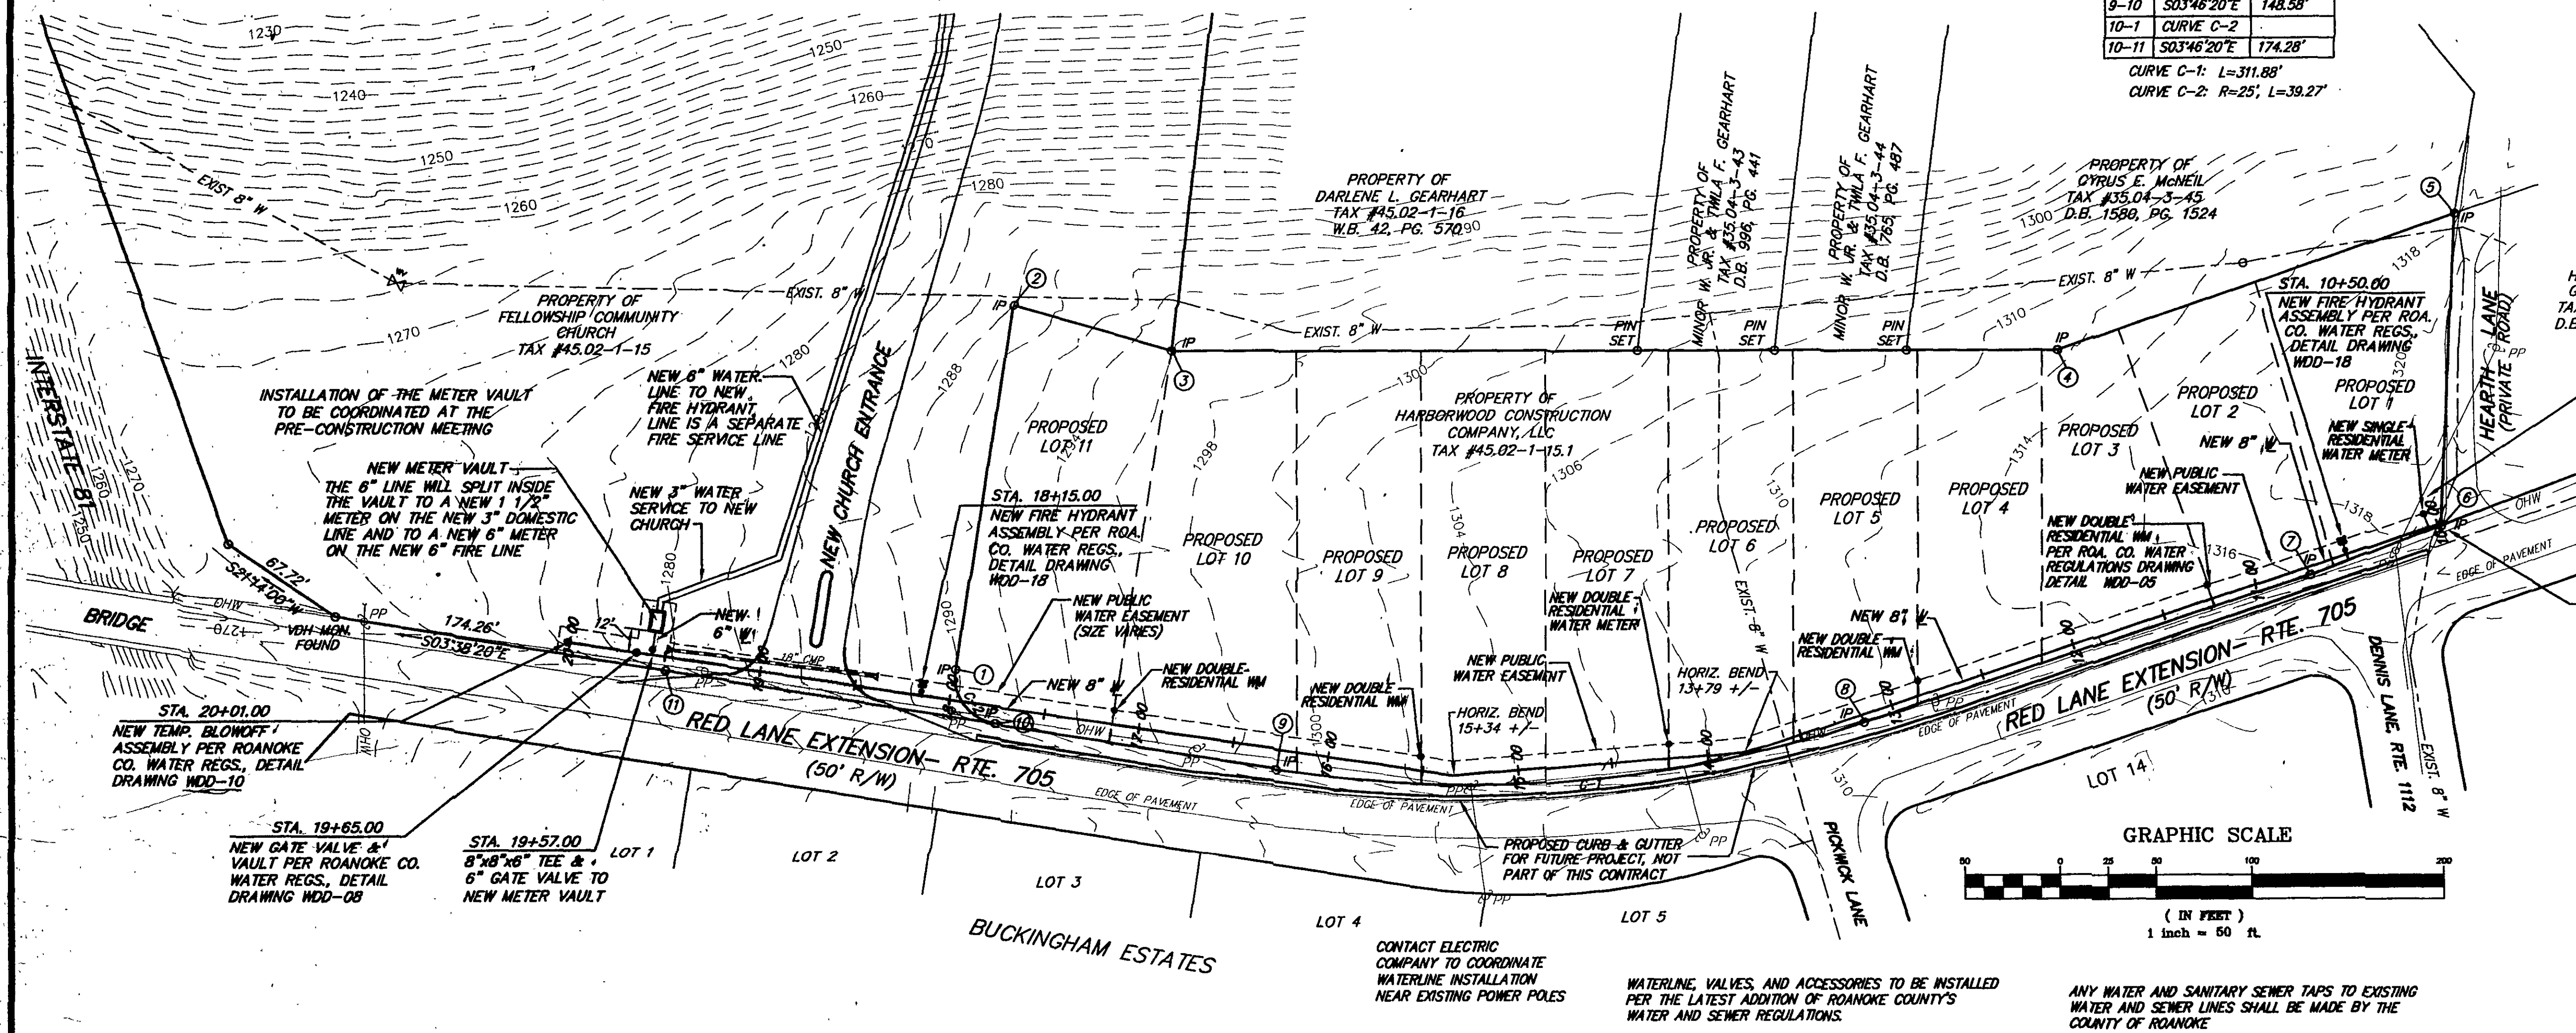

PROPERTY OF HANGING ROCK GOLF CLUB, INC.
 TAX #35.04-3-46
 D.B. 1418, PG. 829


THE NEW METER TO DOUBLE AS A CONSTRUCTION AIR RELEASE DURING THE INITIAL FILLING OF THE NEW LINE

STA. 10+00.00 TAP EXIST. 8" WATERLINE
 NEW 8"X8" TAPPING SLEEVE & VALVE
 ROANOKE COUNTY UTILITY DEPARTMENT TO MAKE THE TAP AND INSTALL THE VALVE. CONTRACTOR TO INSTALL THE NEW 8" LINE
 Catherine Foster H.T.H.
 #12 wire
 45"

RESIDENTIAL WATER METER LOCATIONS

8" NEW WATERMAIN STATION	LOTS SERVED
STA. 10+05.00 (SINGLE METER)	LOT 1
STA. 11+23.50 (DOUBLE METER)	LOT 2 & LOT 3
STA. 12+85.50 (DOUBLE METER)	LOT 4 & LOT 5
STA. 14+20.00 (DOUBLE METER)	LOT 6 & LOT 7
STA. 15+51.00 (DOUBLE METER)	LOT 8 & LOT 9
STA. 17+14.00 (DOUBLE METER)	LOT 10 & LOT 11

PROPOSED LOT LAYOUT PROVIDED BY
 T.P. PARKER AND SON

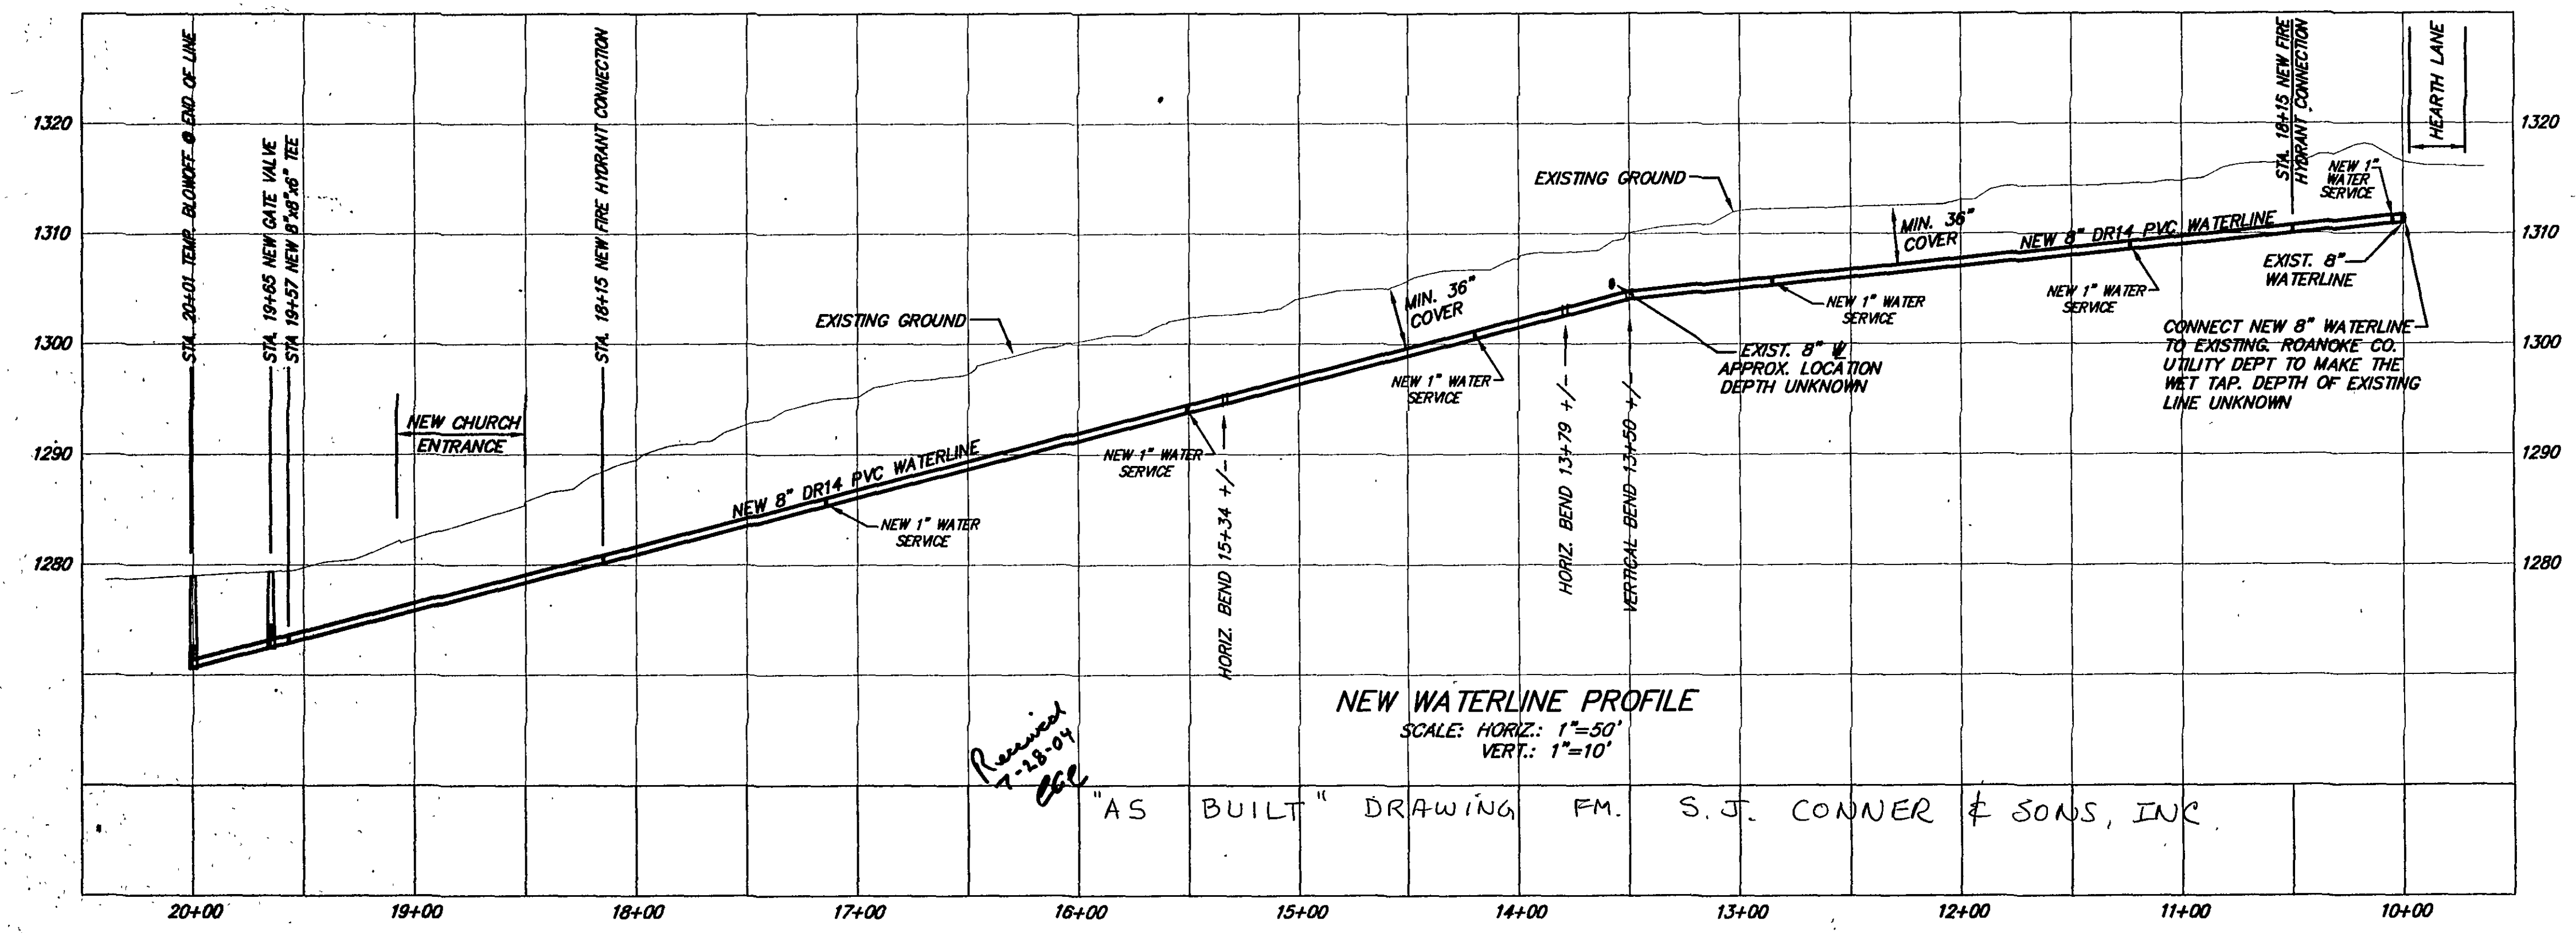

CURTIS CARROLL
 309-3472

Terry Love
 cmc 982-1095

Sheldon Henderson
 387-5059
 CP 537-6166

Sgt Mr. Robert Quisenberry

John
 798 8856

"AS BUILT" DRAWING FM. S.J. CONNER & SONS, INC.