



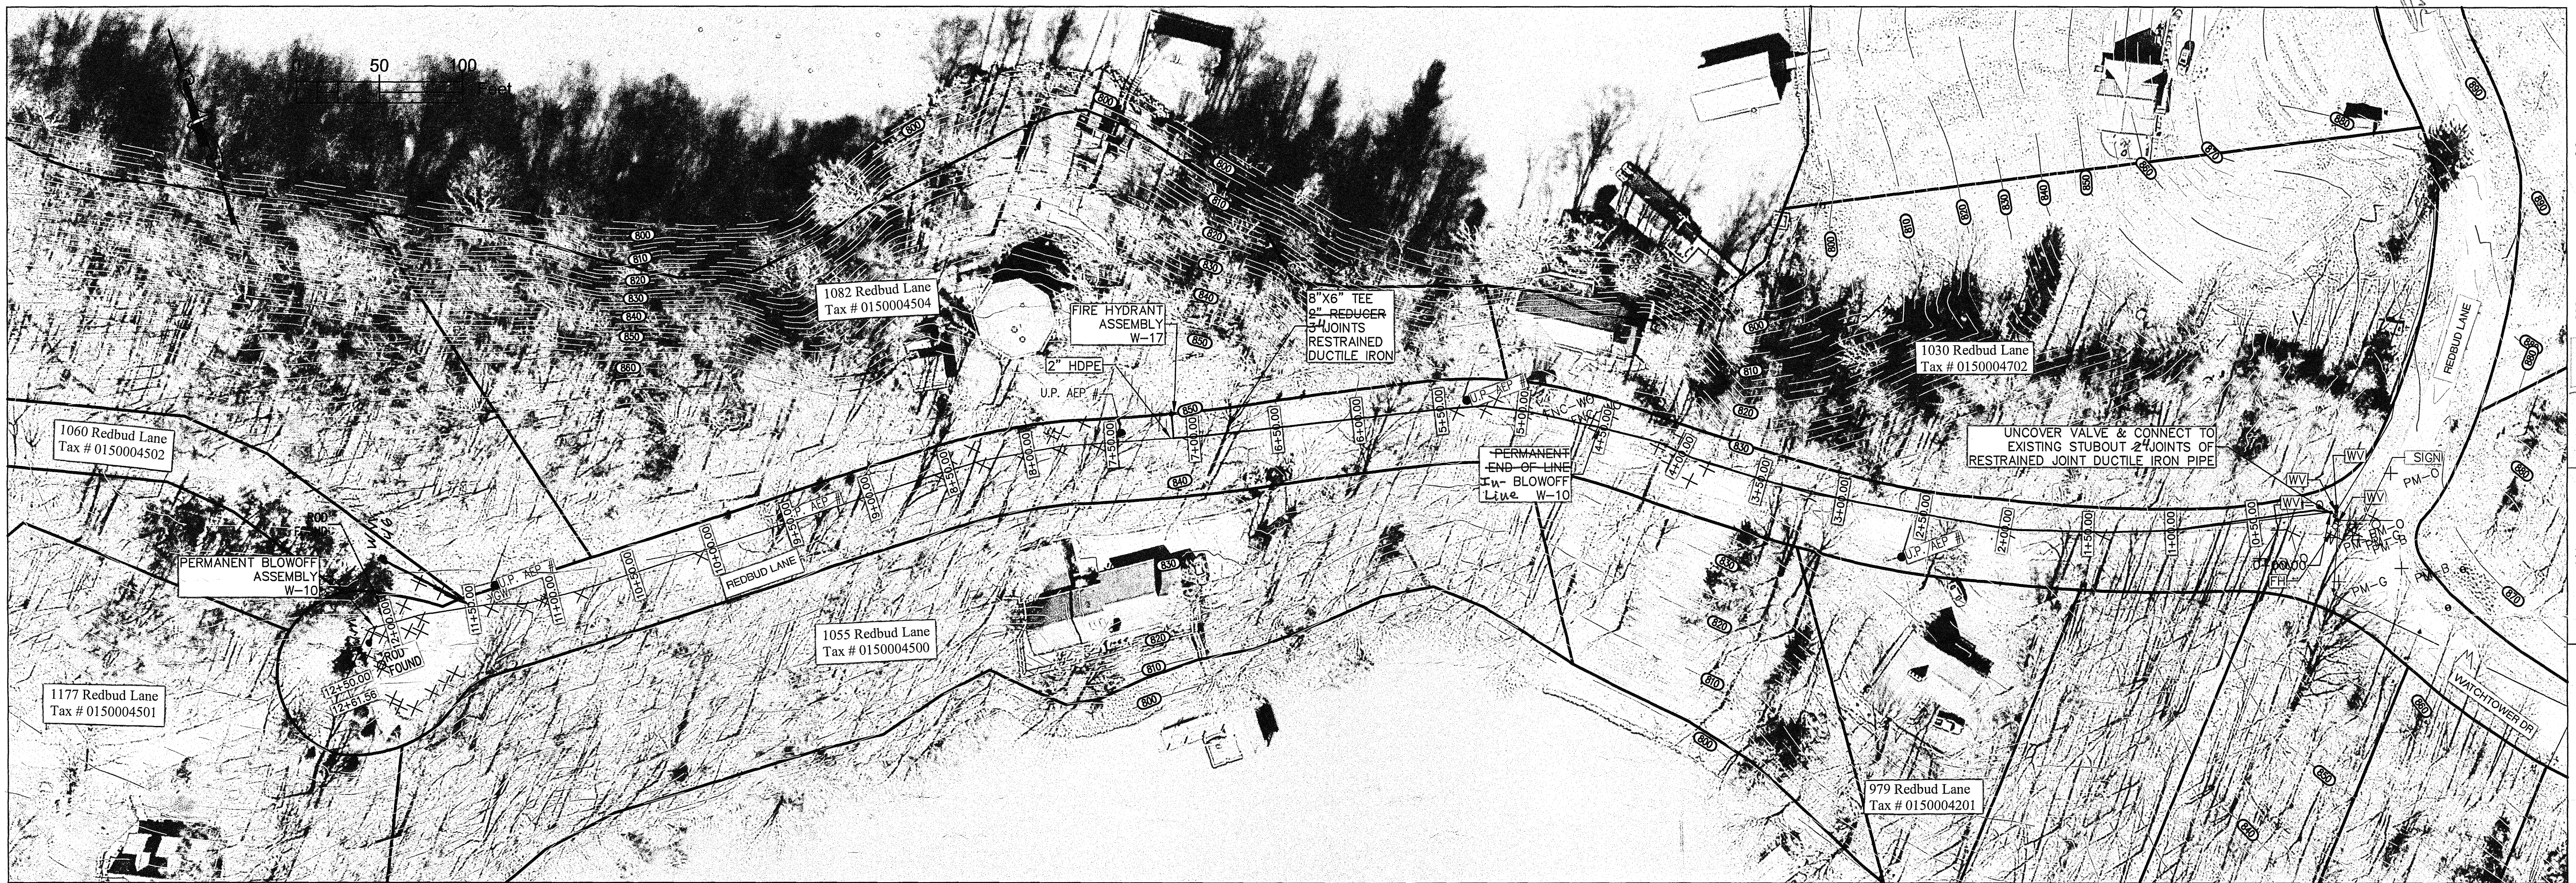

Except as noted, the majority of the line is 8" C900 PVC.

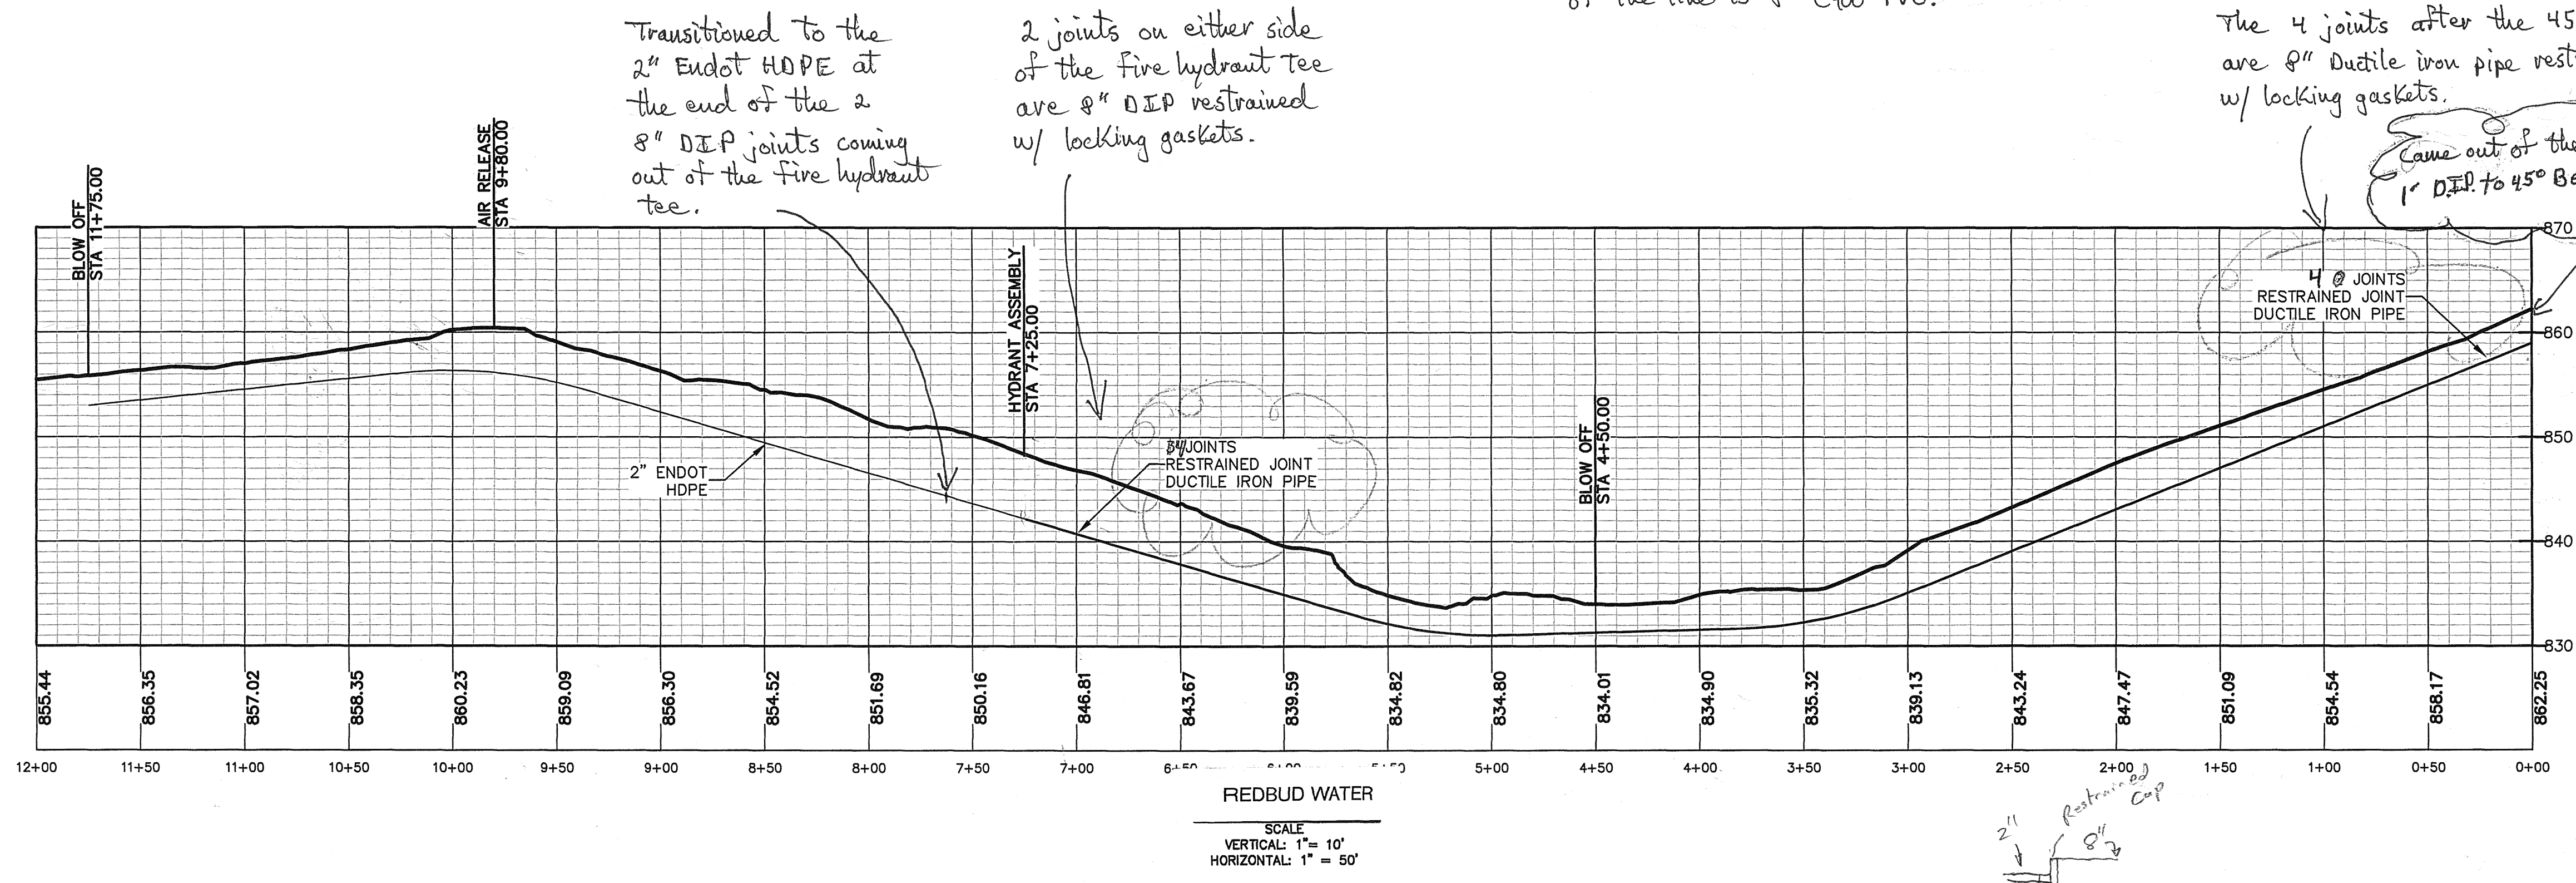

WESTERN VIRGINIA

WATER AUTHORITY

ENGINEERING SERVICES
601 S JEFFERSON ST, SUITE 300
ROANOKE, VA 24011
540-853-5641 or 540-853-5770

REDBUD WATER

PLAN & PROFILE

Rev	Description	Date	By

Designed: DMV

Drawn: AAS

Checked: DMV

Approved: _____

Date: 10-4-13

Project: _____

Sheet 1 of 1

As-Built 12.10.13 Wells Construction/
K. Winslow