
#### **GENERAL NOTES:**

- Standard Residential "Entrance" shall have a minimum curb radius(R) of 2.5 feet.
- Maximum entrance width to be 14 feet.
- Where curb & gutter already exists both curb & gutter shall be removed. If proposed entrance falls within five(5) feet of an existing joint removal & reconstruction shall be to that joint. Any concrete removed at other than an existing joint shall be cut with a mechanical saw specifically manufactured for that purpose.
- Where sidewalk exists or is to be constructed across driveways the thickness thereof must correspond with the thickness of the entrance.
- Whenever "Entrances" exceeds twenty—four(24) feet in width a 1/2" premolded expansion joint filler shall be installed through the center perpendicular to flow line.
- Finish "Entrances" shall have a "course broom finish" running parallel to flow line. Curing shall be accomplished by the use of a liquid membrane seal containing white pigment applied at the rate of one(1) gallon per 150 square feet.
- All "Entrances" shall be constructed according to City of Roanoke specifications and to the lines and grades established by the construction plans and actual field elevations.

### STD. CITY OF ROANOKE ENTRANCE

NO SCALE

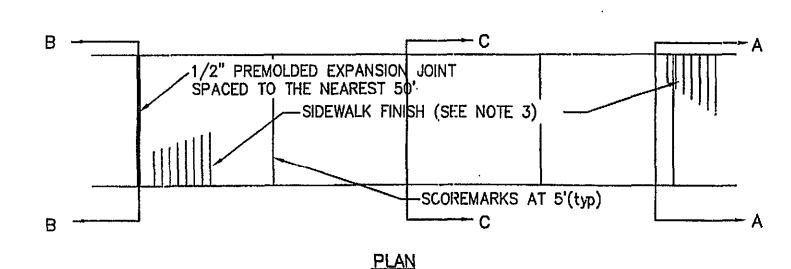

### STANDARD CONCRETE PEDESTRIAN SIDEWALK NOTES

- ALL CONCRETE SHALL BE CLASS A, 3000 PSI
- SPACING FOR EXPANSION JOINTS SHALL BE AT MAXIMUM 50' INTERVALS
- 3. SIDEWALK FINISH: SIDEWALK SHALL BE FIRST SMOOTH TROWELED. THEN ENDING WITH A LIGHT BROOM FINISH, UNLESS OTHERWISE NOTED.
- 4. WHEN SIDEWALK ABUTS A CURBING OR A PREVIOUS CONCRETE POUR, A 1/2" PREMOLDED EXPANSION JOINT IS TO BE USED. 5. CURING SHALL BE ACCOMPLISHED BY THE USE OF A LIQUID MEMBRANE
- SEAL CONTAINING WHITE PIGMENT, APPLIED AT THE RATE OF ONE (1) GALLON PER 150 SQUARE FEET.


PUBLIC SIDEWALK

### GENERAL CITY OF ROANOKE ENGINEER NOTES: WORK SHALL NOT COMMENCE IN PUBLIC RIGHT-OF-WAY BEFORE APPROVAL BY AN INSPECTOR AND A PERMIT

NOTIFY CONSTRUCTION INSPECTORS OFFICE AT 853-2856 - 48 HOURS BEFORE WORK BEGINS.

DO NOT POUR ANY CONCRETE BEFORE FORMS HAVE BEEN INSPECTED AND APPROVED. USE ONLY STANDARD METAL FORMS AS APPROVED BY VDOT (WOOD FORMS WILL NOT BE PERMITTED).


JOINTS OR SCORE MARKS ARE TO BE SHARP AND CLEAN WITHOUT SHOWING EDGES OF JOINTING TOOL ALL RADIUS SHOWN SHALL BE 1/2" UNLESS OTHERWISE NOTED FOR PREMOLDED EXPANSION JOINTS.

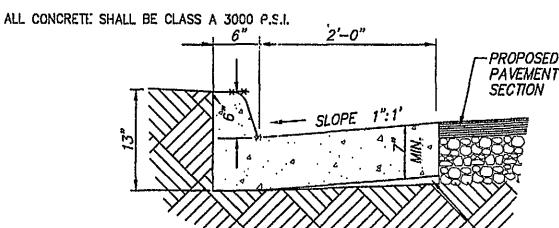


BOTTOM OF THE CURB & GUTTER -MAY BE CONSTRUCTED PARALLEL TO THE SLOPE OF THE SUBBASE


# STD. CITY OF ROANOKE **CURB & GUTTER**


NO SCALE

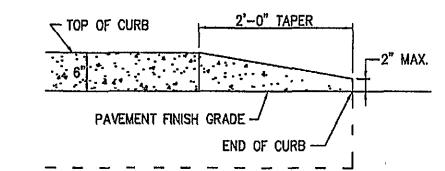

# CURB TAPER DETAIL

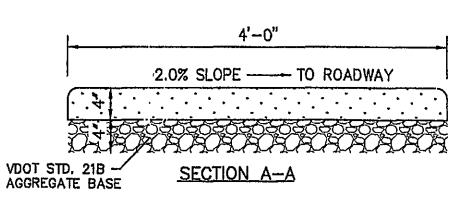

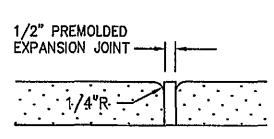

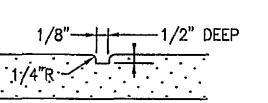

SECTION B-B

SECTION C-C

### SEWER

Water and Sewer "AS-Built" information

#### LOCATION OF 8" X 4" TEE-Y'S AND CLEANOUTS

LOT	LENGTH FROM	MANHOLE	DISTANCE OFF	DEPTH OF
<u> </u>	MANHOLE		SEWER	CLEANOUT
<u>L</u>				
5	0+72.8	В	0	5.6
6	1+50	В	17.6	7.7
7	2+25.7	_B	16.7	8
8	1+41	С	45.6	5.1
9	1+97.5	C	53	4.7
10	OUT OF MANHOLE	D	8.3	5.1
11	2+05	C	26.5	4.5
12	1+89.4	C	51.7	3.1
13	0+97	С	27.2	4.7
14	0+51	С	29.9	5
15	<b>OUT OF MANHOLE</b>	C	36.2	4.7
16	0+60	С	22.8	6.1
17	<b>OUT OF MANHOLE</b>	E	24	5.2
18	2+49.1	В	32.5	6.3
19	1+75.5	В	32.7	8.5
20	1+15	В	31.5	7.1
21	0 +56	В	29.2	6.1
22	<b>OUT OF MANHOLE</b>	В	19	7.3

Lot 1 existing Water and Sewer service, Lots 2, 3, 4 Water Service and Sewer Laterals installed by Southwest Virginia Water Authority.

# MANHOLE DEPTHS

A	6.5
В	7
C	8.2
D	5.7 '
E	5,2

### SEWER MANHOLE DATA

LINE	DISTANCE
Existing to "A"	49.5
"A" to "B"	83.5
"B" to "C"	288.6
"C" to "D"	221.5
"D" to "E"	96.2
"E" to Stub	66.3

Double Water Meters are located on the following lot corners and serving the same lots: Lot 6-7, 9-10, 11-12, 14-15, 18-19, and 20-21. Single Water Meters are on the following lots: Lot 5, 8, 13, 16, 17, and 22

### WATERLINE

#### Waterline tap at the corner of Snead and Gearhart.

ITEM	FROM HOUSE 1103 GEARHART CORNER "A"	FROM HOUSE110 GEARHART CORNI "B"
Taping valve	70.7	83.9
45 Bend Down	67.5	79.6
45 Bend Level	65.5	77
22 Bend	51	52.5

#### Corner of Gearhart and Reed Rd.

		***	
ITEM	FROM HOUSE 1122 GEARHART CORNER	FROM HOUSE 1122	FROM HOUSE 112
1 LTIVI	"A"	GEARHART CORNER "B"	GEARHART CORNE
90 Bend	108,5	142.5	N/A
90 Bend	89.1	128	N/A
8" Tee	75,3	113.5	N/A
Vault Valve	73.7	112.3	N/A
Hydrant Valve	72.1	109.8	N/A
Sleeve	73	112.3	N/A
45 Bend Up	72.8	112.1	N/A
45 Bend Level	72.3	111.7	N/A
8" x 6" Reducer	41.3	74	N/A
Fire Hydrant	40.5	72.7	N/A
Sleeve	69.3	N/A	75
' Vault Valve	69.3	N/A	73.5

### Corner of Reed Rd. and Updike Rd., and end of Updike Rd. to the West

ITEM	FROM HOUSE 3147 REED RD. CORNER	FROM HOUSE 3147 REED RD, CORNER	FROM HOUSE 3147 REED RD. CORNER "C"	
	"A"	"B"		
I to office of N & Too				
Hydrant Valve	60,9	43.1	N/A	
8" Tee to Hydrant	54.7	33.3	N/A	
6" Valve	67.1	41.5	N/A	
8" x 6" Reducer	64.3	37.9	N/A	
8" Tee	63.1	35.1	N/A	
8" Valve	59.8	26.9	N/A	
8" x 6" Reducer to Fire Hydrant	86.2	77.2	N/A	
Fire Hydrant	87.7	78.2	N/A	
Air Release	N/A	59.4	_ 42.8	
Temp Blow -off Valve	N/A	64.1	46.5	
Blow -off	N/A	109.1	90	

#### East end of Updike Rd.

ITEM	FROM HOUSE 1122 UPDIKE RD. CORNER "A"	FROM HOUSE 1122 UPDIKE RD. CORNER "B"	
Perm.Blow Off	66.7	88	
Air Release	74.3	91.5	

# W.V.W.A. SERVICE LATERAL INFORMATION

LOT	DOWNSTREAM MANHOLE	DIST.	TOP OF S.S. MAIN	MIN. F.F. ELEVATION	APPROX. F.F. ELEVATION	APPROX. WATER PRESSURE
1 .	'Α'	218.0	1042.6	1045.6	1058.5-Ex	34
	'A'	218.0	1042,6	1045.6	1054.0	36
3	'A'	94.0	1036.3	1039.3	1048.0	38
23456789	'A' 'A'	94.0	1036.3	1039.3	1044.0	40
5	<b>'</b> B'	77.4	1040.1	1043.1	1052.5	72
6	<b>'</b> B'	145.2	1045.8	1048.8	1057.5	70
7	<b>'</b> B'	227.2	1052.7	1055.7	1062.5	68
8	,C,	139.9	1062.4	1065.4	1068.0	66
	'C'	198.3	1064.4	1067.4	1070.0	65
10	,D,	-0-	1065.3	1068.3	1072.0	64
11	'D'	-0-	1065.3	1068.3	1074.0	63
12	,c,	189.4	1063.6	1066.6	1075.0	63
13	, <b>'C'</b>	102.5	1061.2	1064.2	1074.0	63
14	'C'	47.6	1059.3	1062.3	1073.0	64
15	,'C,'	-0-	1058.6	1060.6	1072.0	64
16	,c,	73.3	1060.4	1063.4	1071.0	64
17	<u>'</u> E'	-0-	1061.5	1064.5	1069.0	65
18	<b>'</b> B'	240.2	1053.8	1056.8	1064.0	68
19	'B'	164.2	1048.4	1050.4	1059.0	70
20	',B',	108.2	1042.7	1045.7	1054.0	72
21	<b>'</b> B'	58.2	1038.4	1041.4	1049.0	74
22	<b>'</b> B'	-0-	1033.5	1036.5	1044.0	76

# SANITARY SEWER MANHOLE DATA

		1 Carl Carl
LINE	BEARING	DISTANCE
Existing to 'A'	S. 75°09' E.	50.2'
'A' to 'B'	N. 14'39' E,	75.0'
'B' to 'C'	N. 24'32' E.	298.7'
'C' to 'D'	S. 6818' E.	222.7'
'C' to 'E'	N. 53'12' W.	101.8
'E' to 'STUB'	N. 13 <b>'4</b> 5' W.	54.0'

STATIONS AND OFFSETS ARE MEASURED ALONG A BASELINE FROM CENTER OF MANHOLE TO CENTER OF MANHOLE WITH 0+00.0 BEING THE BEGINNING AT THE LOWER MANHOLE.

THE MIN. FLOOR ELEVATION IS BASED ON SEC. 200.02-2-G-1-h OF THE WESTERN VIRGINIA WATER AUTHORITY WATER & SEWER REGULATIONS. LOT OWNERS REQUESTING A LOWER SERVICE ELEVATION WILL REQUIRE THE USE OF A PRIVATE SEWAGE PUMP FACILITY, INSTALLED AND MAINTAINED BY THE

# GENERAL NOTES

- PRIOR TO BEGINNING ANY CONSTRUCTION WITHIN THE PUBLIC RIGHT-OF-WAY FOR GEARHART ROAD, A TRAFFIC CONTROL PLAN SEQUENCED WITH A PLAN OF OPERATION FOR MAINTENANCE OF TRAFFIC MUST BE PREPARED IN ACCORDANCE WITH "MUTCD" (MANUAL ON UNIFORM TRAFFIC CONTROL DEVICES) AND THE "VIRGINIA WORK AREA PROTECTION MANUAL". THE PLAN SHALL BE SUBMITTED TO THE CITY OF ROANOKE PUBLIC WORKS DEPARTMENT FOR REVIEW AND APPROVAL. SPECIAL ATTENTION TO MAINTAIN ACCESS TO THE ADJOINING PROPERTIES MUST BE PROVIDED. ALL FLAGGERS SHALL BE CERTIFIED AND MUST SPEAK ENGLISH WHILE PERFORMING THEIR DUTIES ON THE PROJECT. UPON ACQUIRING APPROVAL OF THE PLANS, THE G.C. SHALL BE RESPONSIBLE FOR ACQUISTION OF ALL PERMITS.
- G-2 UPON COMPLETION OF THE INSTALLATION OF THE CURB & GUTTER AND STONE BASE, THE G.C. SHALL INSTALL TEMPORARY 'STOP SIGNS' AT THE INTERSECTION AS INDICATED, THE SIGNS SHALL BE INSTALLED IN ACCORDANCE WITH PART 2 OF THE MANUAL OF UNIFORM TRAFFIC CONTROL DEVICES, LATEST EDITION.
- G-3 VDOT STD. CG-12 HANDICAP RAMP

CRUSHER RUN AGGREGATE #25, OR #26.

- G-4 STD. CITY OF ROANOKE RESIDENTIAL ENTRANCE, WIDTH=12' TO BE CONSTRUCTED TO PROVIDE VEHICULAR ACCESS TO THE PRIVATE SWM FACILITY
- G-5 GRASS LANDSCAPE ISLAND TO BE CONSTRUCTED CONCENTRIC WITH RIGHT-OF-WAY USING VDOT STD. CG-2 CURBING. RADIUS SHALL BE 10' TO FACE OF CURB.
- G-6 NEW 18'x20' PARKING AREA TO BE ESTABLISHED USING A MINIMUM OF 4" VDOT STD.
- G-7 UPON COMPLETION OF THE INSTALLATION OF THE CURB & GUTTER, THE G.C. SHALL INSTALL PERMANENT 'NO PARKING' AS INDICATED, (3 REQD). THE SIGNS SHALL BE INSTALLED IN ACCORDANCE WITH PART 2 OF THE MANUAL OF UNIFORM TRAFFIC CONTROL DEVICES, LATEST EDITION.
- G-8 THE PROPOSED SIDEWALK SHALL BE WIDENED TO 5' FOR A MINIMUM DISTANCE OF 5' TO PROVIDE A PASSING SPACE IN ACCORDANCE WITH ADA STANDARDS. MAXIMUM LENGTH FOR THE 4' WIDE SECTION SHALL BE 200'.

# SANITARY SEWER SCHEDULE

SS 'A'	NEW STRADDLE MANHOLE TO BE INSTALLED OVER THE EXISTING MAIN IN ACCORDANCE WITH WVWA STD. S-02. APPROX. STA. 9+91.5, 5.5'Lt.	SS 'E'	SANITARY SEWER MANHOLE STA. 10+94.96, 5.5' Lt. ANGLE = 220'
	ANGLES = 90° & 180°	SS 'F'	PLUG 8" MAIN WITH STD. END CAP
SS 'B'	SANITARY SEWER MANHOLE STA. 10+66.5, 5.5' Lt.		STA. 11+48.0, STA. 5.0' Rt.
	ANGLES = 90° & 190°	SS 'G'	EXISTING S.S. LATERAL TO BE ABANDONED IN-PLACE
ss 'c'	SANITARY SEWER MANHOLE STA. 13+65.15, 5.5' Rt. ANGLES = 102' & 267'		(WITH PLUGS) WHERE IT CROSSES NEW LOT LINE. GC SHALL VERIFY DEPTH TO COORDINATE THE
SS 'D'	SANITARY SEWER MANHOLE STA. 7+72.04, 5.5' Rt. ANGLE = 145'		INSTALLATION OF THE NEW COMBINED 6" BY TWO 4" LATERAL AS INDICATED.

NOTE: THE GENERAL CONTRACTOR SHALL FURNISH ALL LABOR, MATERIALS, TOOLS AND EQUIPMENT NECESSARY TO INSTALL, BACKFILL AND TEST ALL SANITARY SEWER COLLECTOR LINES AND ASSOCIATED STRUCTURES IN ACCORDANCE WITH THE WESTERN VIRGINIA WATER AUTHORITY WATER AND SIWER DESIGN & CONSTRUCTION STANDARDS LATEST EDITION.

# STORM DRAIN SCHEDULE


SD	#1	VDOT STD. DI-3C THROAT = 10' STA. 10+05.4, 14.5'Rt.	SD #8	VDOT STD. DI-5 TYPE E III. GRATE STA. 10+30, 51.4'Lt.
SD	#2	VDOT STD. DI-3B THROAT = 12'	SD #9	VDOT STD. MH-2 STA. 10+75.5, 116'Lt.
SD	#3	STA. 11+10.45, 14.46'Lt, w/VDOT IS-1 SHAPING VDOT STD. D.I3B THROAT = 6'	SD #10	VDOT STD. ES-1 & VDOT STD. EC-1 CLASS 1 RIPRAP, DETAIL 1 STA. 10+95.8, 125.5'Lt.
SD	#4	STA. 10+30.0, 14.5'Lt.  VDOT STD. D.I3B  THROAT = 10'  STA. 10+04.5, 42.0'Rt.	SD #11	12' LONG x 4"THK CONC. TRANSITION 24' LENGTH OF VDOT STD. PG-2A, TYPE E DITCH. ALL JOINTS TO BE DOWLED.
SD	<b>#</b> 5	VDOT STD. D.I3B THROAT = 14' STA. 11+10.60, 14.55'Rt.	SWM	STORMWATER MANAGEMENT CONTROL STRUCTURE AND OUTLET PIPE, SEE DETAIL ON SHEET C-8 FOR CONSTRUCTION REQUIREMENTS.
SD	#6	VDOT STD. D.I7 TYPE A III GRATE STA. 11+11.45, 83.0'Rt.	SWQ	PREMANUFACTURED BMP, HYDROGUAF STORM WATER SEPARATOR, MODEL HG-6 OR APPROVED EQUAL. THE PRE-MANUFACTURED UNIT SHALL
SD	# <b>7</b>	VDOT STD. D.I3B THROAT = 6' STA. 10+32.0, 14.5'Rt.		NOT BE INSTALLED INTO THE MANHOR BASE UNTIL STABILIZING OF ALL THE DENUDED AREAS WITHIN THE LIMITS OF THE DRAINAGE AREA DISCHARGING THROUGH THE FACILITY HAS BEEN ACHIEVED.

THE GENERAL CONTRACTOR SHALL FURNISH ALL LABOR, MATERIALS, TOOLS AND EQUIPMENT NECESSARY TO INSTALL, BACKFILL AND TEST ALL STORM DRAIN AND ASSOCIATED STRUCTURES IN ACCORDANCE WITH THE VIRGINIA DEPARTMENT OF TRANSPORTATION ROAD AND BRIDGE STANDARDS AND SPECIFICATIONS, LATEST EDITION.

# WATERLINE SCHEDULE

- approx. location of exist. 8" high pressure watermain Static =  $\pm 130$  psi. G.C. SHALL FIFLD VERIFY LOCATION AND DEPTH, AND COORDINATE CONNECTION REQUIREMENTS WITH THE W.V.W.A., CONTRACTOR TO FURNISH AND INSTALL TAPPING SLEEVE AND VALVE, TAP TO BE MADE BY WWWA. CONTRACTOR SHALL BE RESPONSIBLE FOR EXCAVATION AND SHORING PER OSHA REGULATIONS. G.C. SHALL INSTALL AND EXTEND THE 8" WATERMAIN AS INDICATED.
- W-2 STA. 10+11.3, 21.3' Rt., FIRE HYDRANT ASSEMBLY REQUIRED
- W-3 STA. 10+10.0, 26.5' Lt., 8" MAINLINE PRESSURE REDUCING VAULT. OUTLET PRESSURE TO BE SET TO 80 PSI.
- W-4 STA. 13+32.0, 16.5' Rt., FIRE HYDRANT ASSEMBLY REQUIRED
- W-5 STA. 13+44.65, 26.5'Lt., 8"x8" TEE, ONE(1) 8"x6" REDUCER, ONE(1) 8" GATE VALVE, AND ONE(1) 6" GATE VALVE. REFER TO PLAN VIEW TO INSURE THAT GATE VALVE TOPS ARE LOCATED AWAY FROM THE EDGES OF THE PROPOSED SIDEWALK OR CURBING.
- W-6 STA. 7+73.0, 10.5'Lt., AIR RELEASE VALVE AND A PERMANENT END OF LINE ASSEMBLY
- W-7 STA. 11+18.0, 26.0'Lt., AIR RELEASE VALVE AND ONE(1) 8" GATE VALVE
- W-8 STA. 11+54.6, 26.0'Lt., PROVIDE ±54' OF 8" WATERMAIN AND BLOW-OFF ASSEMBLY FOR MAIN LINE TEMPORARY TERMINATION

NOTE: THE GENERAL CONTRACTOR SHALL FURNISH ALL LABOR, MATERIALS, TOOLS AND EQUIPMENT NECESSARY TO INSTALL, BACKFILL AND TEST ALL WATERLINE AND ASSOCIATED APPURTENANCES IN ACCORDANCE WITH THE WESTERN VIRGINIA WATER AUTHORITY WATER AND SEWER DESIGN & CONSTRUCTION STANDARDS. LATEST EDITION.

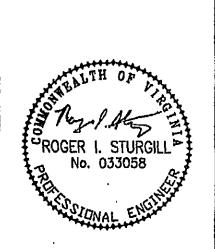



www.balzer.cc PLANNERS • ARCHITECTS ENGINEERS • SURVEYORS 1208 Corporate Circle

501 Branchway Road Richmond, Virginia 23236 Phone: 804/794-0571 FAX: 804/794-2635

FAX: 540/772-8050

Roanoke, Virginia 24018 Phone: 540/772-9580

880 Technology Park Drive Suite 200 Glen Allen, Virginia 23059 Phone: 804/653-0132 FAX: 804/653-0133

448 Peppers Ferry Road, NW Christiansburg, Virginia 24073 Phone: 540/381-4290

1561 Commerce Road Verona, Virginia 24482 Phone: 540/248-3220 FAX: 540/248-3221

AND

DRAWN BY: JVJ DESIGNED BY: JVJ

CHECKED BY: SMH DATE: 11/14/2007

REVISIONS:

1st - 01/18/2008 per City Review 2nd - 02/19/2008 per City Review 3rd - 04/22/2008 per Owner for Sections

4th - 06/03/2008

per City Review

SHEET NO.

R0700194.00