


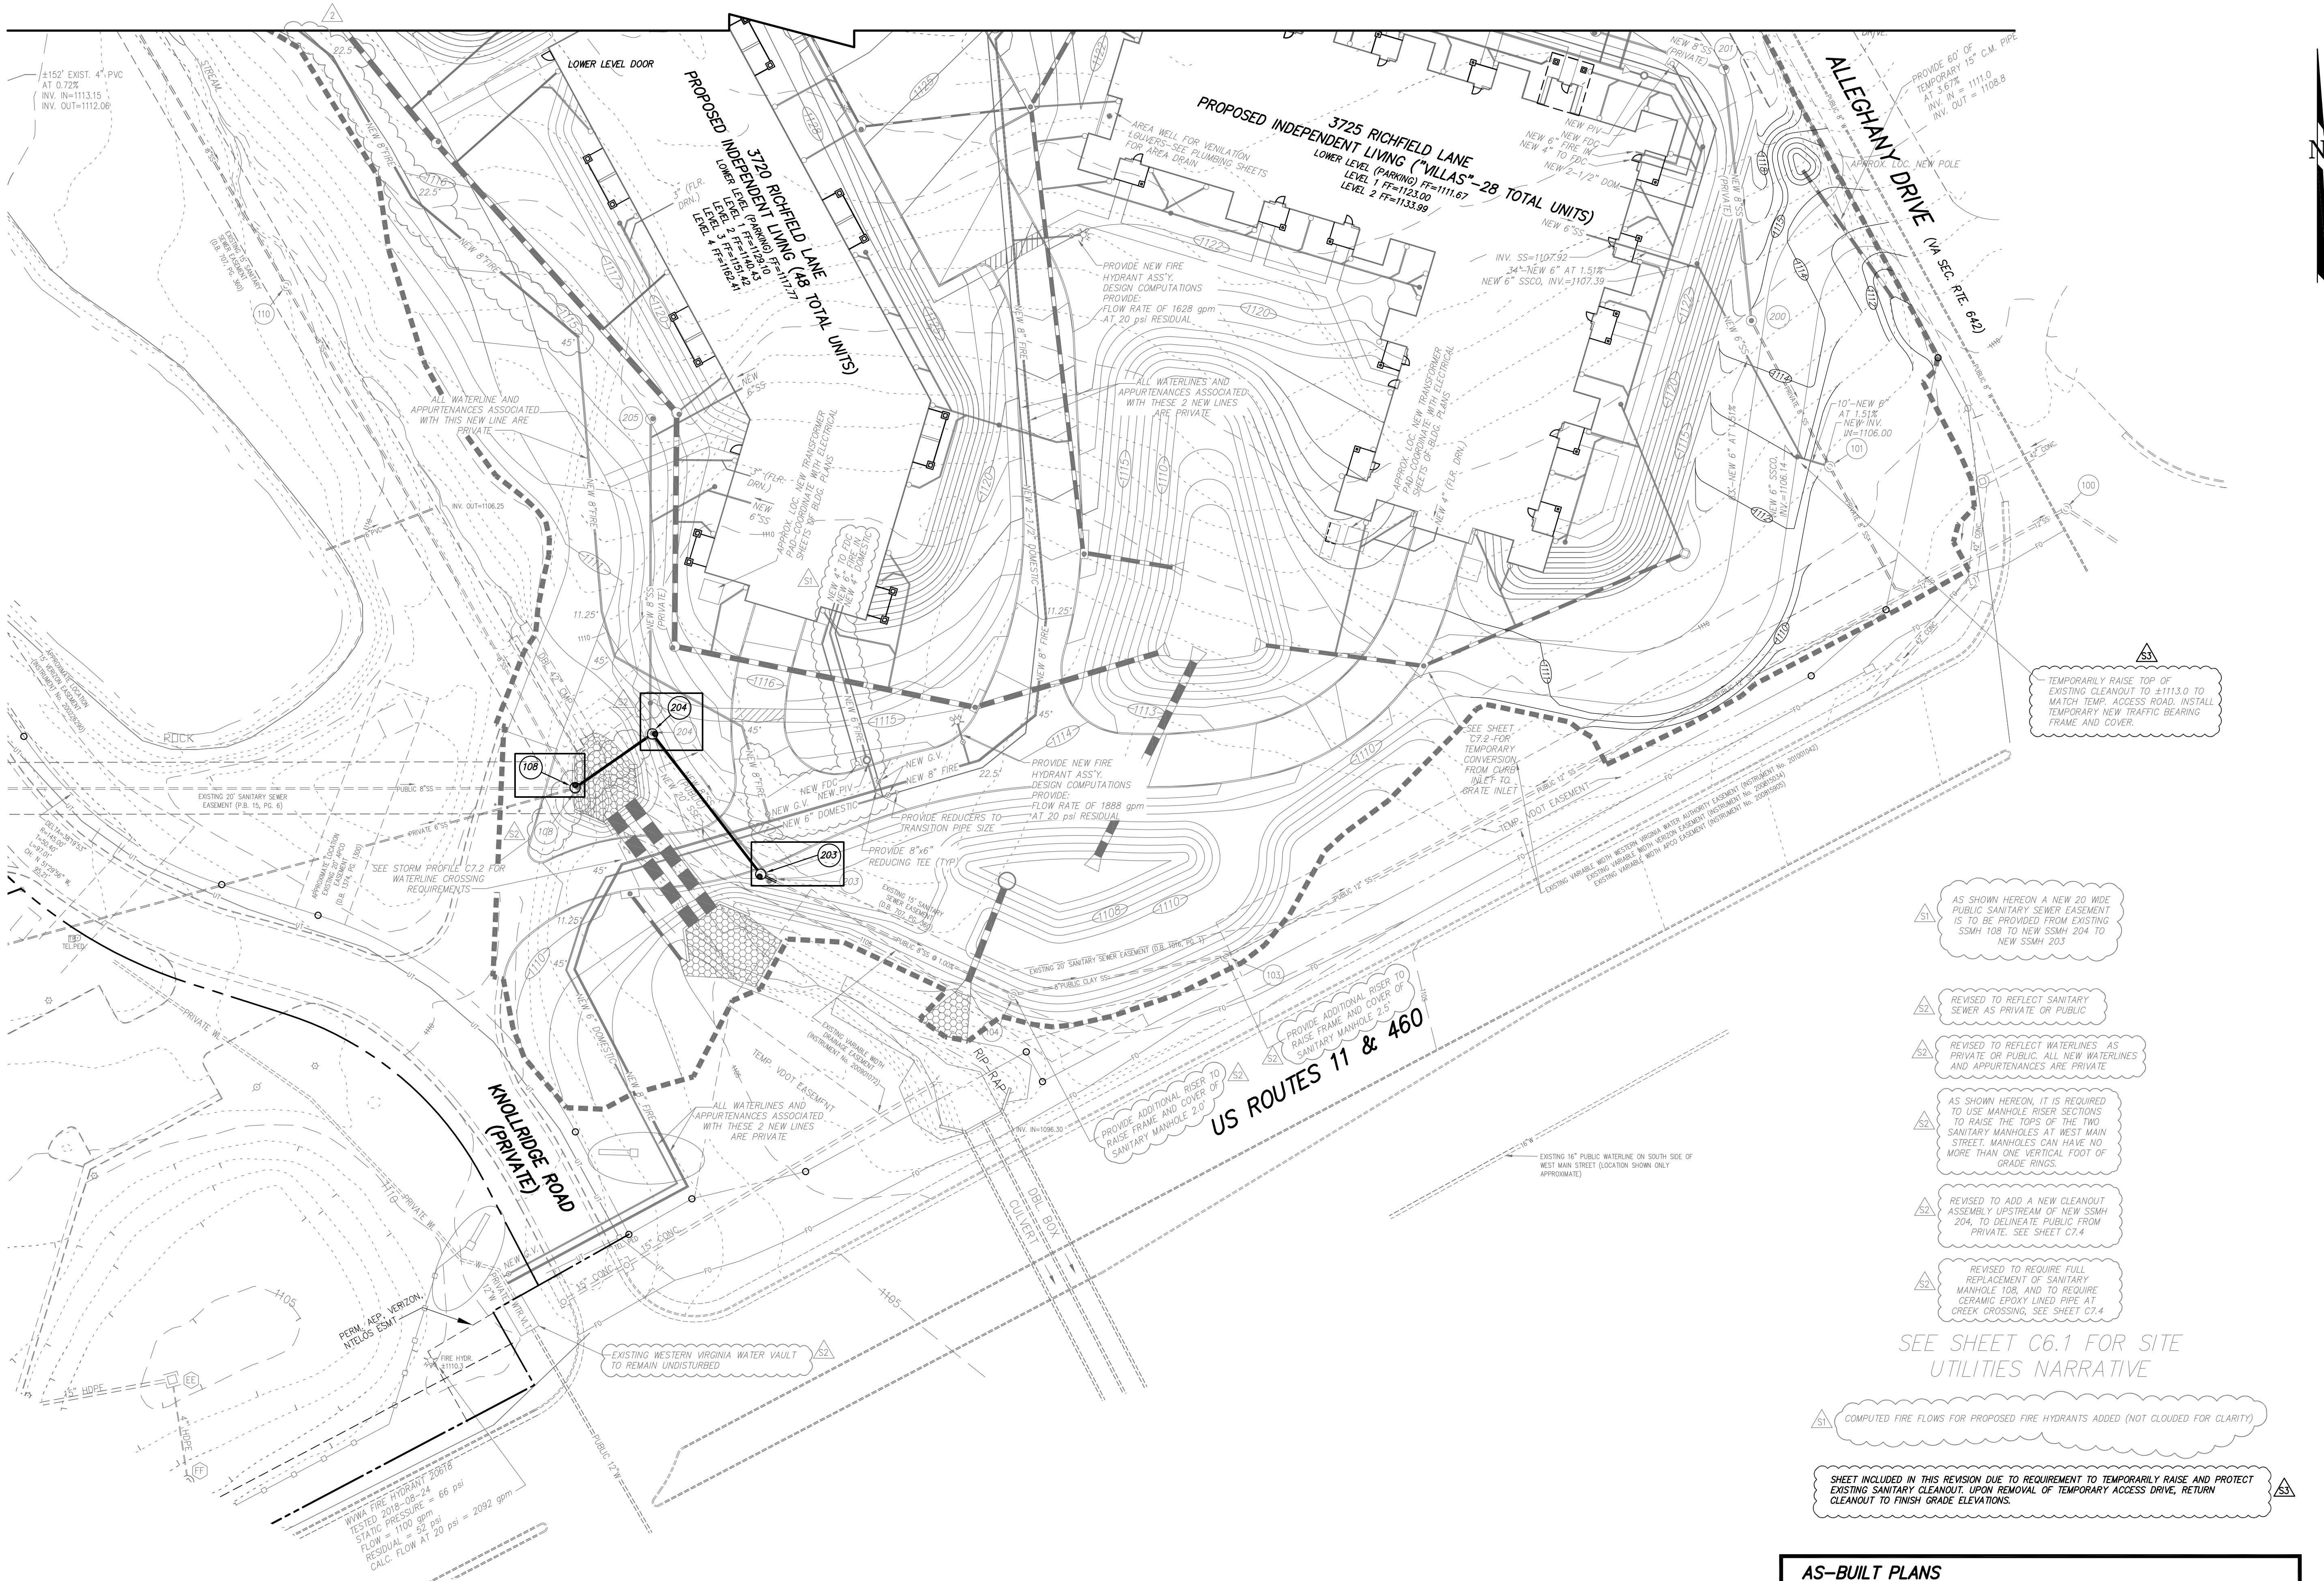

AS-BUILT PLANS
PUBLIC PORTION OF NEW SANITARY SEWER CONSTRUCTION
FIELD-SURVEYED BY CWA

THESE AS-BUILTS CONSIST OF TWO SHEETS:
1. C6.2: PHASE 1-SITE UTILITIES PLAN-SOUTH
2. C7.4: PHASE 1 PROFILES - NEW SANITARY SEWER

AS-BUILT INFORMATION IS SHOWN **BOXED**

JULY 07, 2020 Drawn: C.L. White WO 18-0045

COMMONWEALTH OF VIRGINIA
CORBIN L. WHITE
License No. 23843
07-07-20
PROFESSIONAL ENGINEER

POPE ARCHITECTS

POPE ARCHITECTS, INC.
1295 BANDANA BLVD. N. SUITE 200
ST. PAUL, MN 55108-2735
(651) 642-9200 | FAX (651) 642-1101
www.popearch.com

RICHFIELD LIVING CAMPUS REDEVELOPMENT PART 2 SALEM, VA

RICHFIELD

CWA CALDWELL WHITE ASSOCIATES
ENGINEERS / SURVEYORS / PLANNERS
4005 MEMPHIS AVENUE
P.O. BOX 6290
ROANOKE, VIRGINIA 24017-0290
(540) 368-3400 FAX: (540) 368-6705
Scale: 1" = 30'
W.O. 18-0045 Designed: C.L. White
Drawn: C.L. White

Key Plan

PHASE 1-SITE UTILITIES PLAN-SOUTH

Issues and Revisions:

Date	Revision
10/15/2018	1ST SITE SUBMITTAL
11/09/2018	PERMIT SET
12/19/2018	PER 1ST SITE REVIEW
12/19/2018	CONSTRUCTION SET
01/24/2019	PER 2ND SITE REVIEW
04/02/2019	ADDENDUM 2
01/08/2020	SITE FIELD REV. #1

Commission No: 63132-17186
Drawn by:
Checked by:

C6.2

30' 0' 30' 60'
1" = 30' GRAPHIC SCALE