
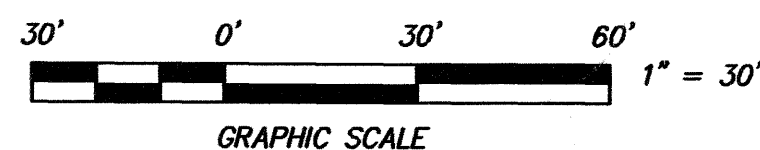


THIS AS-BUILT SURVEY WAS COMPLETED UNDER THE DIRECT AND RESPONSIBLE CHARGE OF, FRANK B. CALDWELL, III, L.S. FROM AN ACTUAL GROUND SURVEY MADE UNDER MY SUPERVISION; THE ORIGINAL DATA WAS OBTAINED ON JUNE 9, 2022; AND THIS DIGITAL GEOSPATIAL DATA INCLUDING METADATA MEETS MINIMUM ACCURACY STANDARDS UNLESS OTHERWISE NOTED.

AS-BUILT SURVEY
FOR
PRILLAMAN AND PACE
SHOWING NEW SANITARY SEWER EXTENSION
SITUATE RICHARD AVENUE, N.E. AND KING STREET, N.E.
CITY OF ROANOKE, VIRGINIA

Drawn: C.L. Hurd
Checked: F.B. Caldwell
Date: JULY 27, 2022
Scale: 1"=20'
Tax Parcel: VARIES
Field Book: WVMA 4
W.O.: 21-0134

CWA
CALDWELL WHITE ASSOCIATES
ENGINEERS / SURVEYORS / PLANNERS
4208 MELROSE AVENUE, N.W., P.O. BOX 6260
ROANOKE, VIRGINIA 24011-0260
Telephone: (540) 366-3400 Fax: (540) 366-6702
E-Mail: cwaroanoke@aol.com

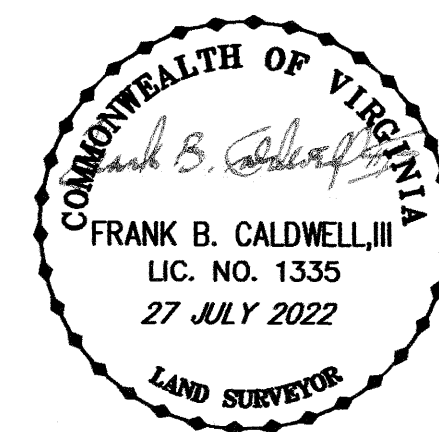

SSCO SEWER CLEANOUT
⊙ SEWER MANHOLE

THIS AS-BUILT SURVEY IS BASED ON THE COORDINATE SYSTEM OF PLANS BY WESTERN VIRGINIA WATER AUTHORITY TITLED RICHARD AVENUE SEWER MAIN EXTENSION (3200 BLOCK), DATED MAY 21, 2021.

THIS AS-BUILT SURVEY IS BASED ON A FIELD SURVEY OF VISIBLE WATERLINE IMPROVEMENTS AND AS-BUILT SKETCHES FROM THE CONTRACTOR FOR UNDERGROUND IMPROVEMENTS. THE FIELD SURVEY WAS COMPLETED BY CALDWELL WHITE ASSOCIATES, CONCLUDED ON JUNE 9, 2022.