



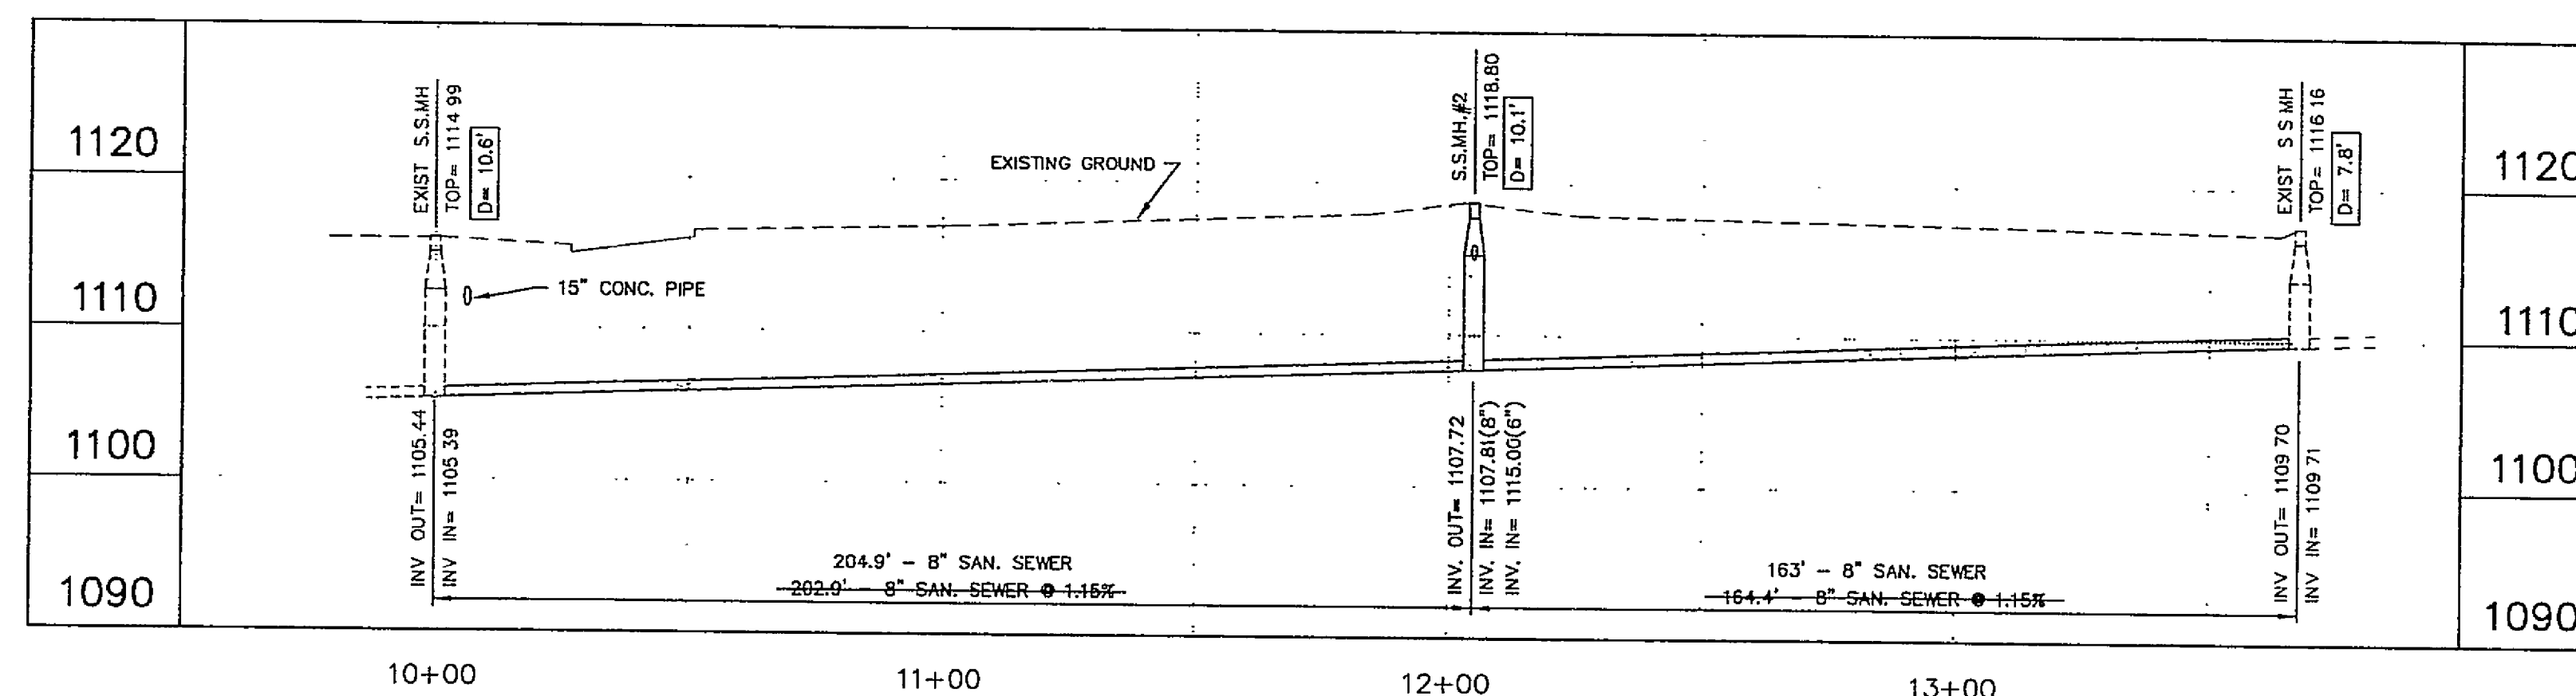


SANITARY SEWER AS-BUILT
SOUTH SIDE OF BUILDING

SCALES: 1"=30' HORIZ.
1"= 5' VERT.

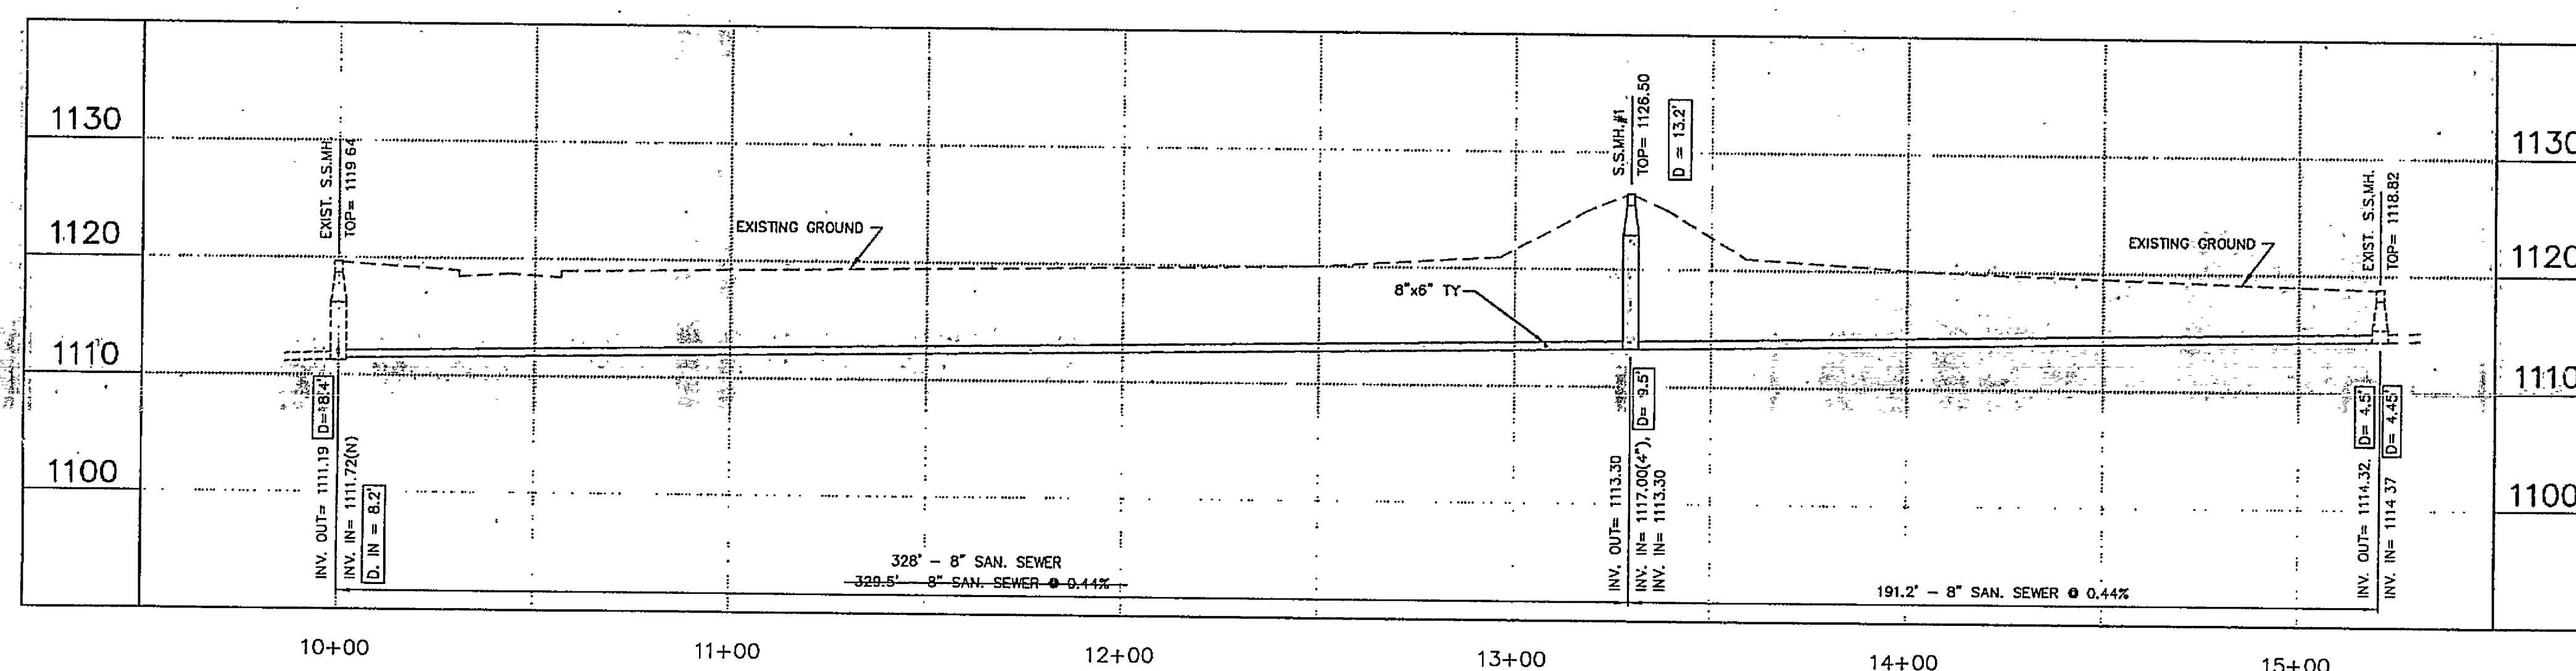

SANITARY SEWER AS-BUILT
NORTH SIDE OF BUILDING

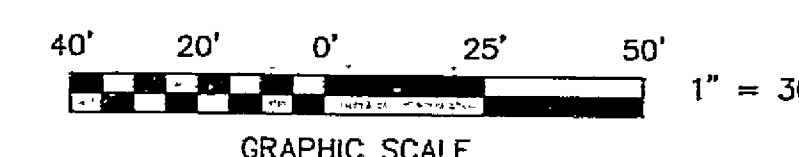

	AS-BUILT PROFILE SANITARY SEWER RICHFIELD RETIREMENT COMMUNITY ASSISTED LIVING FACILITY SITUATE WEST MAIN STREET ROANOKE COUNTY, VIRGINIA SCALE: 1"= 30' DATE: JULY 25, 1994	
	DESIGNED BY: J.J.B. DRAWN BY: F.B.C. CHECKED BY: F.B.C. W.O. #: 92-0954 N.B. R.R. #1 TAX NO. 55.09-1-18.19	T. P. PARKER & SON 816 Boulevard Post Office Box 39 Salem, Virginia 24153 Telephone: 703-587-1153 FAX: 703-589-6767

SHEET AB-3

RC-5554