


"THE RIDGE AT FAIRWAY FOREST"

SITUATED IN
WINDSOR HILLS MAGISTERIAL DISTRICT
ROANOKE COUNTY, VIRGINIA

DATE: March 6, 2007

PREPARED FOR
BOONE HOMES, INC. OF ROANOKE

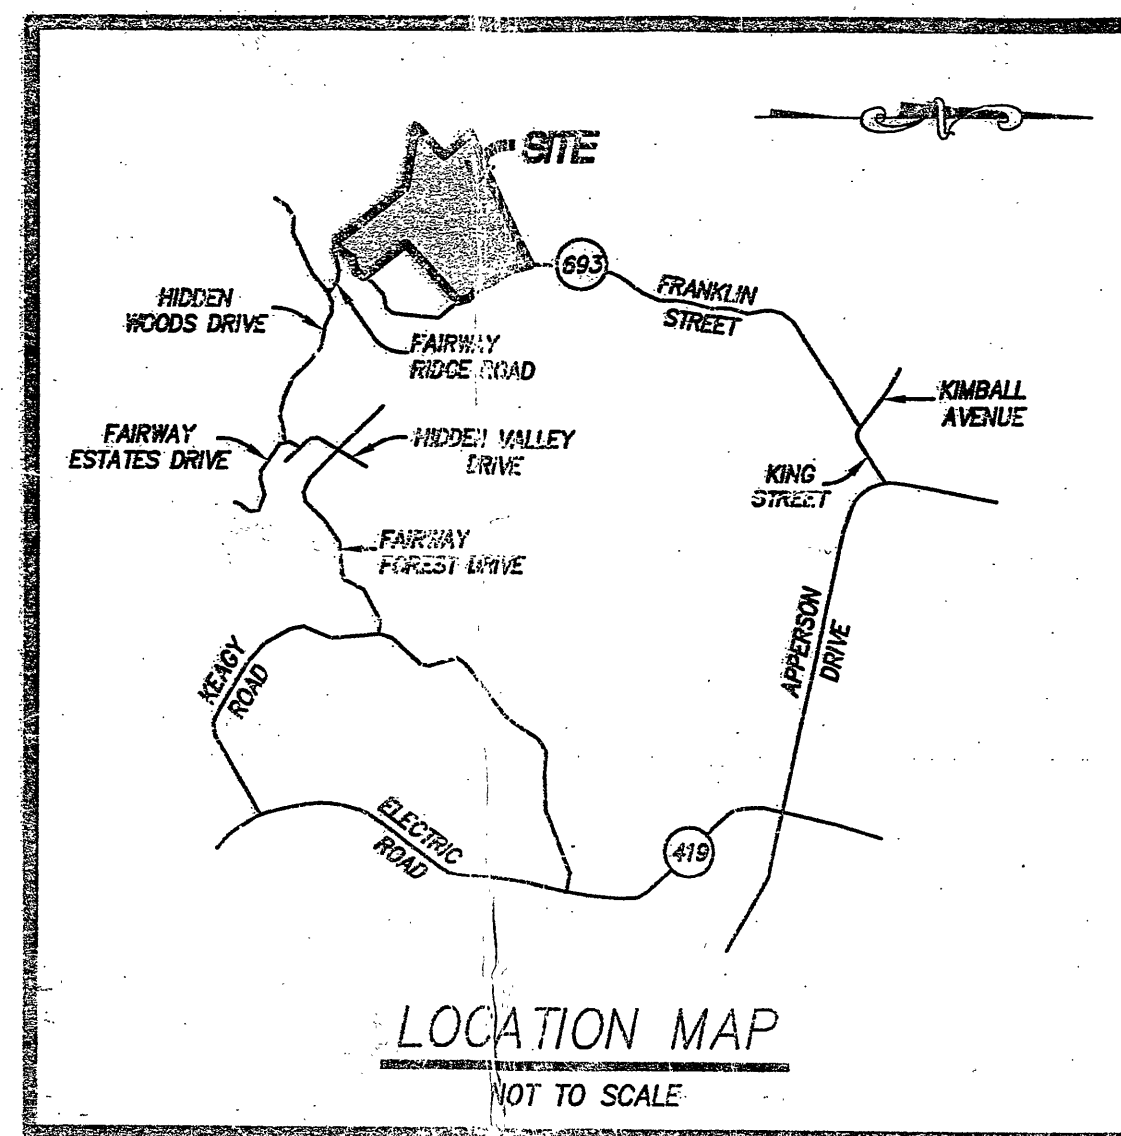


I AM CERTIFIED BY THE STATE OF VIRGINIA AS A "RESPONSIBLE LAND DISTURBER". I SHALL BE RESPONSIBLE FOR THE IMPLEMENTATION OF THE EROSION AND SEDIMENT CONTROL PLAN AS SHOWN.

SIGNATURE: . . . _____
PRINTED NAME: . . . RONALD J. BOOTH
CERTIFICATE No.: . . . 12589
EXPIRATION DATE: . . . 1/03/68
TELEPHONE No.: . . . (540) 772-3887
ADDRESS: . . . P. O. BOX 8156
ROANOKE, VA 24014

--INDEX OF DRAWINGS--	
SHEET No.	DESCRIPTION
1	General Notes
2	Foundation Details
3	Structural Details
4	Roof Details
5	Interior Details
6	Exterior Details
7	Electrical Details
8	Plumbing Details
9	HVAC Details
10	Finishes Details
11	Site Plan
12	Section A-A
13	Section B-B
14	Section C-C
15	Section D-D
16	Section E-E
17	Section F-F
18	Section G-G
19	Section H-H
20	Section I-I
21	Section J-J
22	Section K-K
23	Section L-L
24	Section M-M
25	Section N-N
26	Section O-O
27	Section P-P
28	Section Q-Q
29	Section R-R
30	Section S-S
31	Section T-T
32	Section U-U
33	Section V-V
34	Section W-W
35	Section X-X
36	Section Y-Y
37	Section Z-Z
38	Section AA-AA
39	Section BB-BB
40	Section CC-CC
41	Section DD-DD
42	Section EE-EE
43	Section FF-FF
44	Section GG-GG
45	Section HH-HH
46	Section II-II
47	Section JJ-JJ
48	Section KK-KK
49	Section LL-LL
50	Section MM-MM
51	Section NN-NN
52	Section OO-OO
53	Section PP-PP
54	Section QQ-QQ
55	Section RR-RR
56	Section SS-SS
57	Section TT-TT
58	Section UU-UU
59	Section VV-VV
60	Section WW-WW
61	Section XX-XX
62	Section YY-YY
63	Section ZZ-ZZ
64	Section AA-AA
65	Section BB-BB
66	Section CC-CC
67	Section DD-DD
68	Section EE-EE
69	Section FF-FF
70	Section GG-GG
71	Section HH-HH
72	Section II-II
73	Section JJ-JJ
74	Section KK-KK
75	Section LL-LL
76	Section MM-MM
77	Section NN-NN
78	Section OO-OO
79	Section PP-PP
80	Section QQ-QQ
81	Section RR-RR
82	Section SS-SS
83	Section TT-TT
84	Section UU-UU
85	Section VV-VV
86	Section WW-WW
87	Section XX-XX
88	Section YY-YY
89	Section ZZ-ZZ
90	Section AA-AA
91	Section BB-BB
92	Section CC-CC
93	Section DD-DD
94	Section EE-EE
95	Section FF-FF
96	Section GG-GG
97	Section HH-HH
98	Section II-II
99	Section JJ-JJ
100	Section KK-KK


1. LUMSDEN ASSOCIATES COVER SHEET
2. ROANOKE COUNTY COVER SHEET
3. RECORD PLAT
4. OVERALL CONCEPT LAYOUT
5. NOTES AND DETAILS
6. DIMENSIONAL LAYOUT
7. DIMENSIONAL LAYOUT
8. GRADING PLAN
9. GRADING PLAN
10. ROAD PROFILES
11. ROAD PROFILES
12. STORM DRAIN PROFILES
13. STORM DRAIN PROFILES
14. STORM DRAIN AND RETAINING WALL PROFILES
15. SANITARY SEWER PROFILES
16. EROSION AND SEDIMENT CONTROL PLAN
17. EROSION AND SEDIMENT CONTROL PLAN
18. EROSION AND SEDIMENT CONTROL NOTES AND DETAILS
19. EROSION CONTROL NARRATIVE & SEDIMENT BASIN DETAILS
20. WATER AND SANITARY SEWER DETAILS

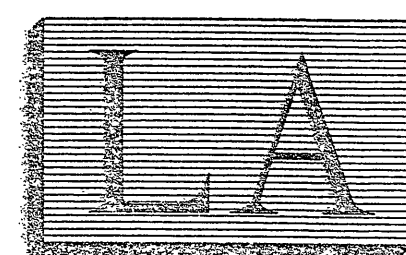

LUMSDEN ASSOCIATES, P.C.
ENGINEERS-SURVEYORS-PLANNERS

4664 BRAMBLETON AVENUE, SW
P.O. BOX 20669
ROANOKE, VIRGINIA 24018

PHONE: (540) 774-4411
FAX: (540) 772-9445
E-MAIL: MAIL@LUMSDENPC.COM

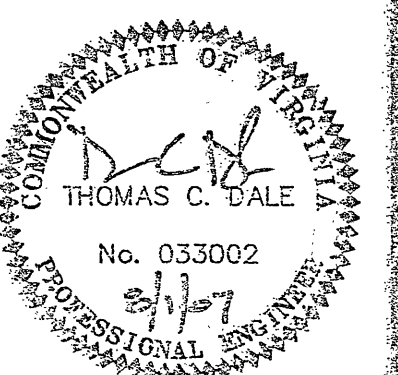

REVISIONS	
DATE	SHEETS
6/21/07	1, 6-9, 14 & 16-17
8/01/07	7, 9, 15, & 16

COMMISSION NO: 2005-006

SHEET 1 OF 20

AS BUILT