


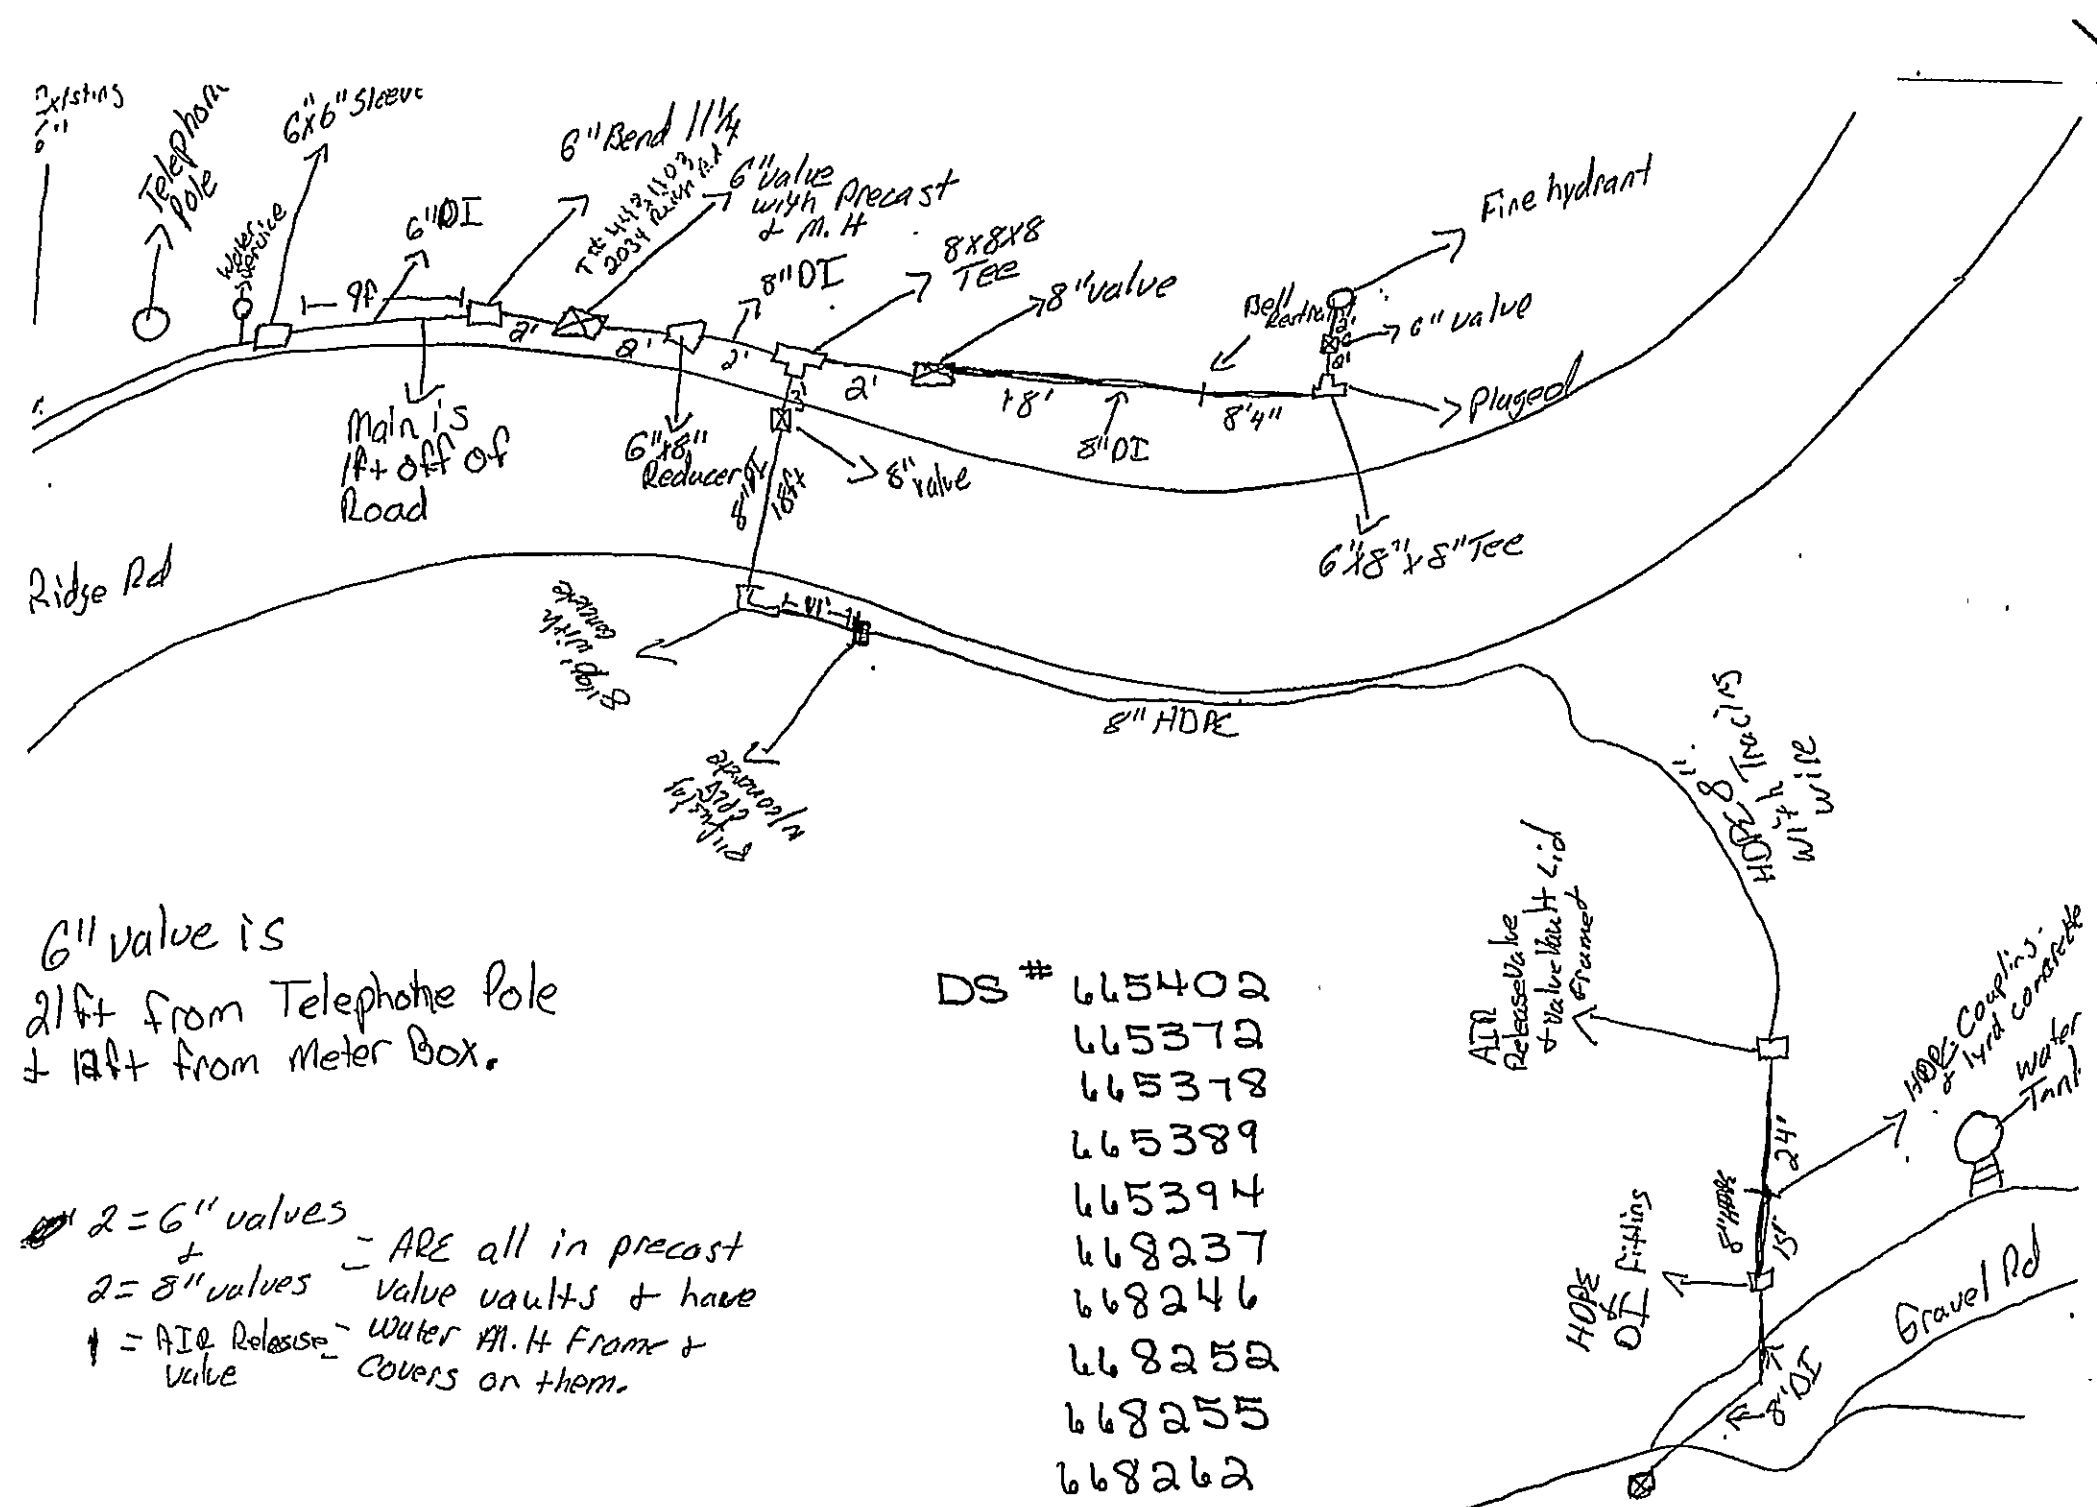

6" valve is
21ft from Telephone Pole
+ 12ft from Meter Box.

2 = 6" valves - ARE all in precast
+
2 = 8" valves - value vaults + have
+ = A.I.E. Release - Water M.H. Frame +
Valve Covers on them.

- DS #
- 665402
 - 665372
 - 665378
 - 665389
 - 665394
 - 668237
 - 668246
 - 668252
 - 668255
 - 668262

July 16, 2008
Asbuilt of Mt. Pleasant Intercon.
Copy

