
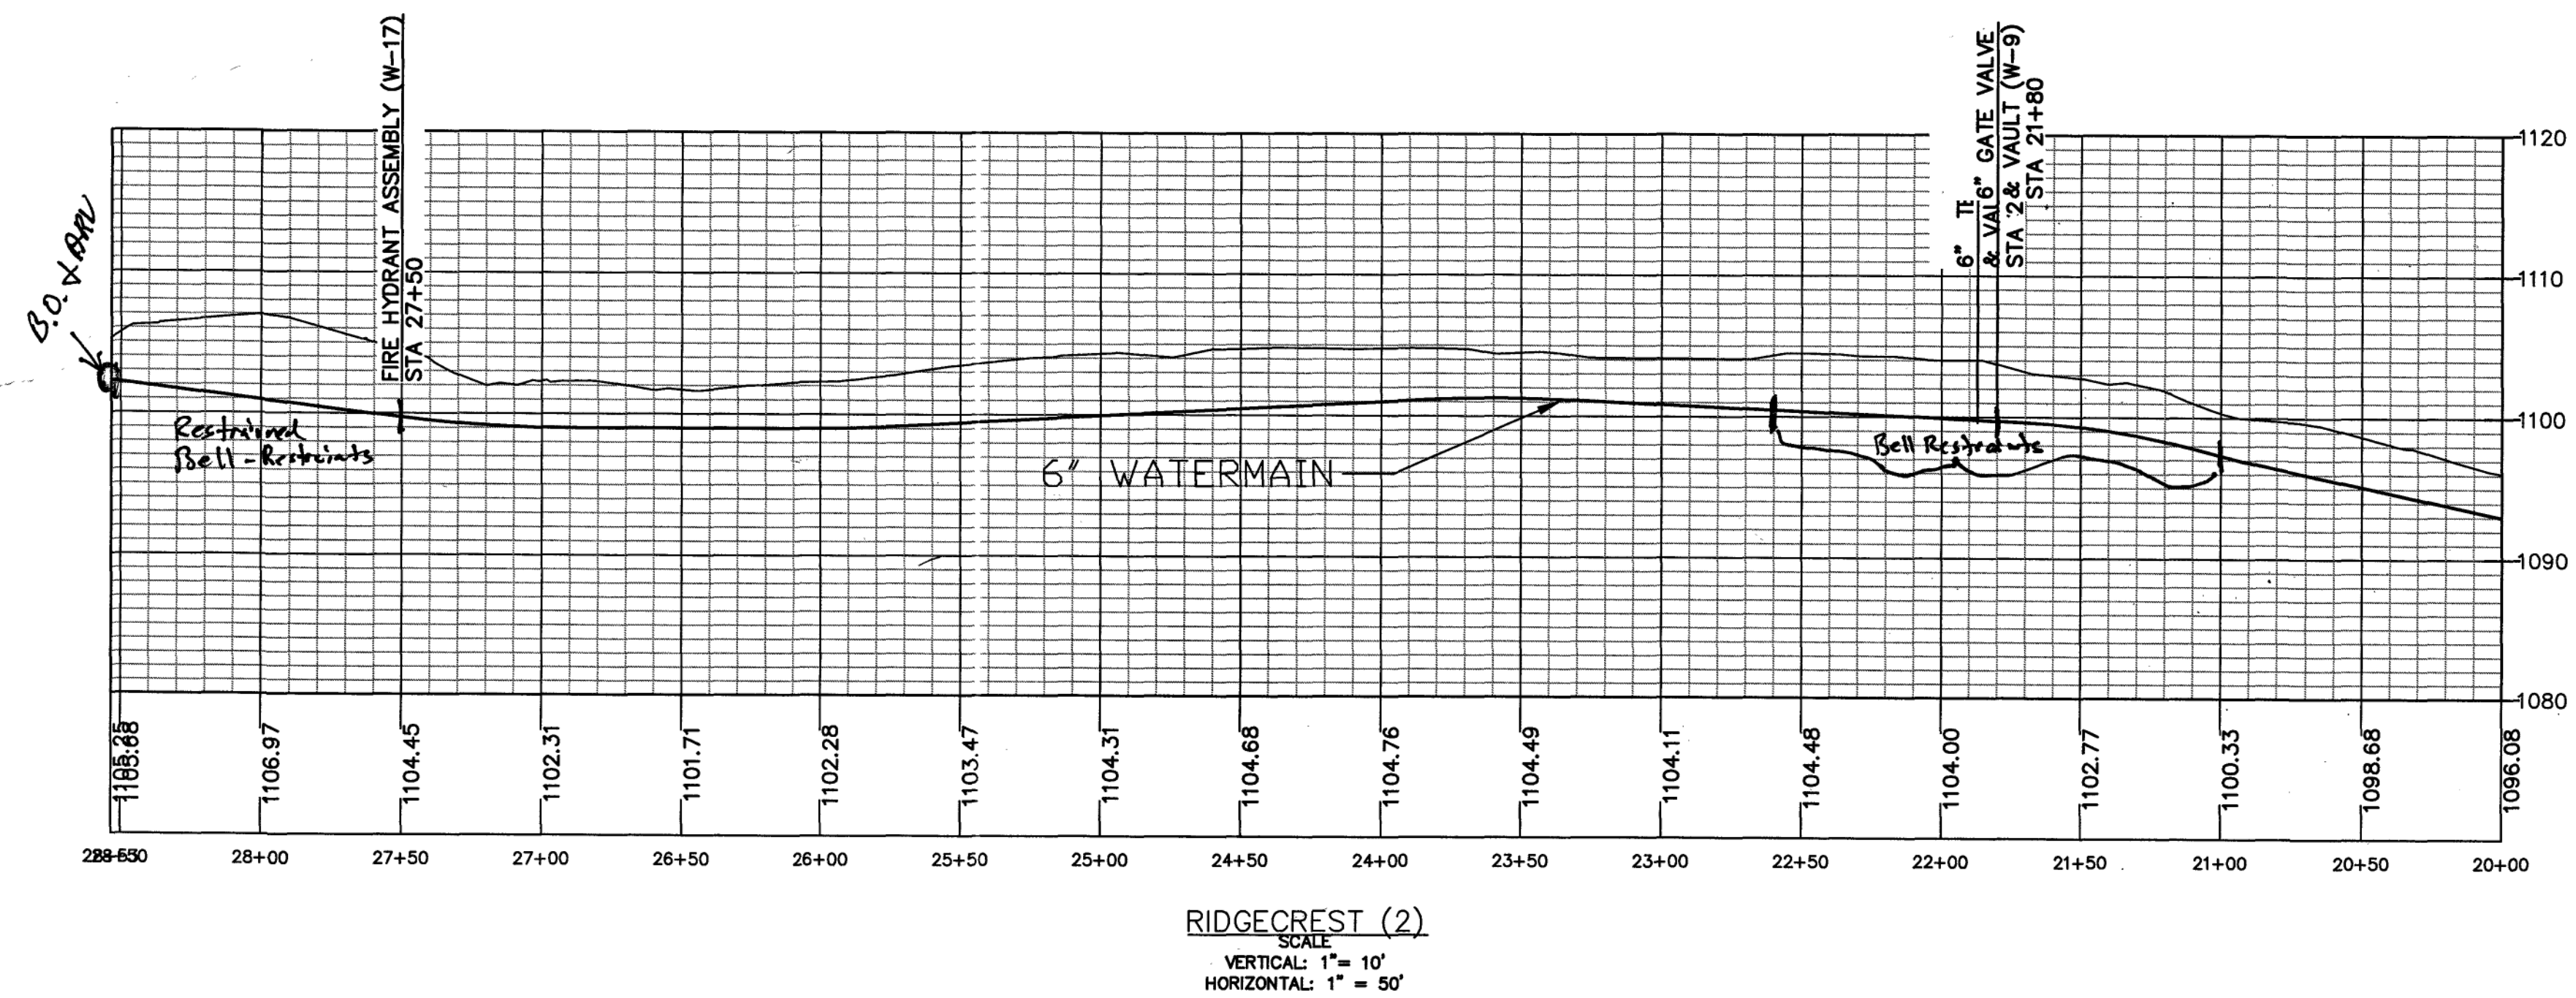
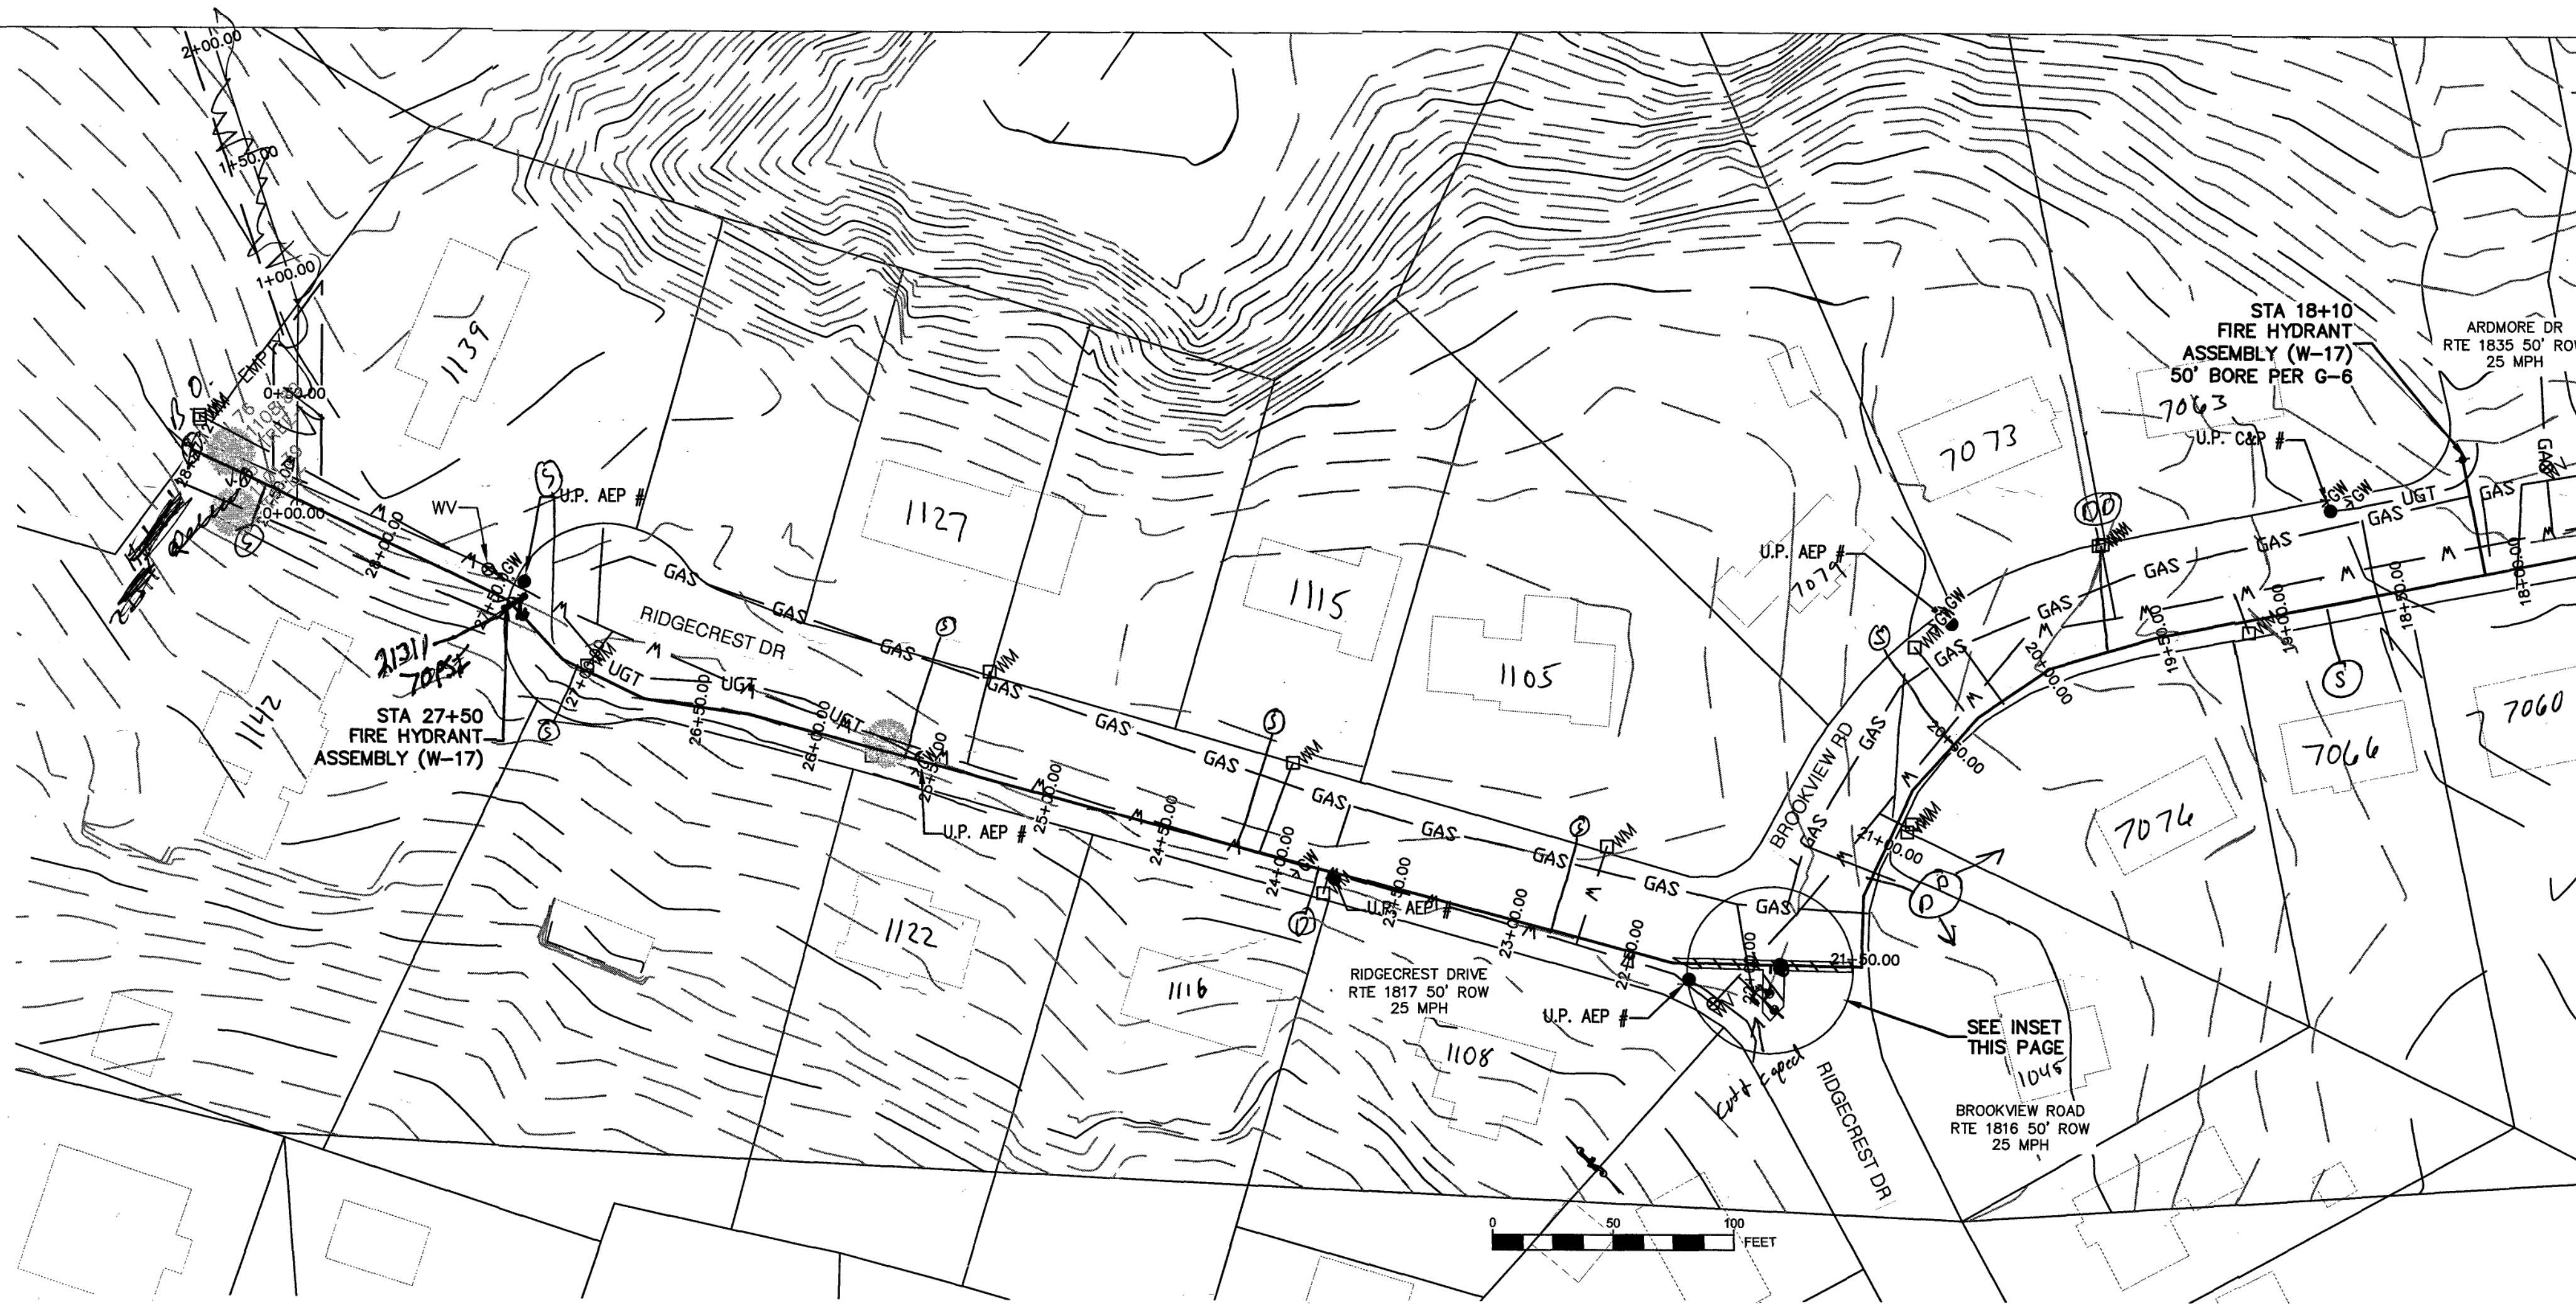


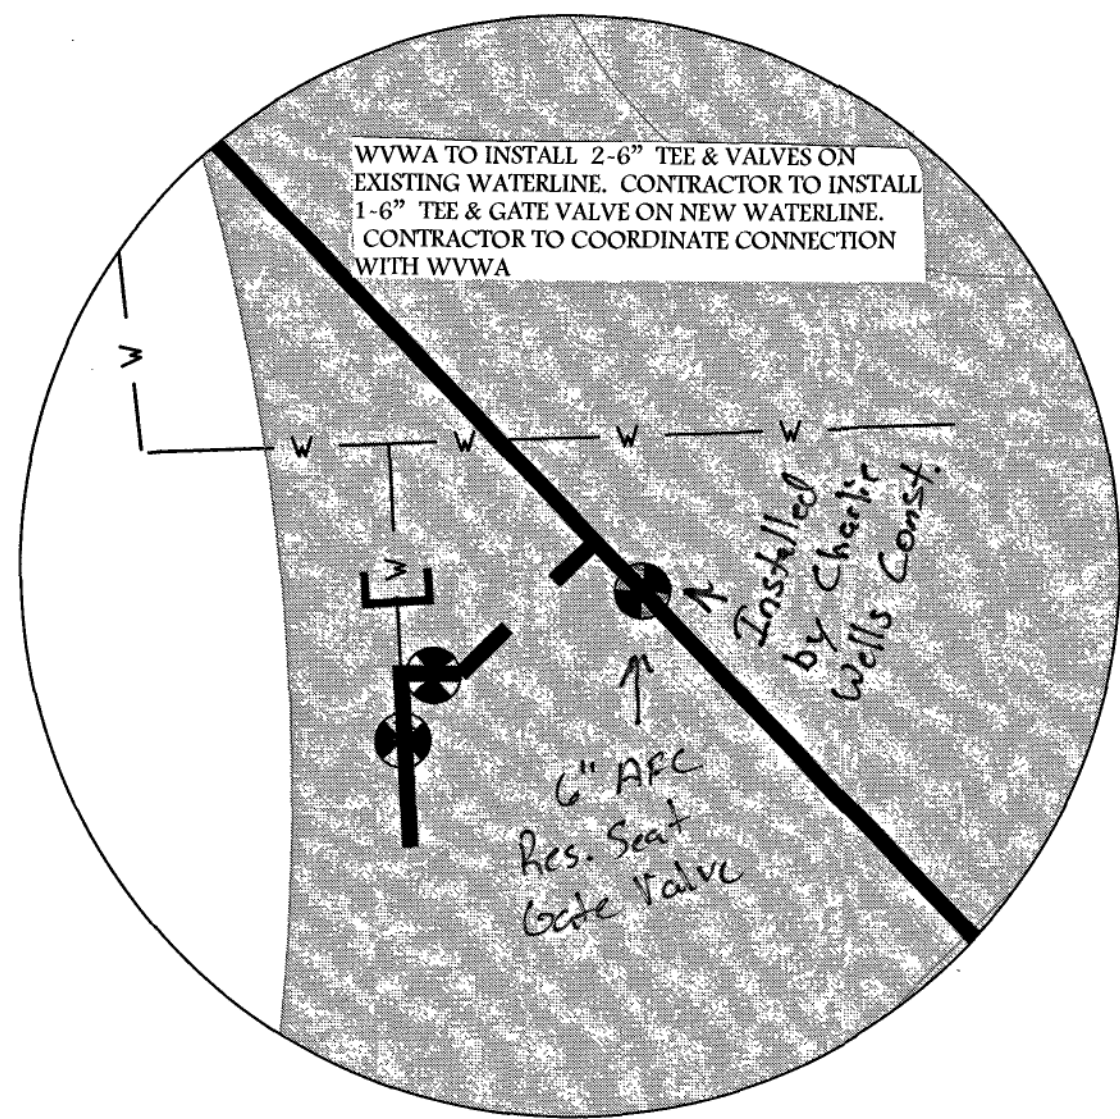

WESTERN VIRGINIA

WATER AUTHORITY

ENGINEERING SERVICES
601 S JEFFERSON ST, SUITE 300
ROANOKE, VA 24011
540-853-5641 or 540-853-5770

RIDGECREST WATER

PLAN & PROFILE

Rev	Description	Date	By
1	As-Built	08/25/2016	

Designed: AAS
 Drawn: AAS
 Checked: NR
 Approved: _____
 Date: 5-13-16
 Project: _____

3

Sheet 3 of 5