

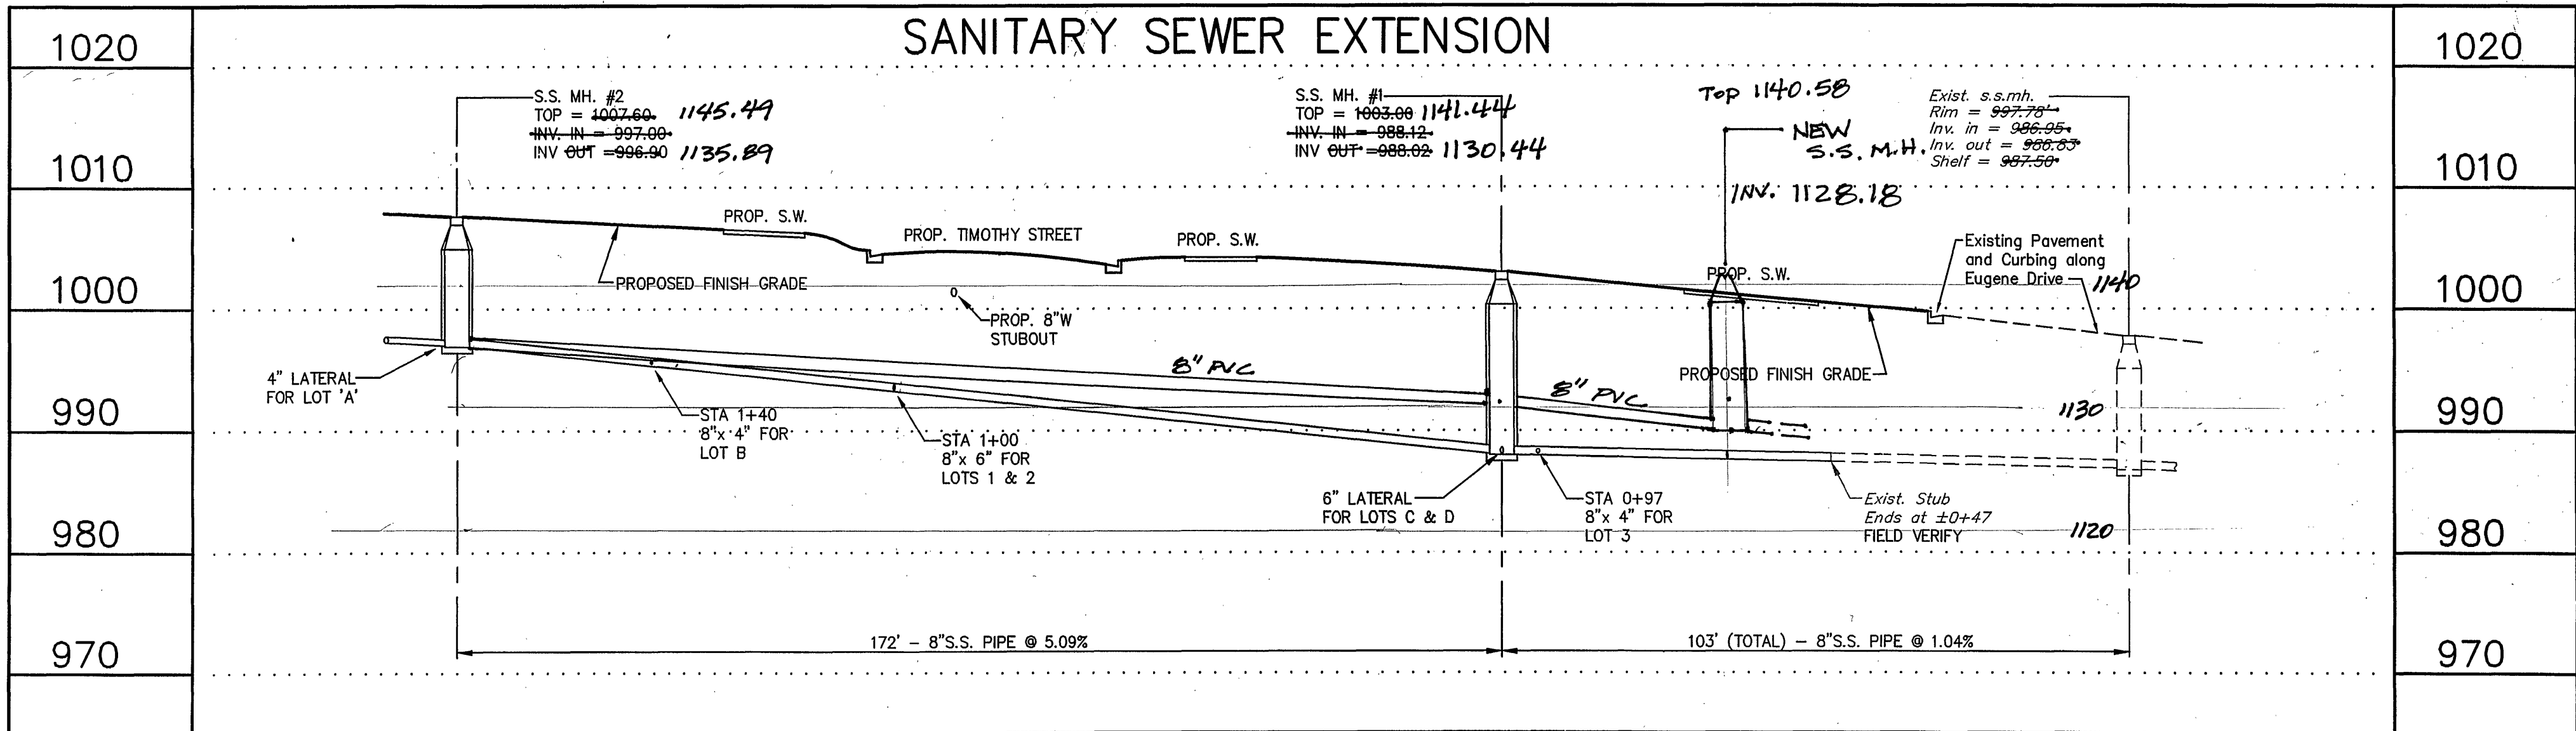
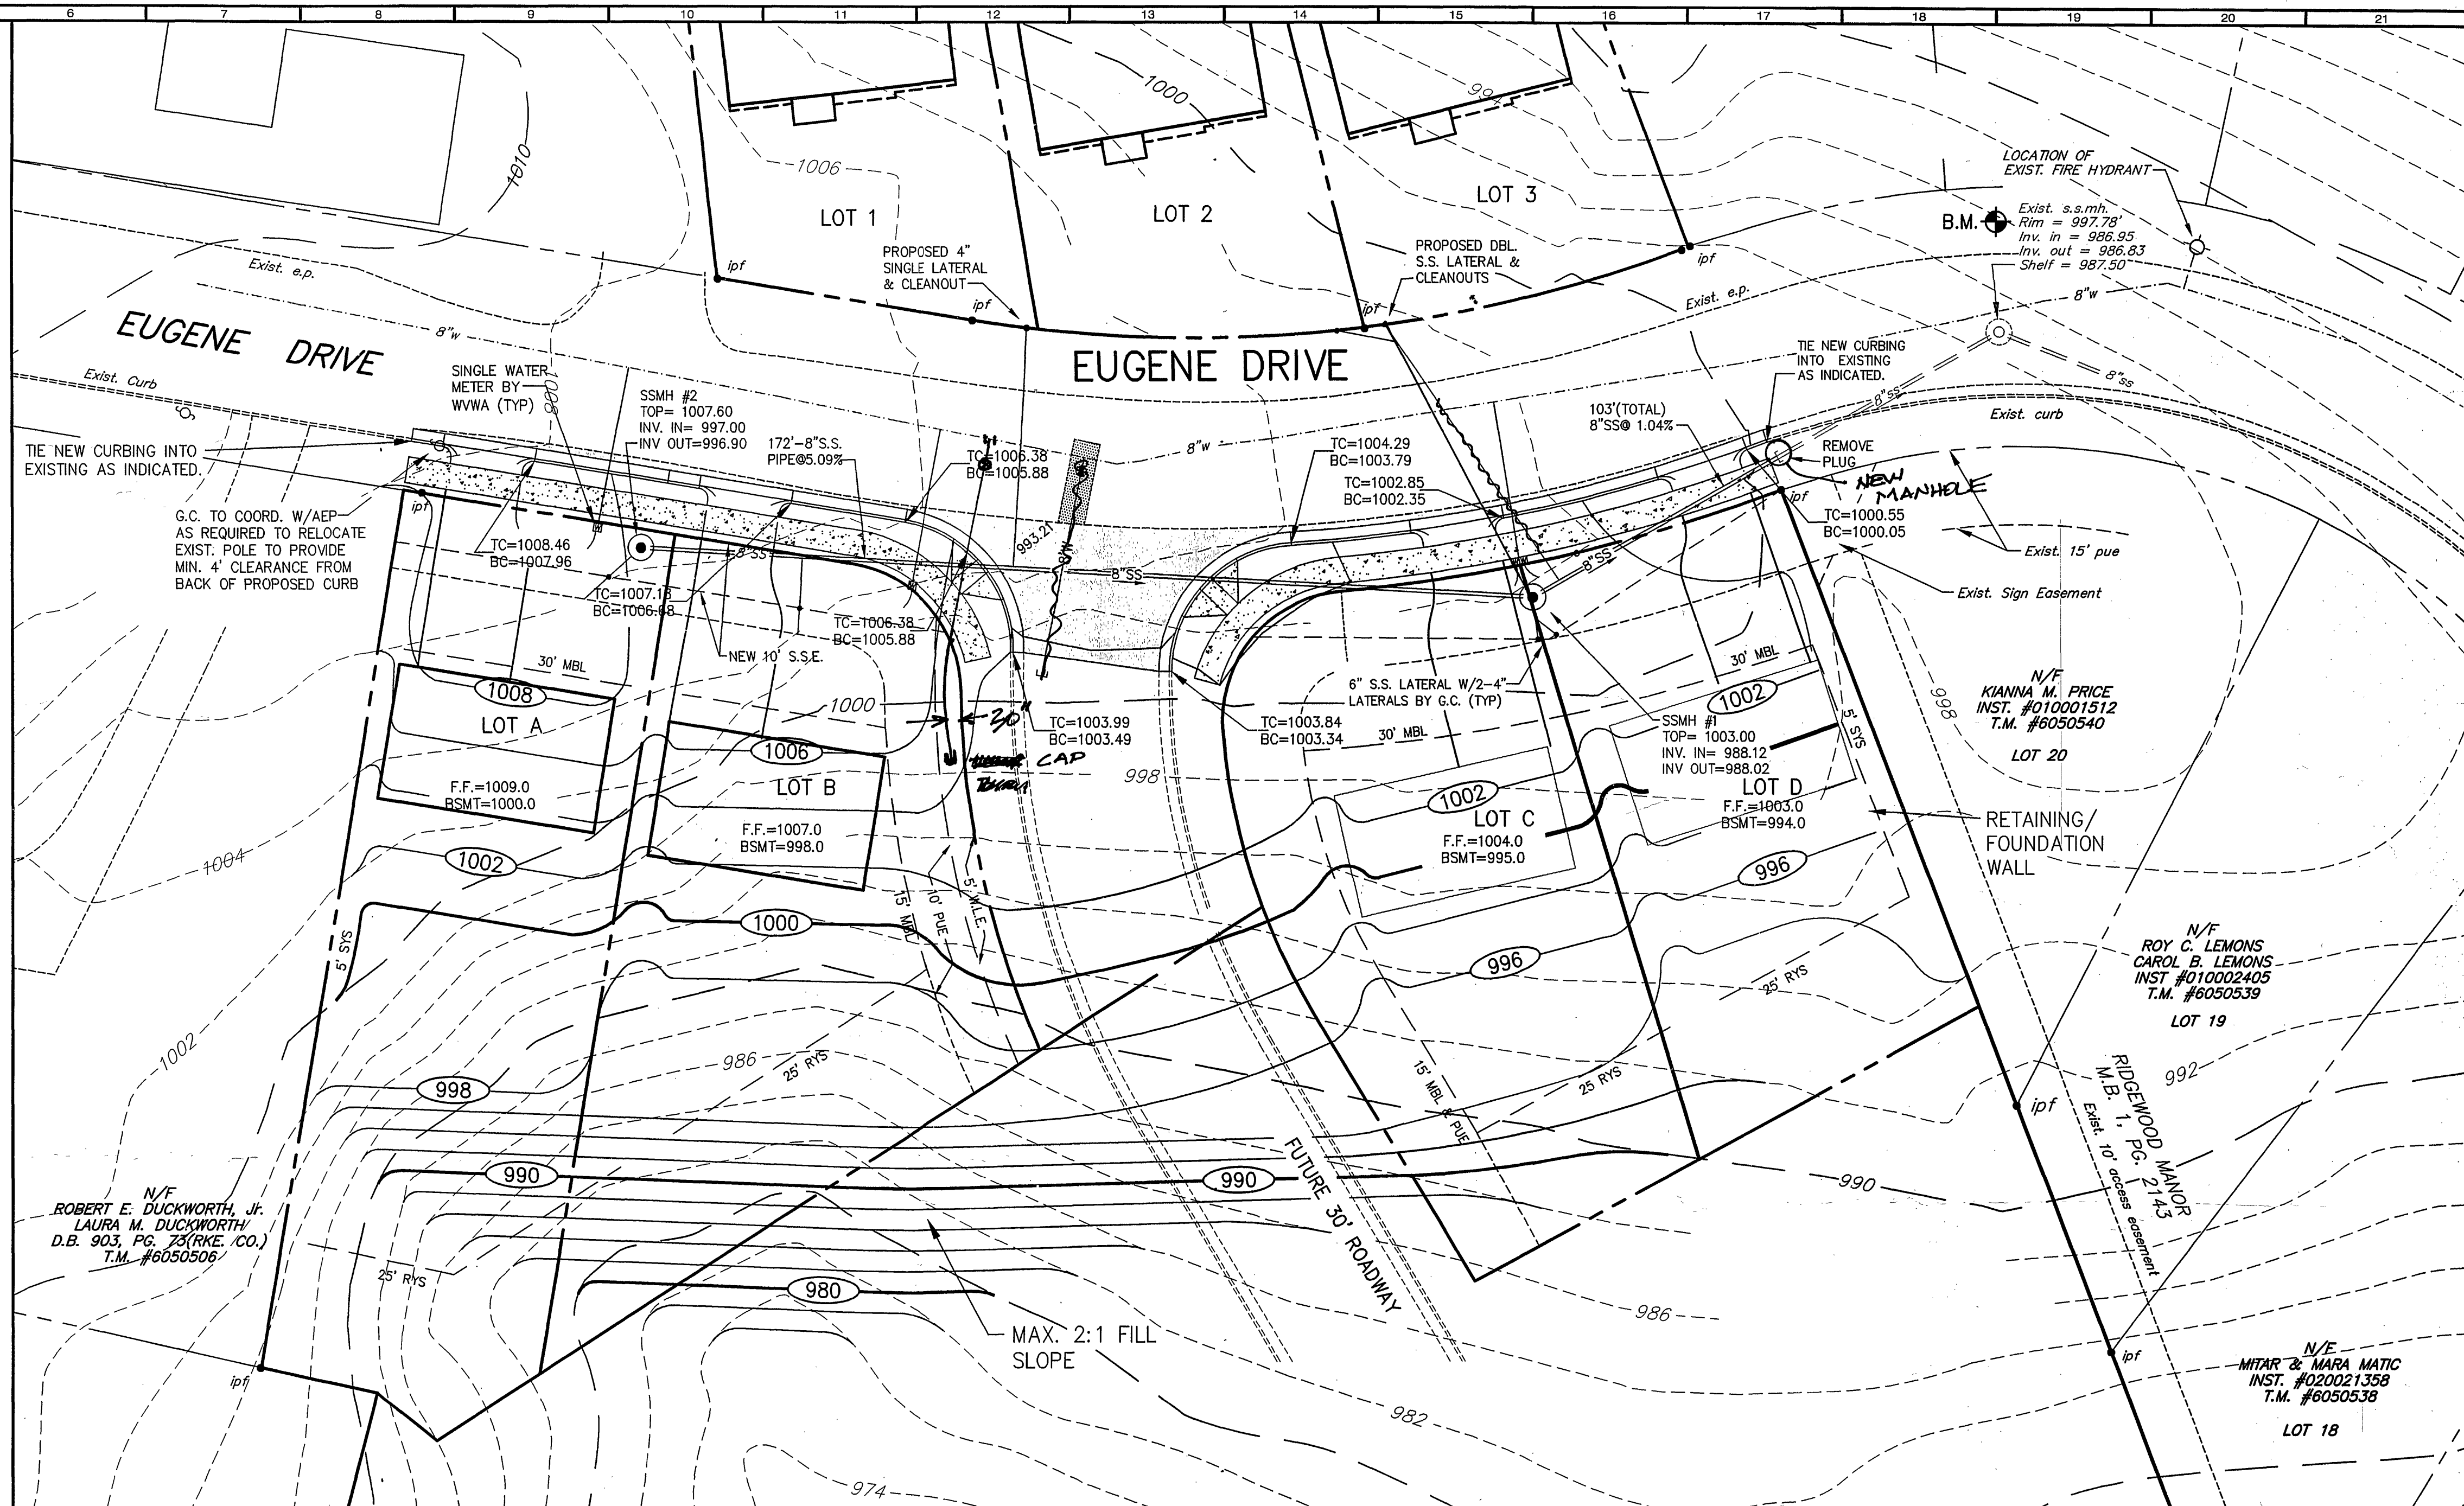


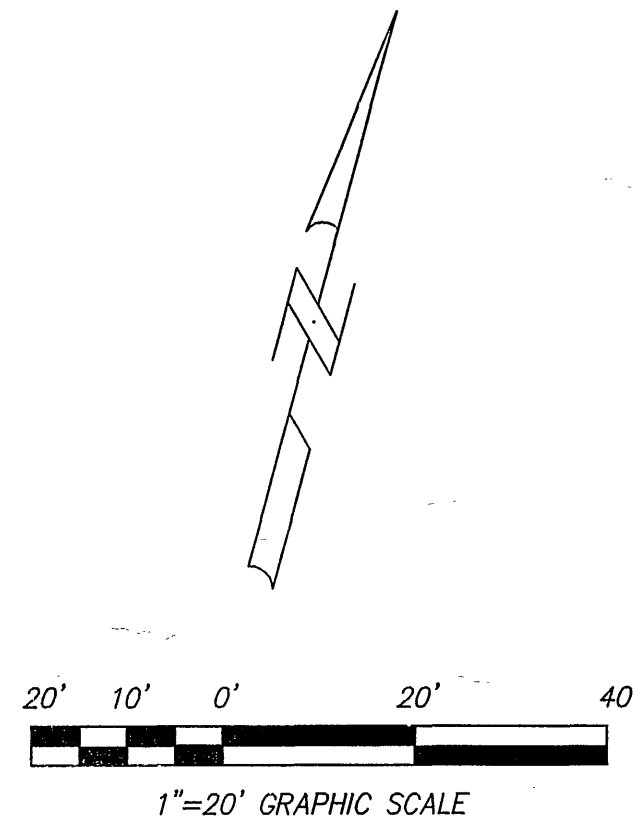

AS BUILT
1/10/2007

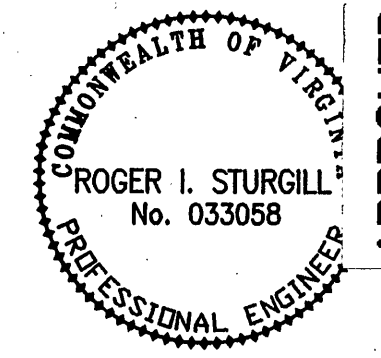

PLANNERS • ARCHITECTS
ENGINEERS • SURVEYORS

1208 Corporate Circle
Roanoke, Virginia 24018
Phone: 540/772-9580
FAX: 540/772-8050

501 Branchway Road
Richmond, Virginia 23236
Phone: 804/794-0271
FAX: 804/794-2635

880 Technology Park Drive
Suite 200
Chen Allen, Virginia 23059
Phone: 804/553-0132
FAX: 804/553-0133

448 Pappas Ferry Road
Christiansburg, Virginia 24073
Phone: 540/381-4990
FAX: 540/381-4291

1587 Commerce Road
Suite 201
Vienna, Virginia 24462
Phone: 540/245-3290
FAX: 540/245-3221

RIDGEWOOD PLACE
SECTION 1
FIELD REVISIONS #1
ROANOKE CITY
ROANOKE, VIRGINIA

DRAWN BY: CPB
DESIGNED BY: JVJ
CHECKED BY: SMH
DATE: 06/29/2006
REVISIONS:

SCALE: 1"= 20'
SHEET NO.
F-1
JOB NO.
R0400131.01

EUGENE DRIVE / RIDGEWOOD PLACE (APPROVED) AS BUILT