



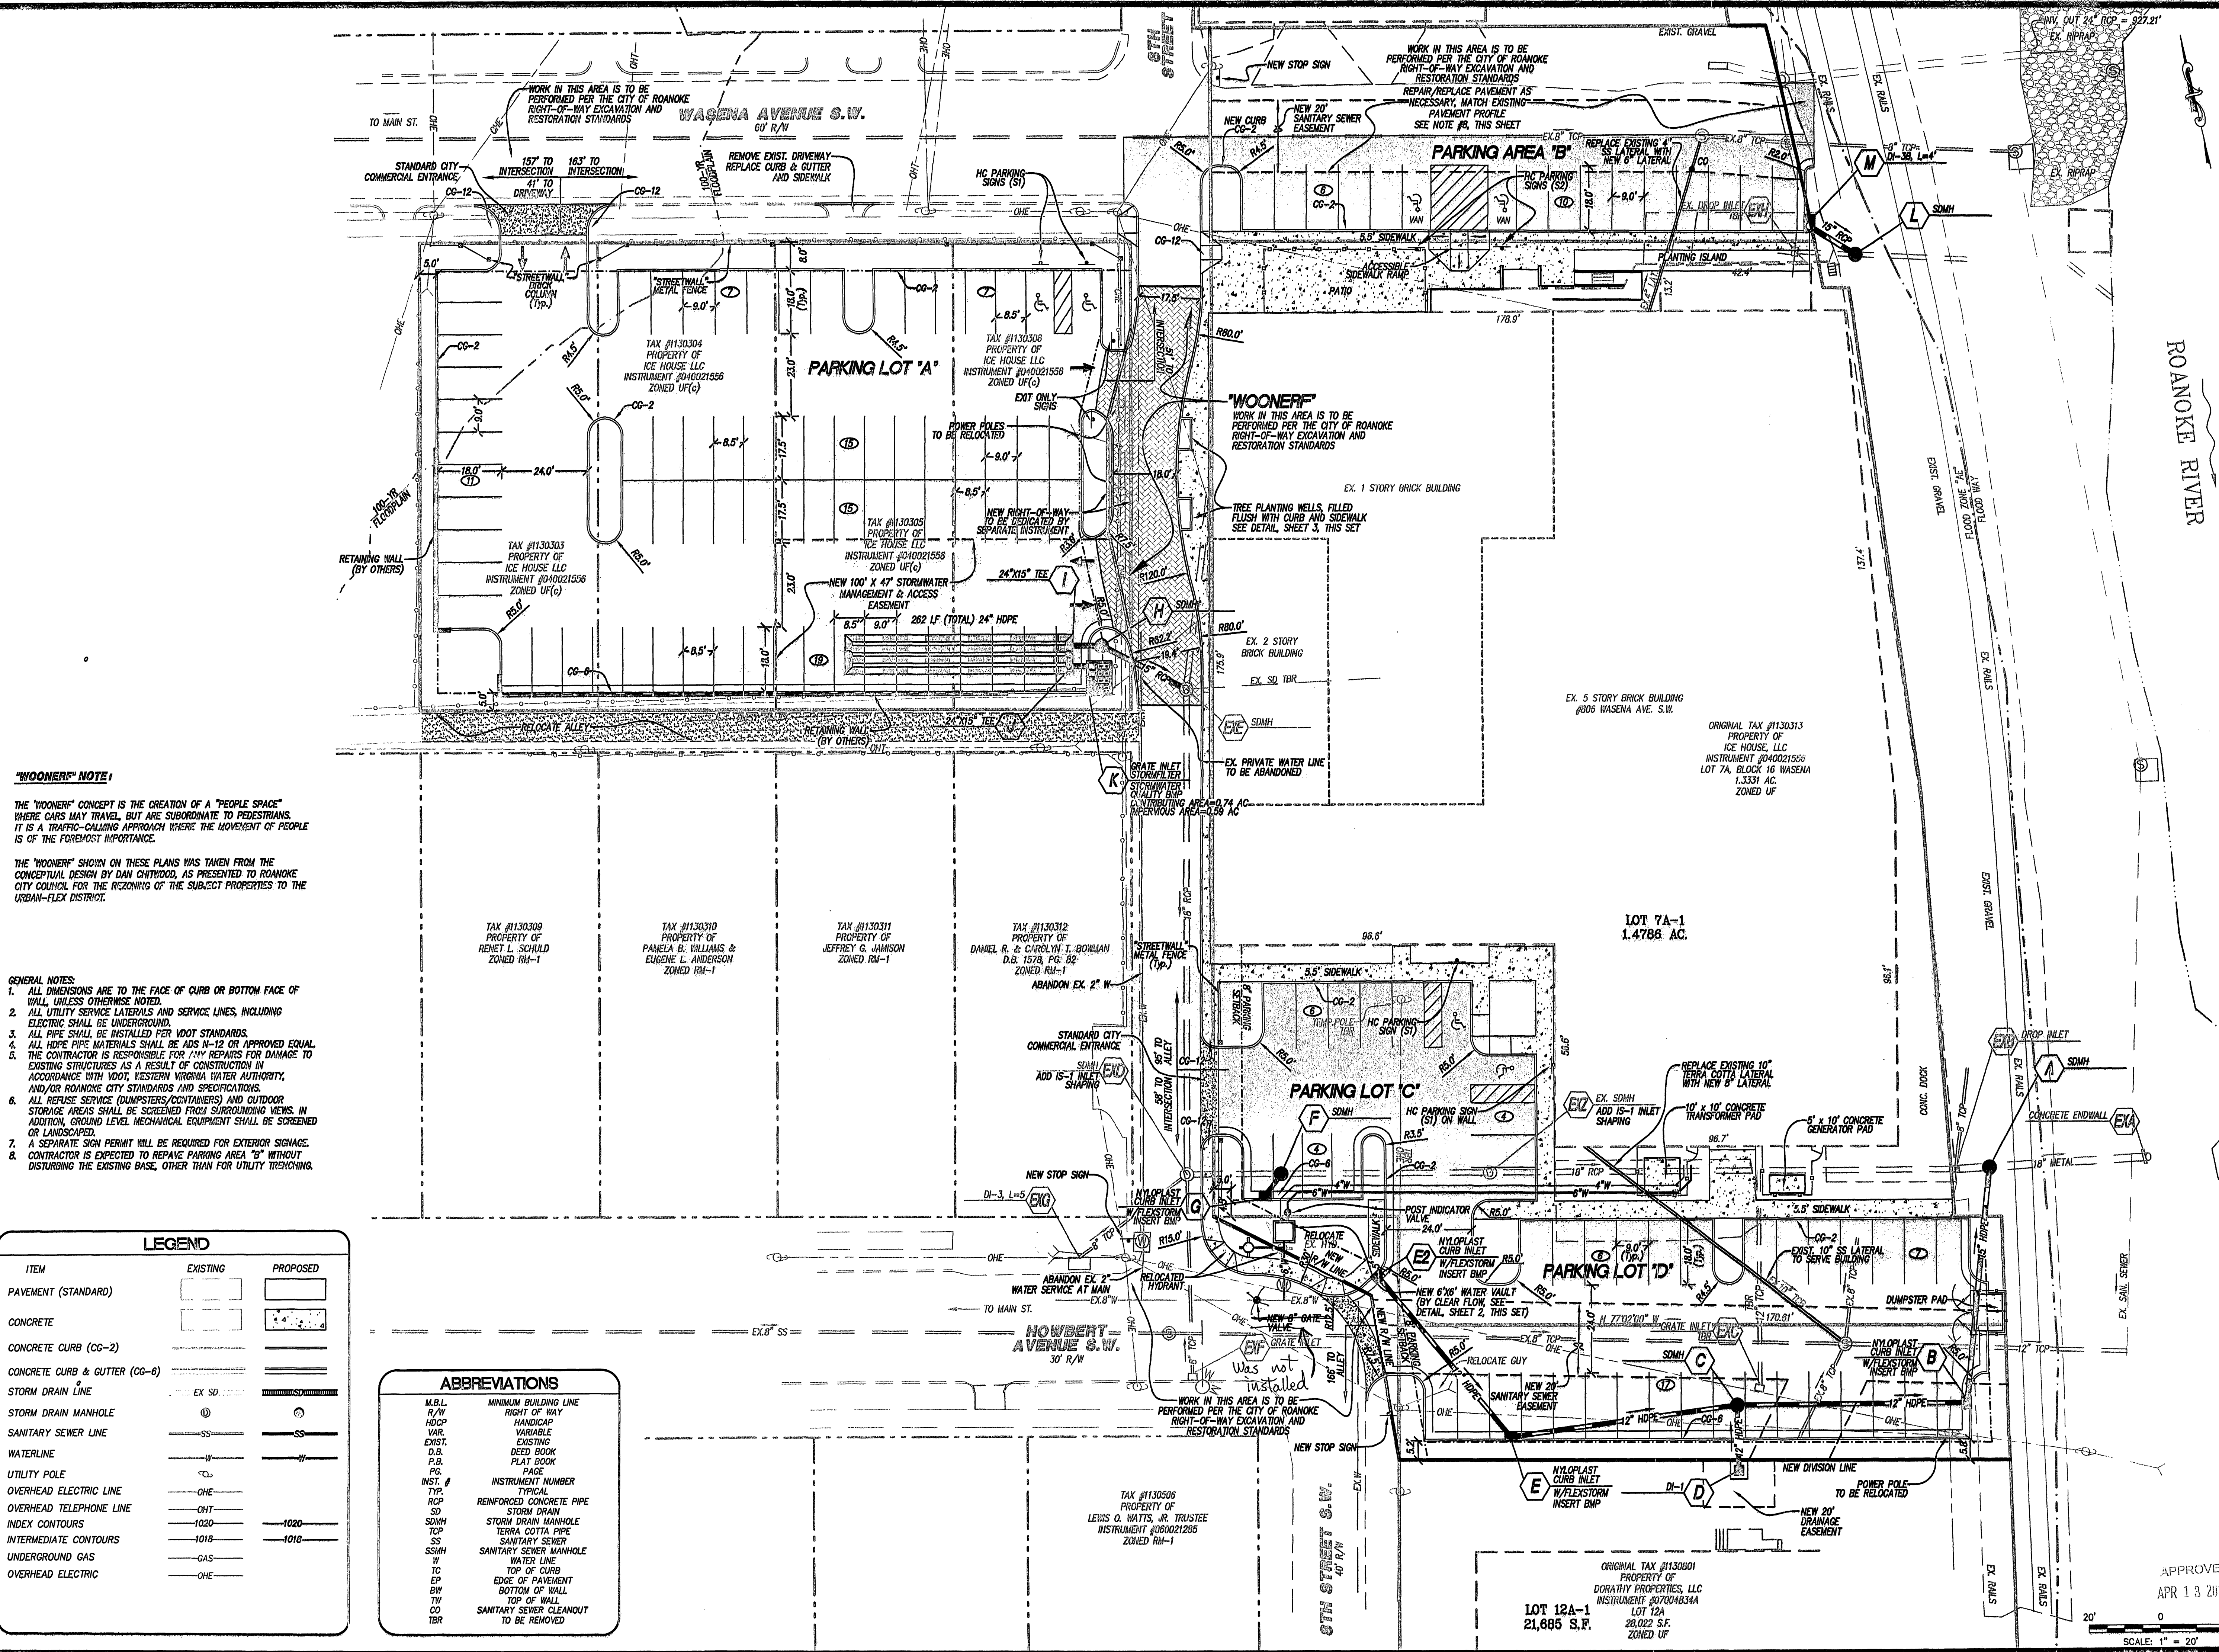

LUMSDEN ASSOCIATES, P.C.
ENGINEERS/SURVEYORS/PLANNERS
ROANOKE, VIRGINIA

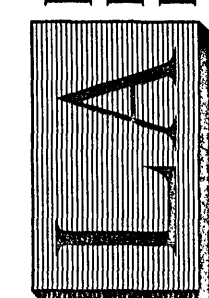

COMMONWEALTH OF VIRGINIA
HOWARD P. BOGGS, II
Lic. No. 000820
LANDSCAPE ARCHITECT
4/3/12

DIMENSIONAL
LAYOUT

DEVELOPMENT PLAN FOR
RIVER HOUSE
PREPARED FOR
CITYSCAPE, LLC
ROANOKE CITY, VIRGINIA

REVISIONS		DESCRIPTION
NO.	DATE	
1		
2		
3		
4		
5		

DATE: April 3, 2012

SCALE: 1" = 20'

COMMISSION NO: 11-230

SHEET 5 OF 10

As-Builts K. Winslow 9.15.12