
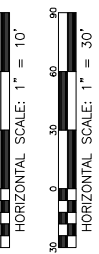


PROPOSED SANITARY PROFILE

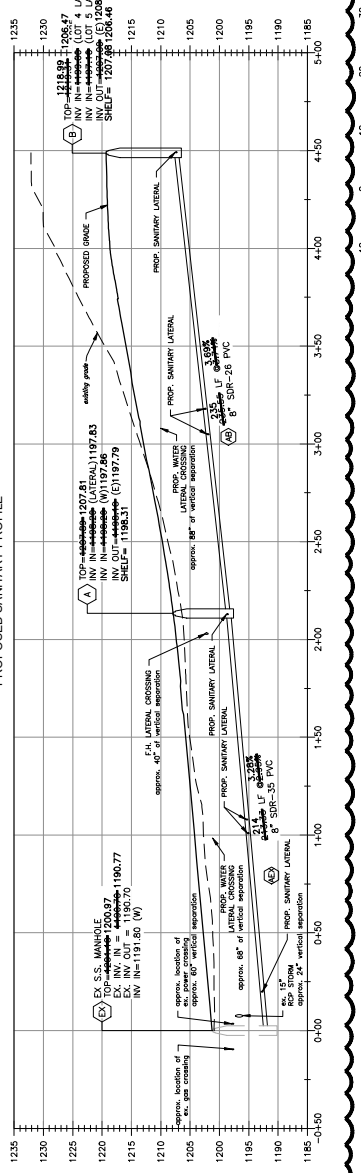

SANITARY SEWER SCHEDULE:

②	PUBLIC S.S. MANHOLE W/ STD LD
	TOP=1218.59 (LOT 4 L&L)
	INV. IN=1206.47 (LATERAL) 1206.47
	INV. OUT=1208.42 (LATERAL) 1208.42
	SHED=1207.28
③	8" OF 8" PVC SRP-35 PVC AT 3.68%
④	PUBLIC S.S. MANHOLE W/ STD LD
	TOP=1207.81 (LOT 4 L&L)
	INV. IN=1197.83 (LATERAL) 1197.83
	INV. OUT=1197.79 (LATERAL) 1197.79
	SHED=1198.31
⑤	8" OF 8" PVC SRP-26 PVC AT 3.28%
⑥	PUBLIC S.S. MANHOLE W/ STD LD
	TOP=1200.97 (LOT 4 L&L)
	INV. IN=1190.70 (LATERAL) 1190.70
	INV. OUT=1190.70

NOTES: TO CONFIRM & COORDINATE ALL BUILDING TIE-IN LOCATIONS WITH M.E.P. AND ARCHITECTURAL TIE-IN LOCATIONS. TO CONFIRM ALL TIE-IN LOCATIONS TO EXISTING LINES PRIOR TO CONSTRUCTION AND NOTIFY THE OWNER OF ANY DISCREPANCIES.

SANITARY SEWER LATERAL TABLE

Project Name:	River Oaks Section 3				
Date:	9/30/2021				
Lot#	Downstream Manhole	Distance	Flow	Min. Elev.	Max. Elev.
1	EVA .001	1354.8	1355.5	1198.5	
2	EVA .001	1354.8	1355.5	1198.5	
3	B	91	1203.6	1202.3	1205.3
4	C	0	1207.0	1207.7	1210.7
5	C	0	1209.0	1209.7	1212.7
6	B	105	1203.1	1203.8	1205.8
7	EVA .001	1354.8	1355.5	1198.5	
8	EVA .008	1359.0	1359.7	1198.9	
9	EVA .20	1352.4	1353.1	1195.1	

AS-BUILT DRAWING NOTE:
AS-BUILT DRAWING FOR SANITARY SEWER AND WATERLINE IMPROVEMENTS ARE FOR AS-BUILT PURPOSES ONLY. NO IMPROVEMENTS OTHER THAN WATER AND SANITARY SEWER STRUCTURES AND WATER AND SANITARY SEWER LINES ON THE SUBJECT PLAN SET UNDERGROUND. THE SUBJECT PLAN SET UNDERGROUND PIPING WAS NOT LOCATED. LOCATION SHOWN IS APPROXIMATE BASED ON SURFACE FEATURES AND INFORMATION PROVIDED BY CONTRACTOR.