

**SITE SUMMARY**

OWNER/DEVELOPER: PULSIN OAKS LAND CO. LLC  
PO BOX 7038  
ROANOKE, VIRGINIA 24018

TAX MAP NUMBER: 056.03-05-10.01-0000  
EXISTING LOT SIZE: 5.407 ACRES  
DEVELOPED AREA: 7.40 ACRES  
ZONING: R-1 LOW DENSITY RESIDENTIAL DISTRICT (ZERO LOT LINE OPTION)

PROPOSED USE: SINGLE FAMILY DWELLING, DETACHED (ZERO LOT LINE OPTION)

MINIMUM LOT SIZE REQUIRED: 0.13 AC/3,760 SQ.FT.  
MINIMUM LOT FRONTAGE REQUIRED: 48' 30" ON OUL-DE-SAC  
LOT FRONTAGE PROVIDED: 60' MINIMUM ON OUL-DE-SAC

WALL MAINTENANCE NOTE: A PERPETUAL 5 FOOT WALL MAINTENANCE EASEMENT SHALL BE PROVIDED ON THE LOT ADJACENT TO THE ZERO LOT LINE EASEMENT. THIS EASEMENT SHALL BE FOR THE SUPPORT OF ANY STRUCTURES OR ANY OTHER IMPROVEMENT WHICH WOULD INFRINGE ON THE USE OF THE EASEMENT. WITH THE EXCEPTION OF THE EASEMENT, THE ADJACENT LOT SHALL BE INCORPORATED INTO EACH DEED TRANSFERRING TITLE TO THE PROPERTY.

SETBACKS: FRONT: 30' FOR R/W NOT WITHIN DEVELOPMENT, OTHERWISE: 24'  
SIDE: 10' WHEN ADJACENT TO PROPERTY NOT WITHIN COMMON DEVELOPMENT OTHERWISE ONE 10' YARD AND ONE ZERO YARD WHEN ADJACENT TO PROPERTY NOT WITHIN COMMON DEVELOPMENT OTHERWISE 20'

REAR: 10' WHEN ADJACENT TO PROPERTY NOT WITHIN COMMON DEVELOPMENT OTHERWISE 20'

MAXIMUM BUILDING HEIGHT: 45'  
MAXIMUM LOT COVERAGE: 50%  
MAXIMUM BUILDING COVERAGE: 40%  
WATER: PUBLIC  
SEWER: PUBLIC  
ROADWAY: PUBLIC


| FOXFIELD LANE C.L. - LINE TABLE |         |               |  |
|---------------------------------|---------|---------------|--|
| Line #                          | Length  | Direction     |  |
| L1                              | 496.03' | S71° 04' 43"W |  |
| L2                              | 46.84'  | N64° 39' 50"W |  |

| FOXFIELD LANE C.L. - CURVE TABLE |         |               |              |
|----------------------------------|---------|---------------|--------------|
| CURVE #                          | RADIUS  | CHORD BEARING | CHORD LENGTH |
| C1                               | 110.00' | N68° 47' 34"W | 82.87'       |
|                                  |         |               | 44°15'27"    |

**VOOT NOTES:**  
COMPANION TESTS REQUIRED EVERY 500' FOR THE INSPECTION OF THE VOOT. THE VOOT SHALL BE RIGHT-OF-WAY OR PROPOSED RIGHT-OF-WAY.  
2. G.C. SHALL REFER TO THE VOOT LAND DEVELOPMENT INSPECTION AND DOCUMENTATION MANUAL, APPENDICES A AND B, FOR THE VOOT INSPECTION AND DOCUMENTATION PRE-CONSTRUCTION THROUGH VOOT STREET ACCEPTANCE.

**ASSUMED INTERVIEWS AREA:**  
LOTS 1-12: 3,500 SF PER LOT  
LOTS 13-21: 2,500 SF PER LOT

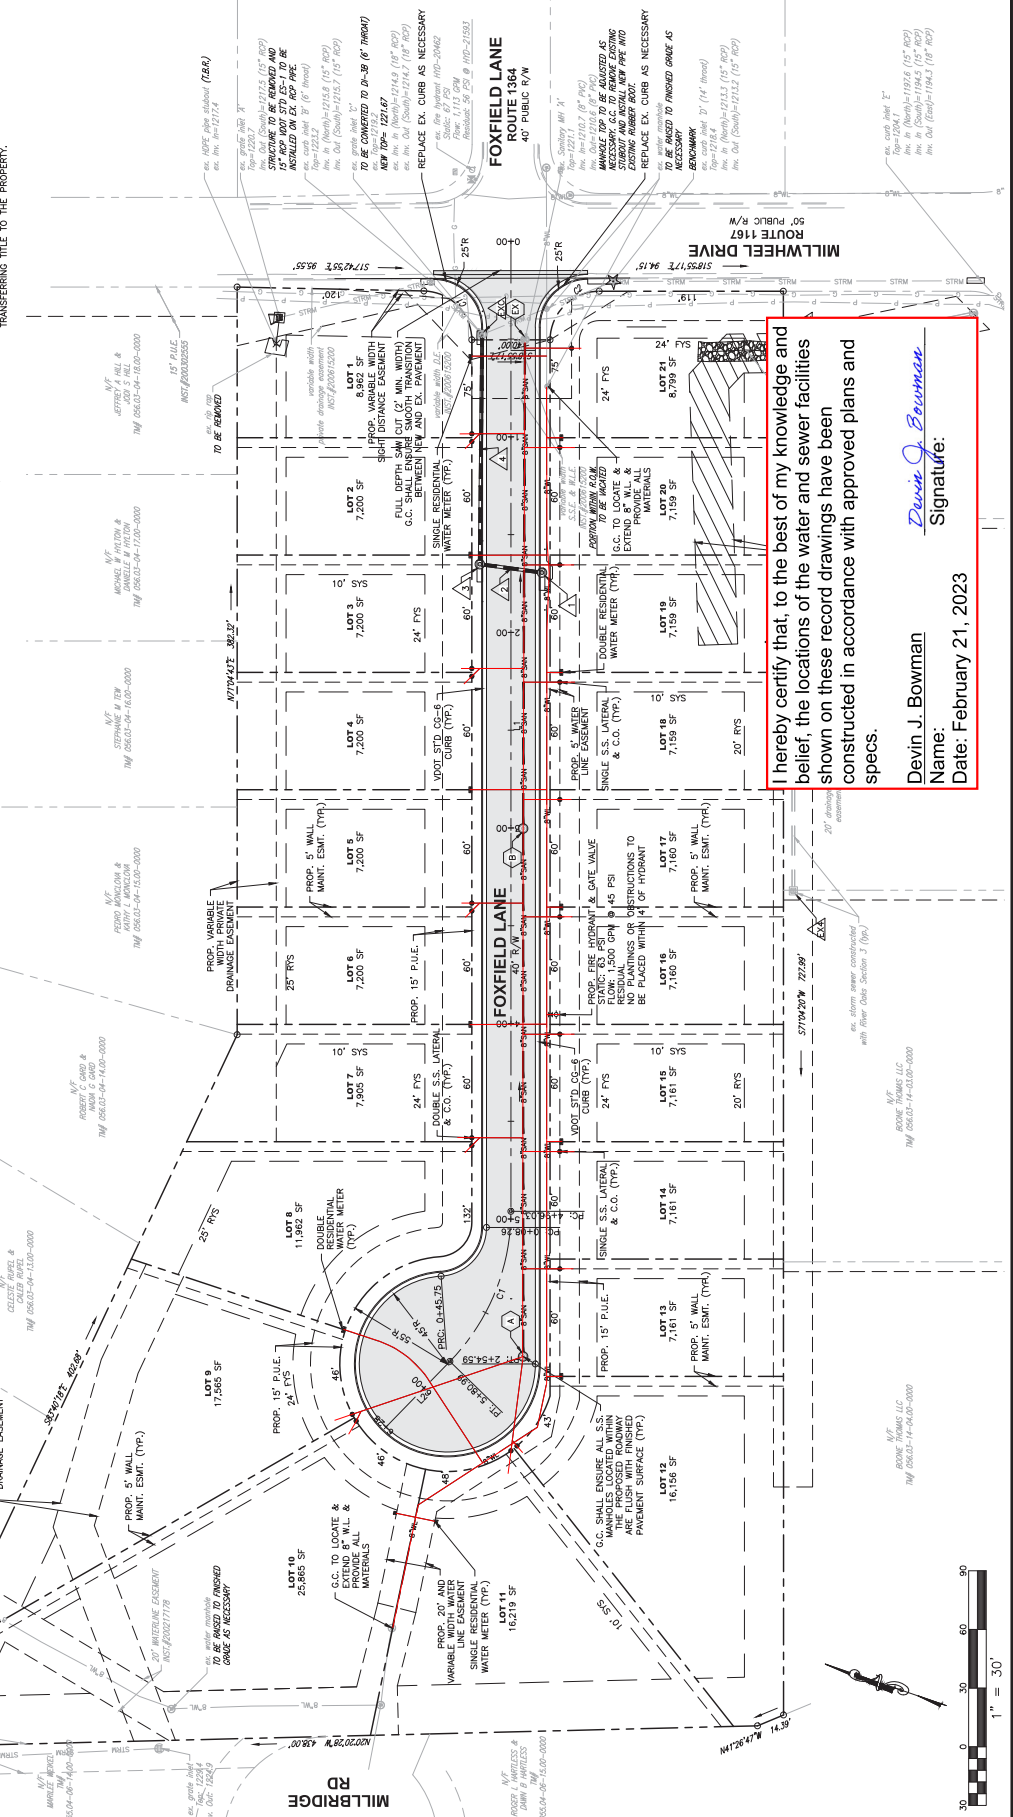

I hereby certify that, to the best of my knowledge and belief, the locations of the water and sewer facilities shown on these record drawings have been constructed in accordance with approved plans and specs.

Devin J. Bowman  
Name:  
Signature:  
Date: February 21, 2023