


SANITARY SEWER SCHEDULE:


- ① 8" PVC S.S. MANHOLE W/ STD LG
TOP= 1223.59
INVERT= 1223.59
MANHOLE= 1223.59
INVERT= 1223.59
MANHOLE= 1223.59
INVERT= 1223.59
- ② 24" LF OF 8" PVC SBR-26 PVC AT 2.11%
TOP= 1223.59
INVERT= 1223.59
MANHOLE= 1223.59
INVERT= 1223.59
- ③ 24" LF OF 8" PVC SBR-26 PVC AT 2.11%
TOP= 1223.59
INVERT= 1223.59
MANHOLE= 1223.59
INVERT= 1223.59
- ④ 24" LF OF 8" PVC SBR-26 PVC AT 2.11%
TOP= 1223.59
INVERT= 1223.59
MANHOLE= 1223.59
INVERT= 1223.59

NOTE: TO CONFIRM & COORDINATE ALL BUILDING
DRAWINGS PRIOR TO CONSTRUCTION OF LATERAL
PIPING. THE CONTRACTOR SHALL BE RESPONSIBLE FOR
OBTAINING ALL NECESSARY PERMITS AND NOTIFICATION
AND SHALL MAINTAIN RECORD OF ALL CHANGES
TO THE ORIGINAL DRAWINGS. THE CONTRACTOR SHALL
BE RESPONSIBLE FOR OBTAINING ALL NECESSARY
PERMITS AND NOTIFICATION AND SHALL MAINTAIN
RECORD OF ALL CHANGES TO THE ORIGINAL
DRAWINGS.

PROPOSED SANITARY PROFILE

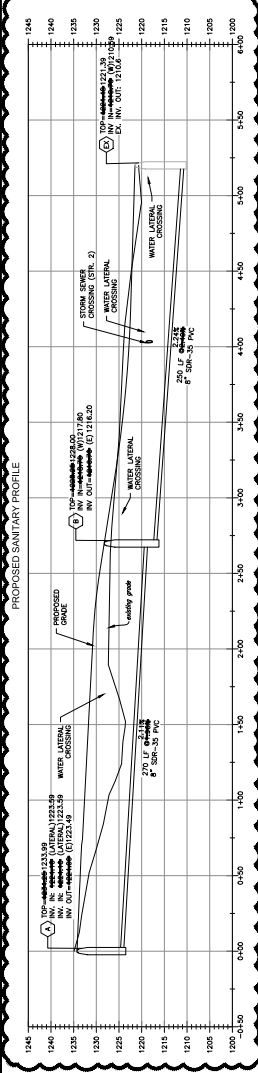

PROPOSED WATER LINE PROFILE

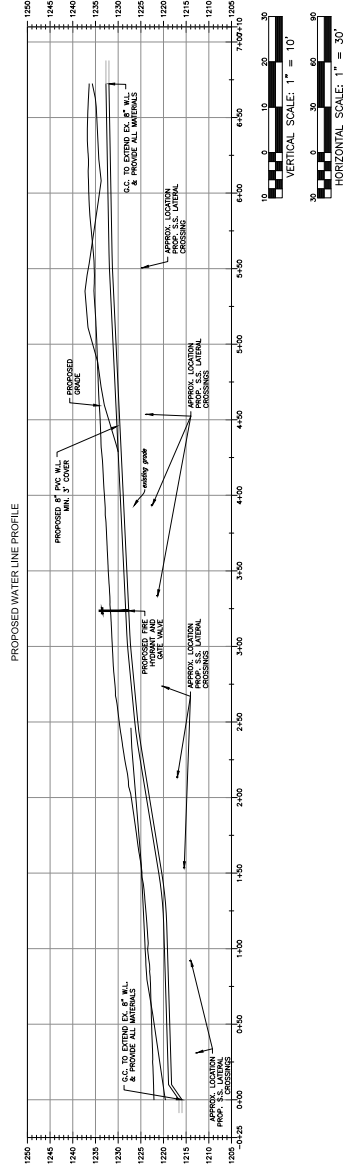

AS-BUILT DRAWING NOTE:
AS-BUILT DRAWING FOR SANITARY SEWER AND
WATERLINE IMPROVEMENTS ARE FOR AS-BUILT
PURPOSES ONLY. NO IMPROVEMENTS, OTHER
THAN THOSE SHOWN, SHALL BE MADE WITHOUT THE
APPROVAL OF THE ENGINEER. THE CONTRACTOR
SHALL BE RESPONSIBLE FOR OBTAINING ALL
NECESSARY PERMITS AND NOTIFICATION AND
SHALL MAINTAIN RECORD OF ALL CHANGES
TO THE ORIGINAL DRAWINGS. THE CONTRACTOR
SHALL BE RESPONSIBLE FOR OBTAINING ALL
NECESSARY PERMITS AND NOTIFICATION AND
SHALL MAINTAIN RECORD OF ALL CHANGES
TO THE ORIGINAL DRAWINGS.



WATER & SANITARY SEWER AS-BUILT PROFILE
RIVER OAKS SECTION 4

WATER & SANITARY SEWER AS-BUILT PROFILE
RIVER OAKS SECTION 4

AS-BUILT
PROJECT NO. 1400000000